


0376 - 158

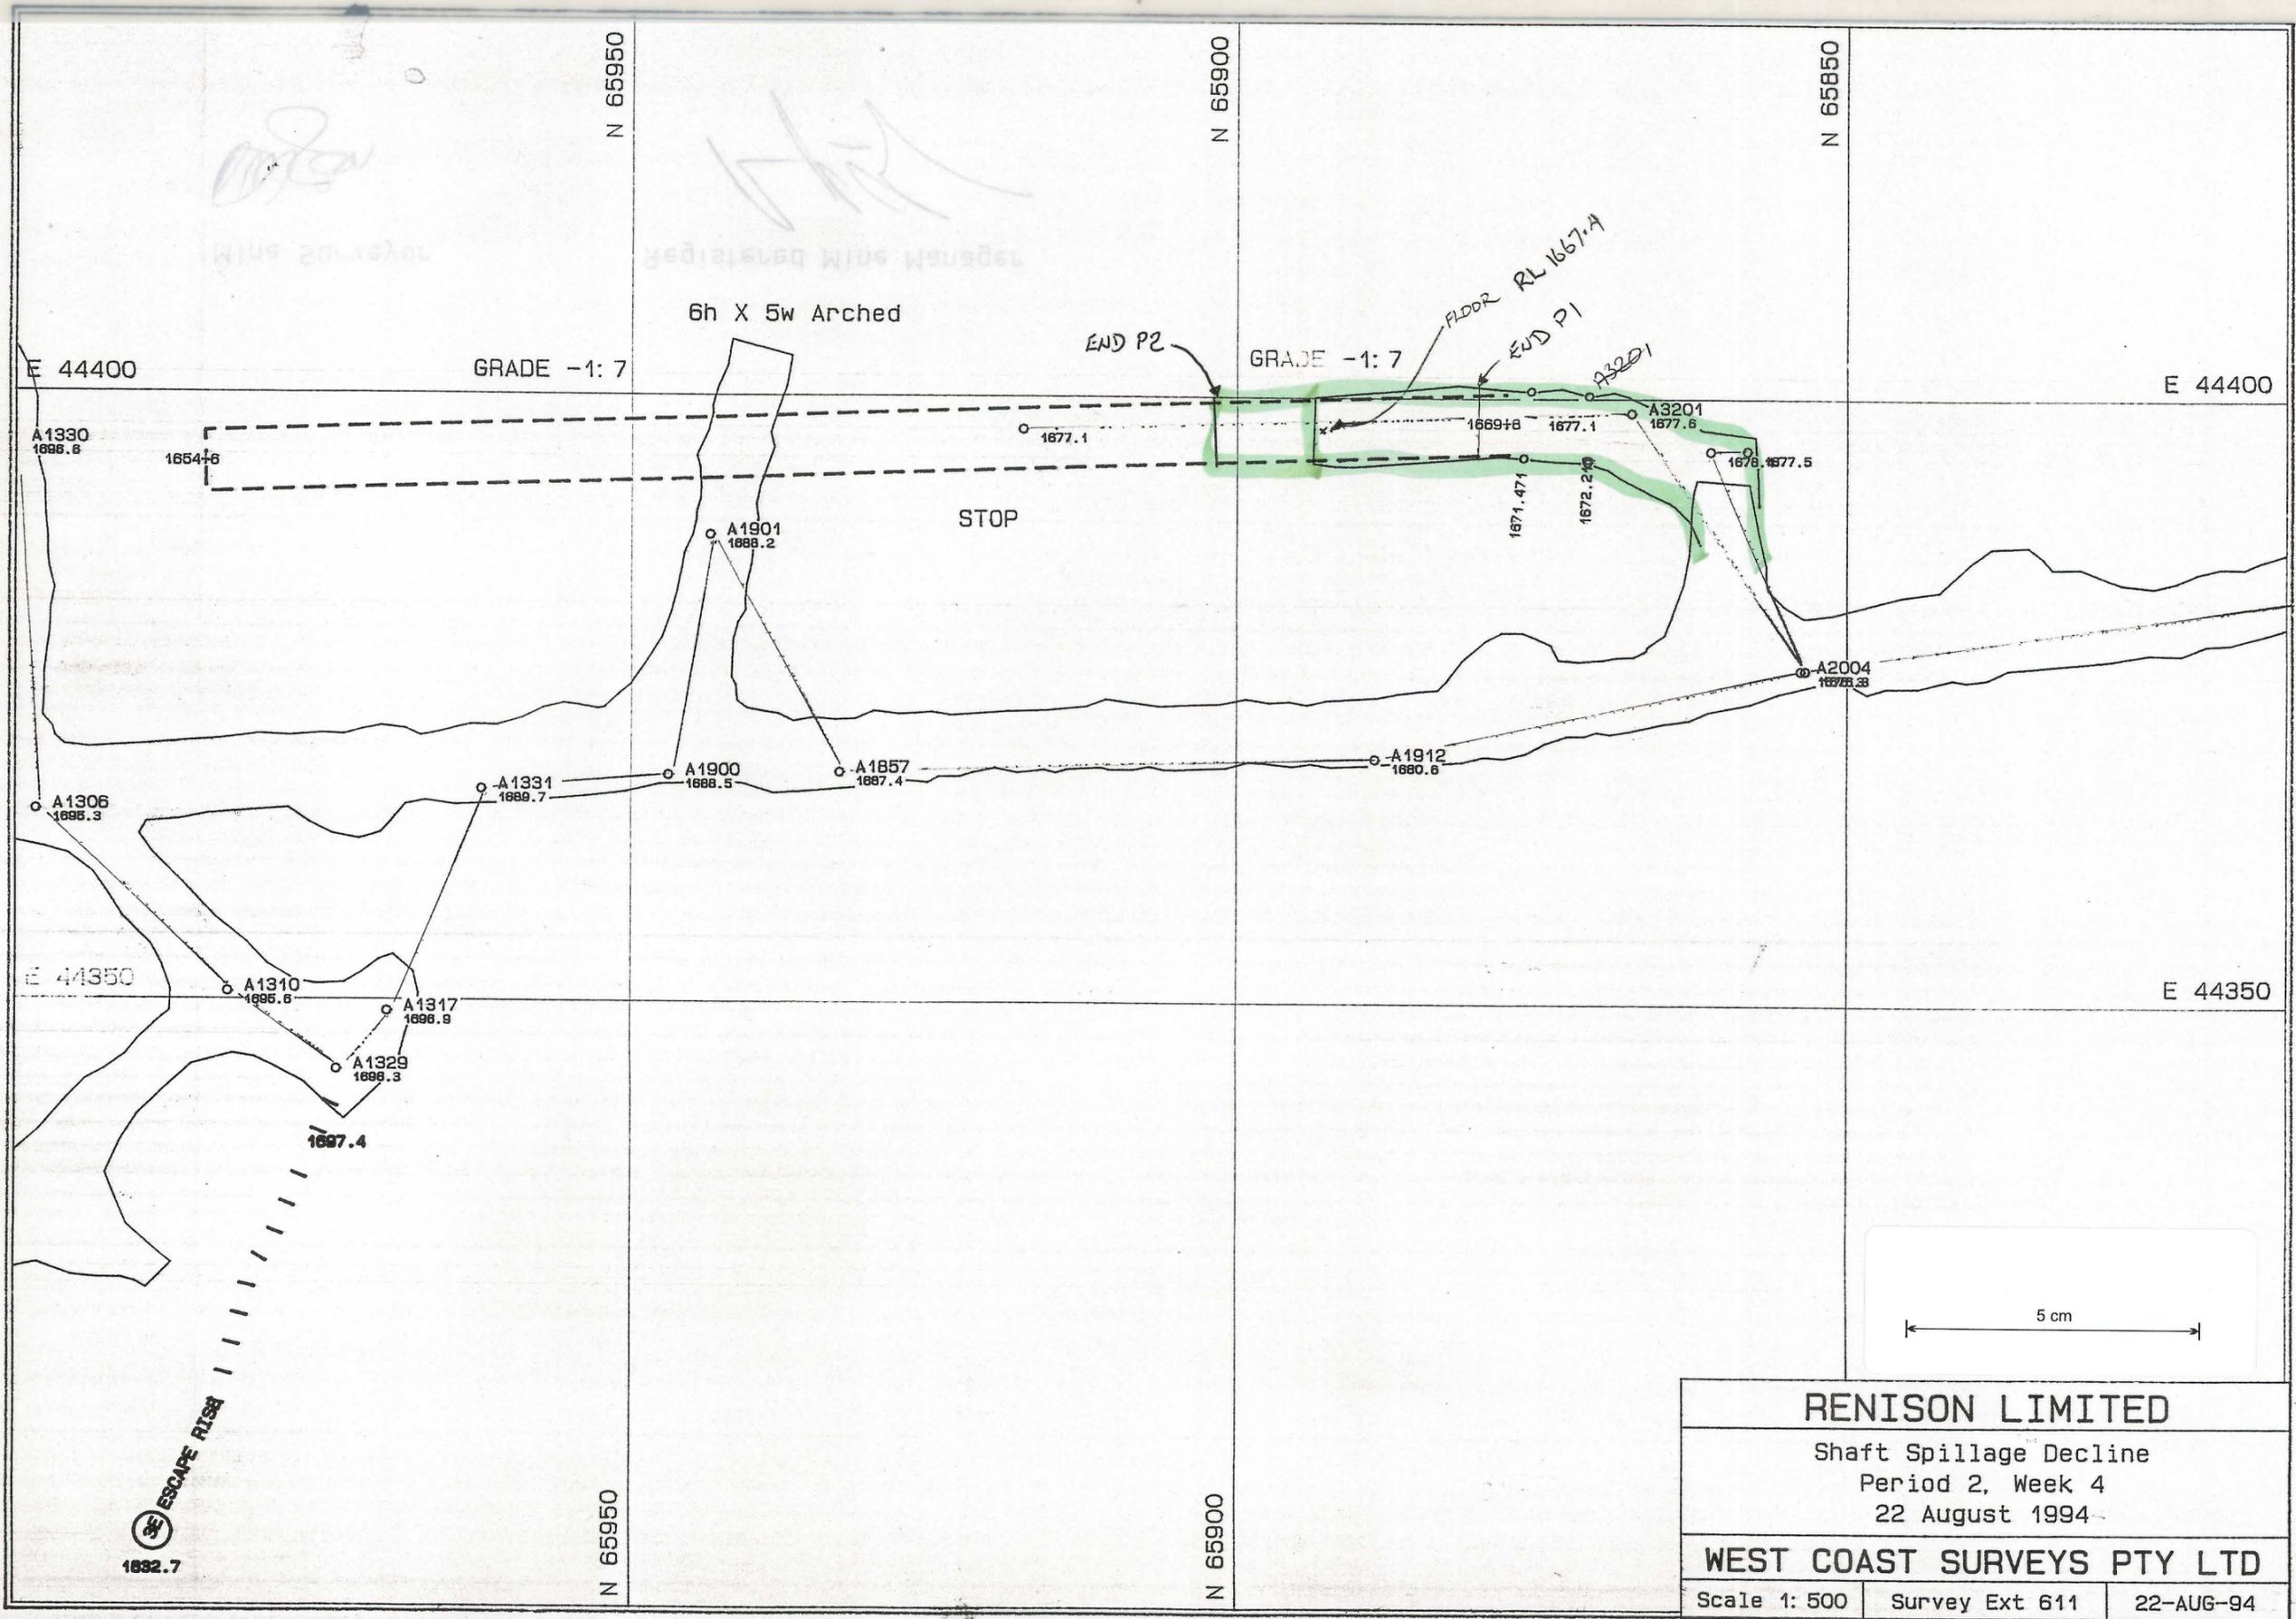

RENISON LIMITED

Shaft Spillage Decline
Period 2, Week 4
22 August 1994

WEST COAST SURVEYS PTY LTD

Scale 1: 500 Survey Ext 611 22-AUG-94