


0376-159

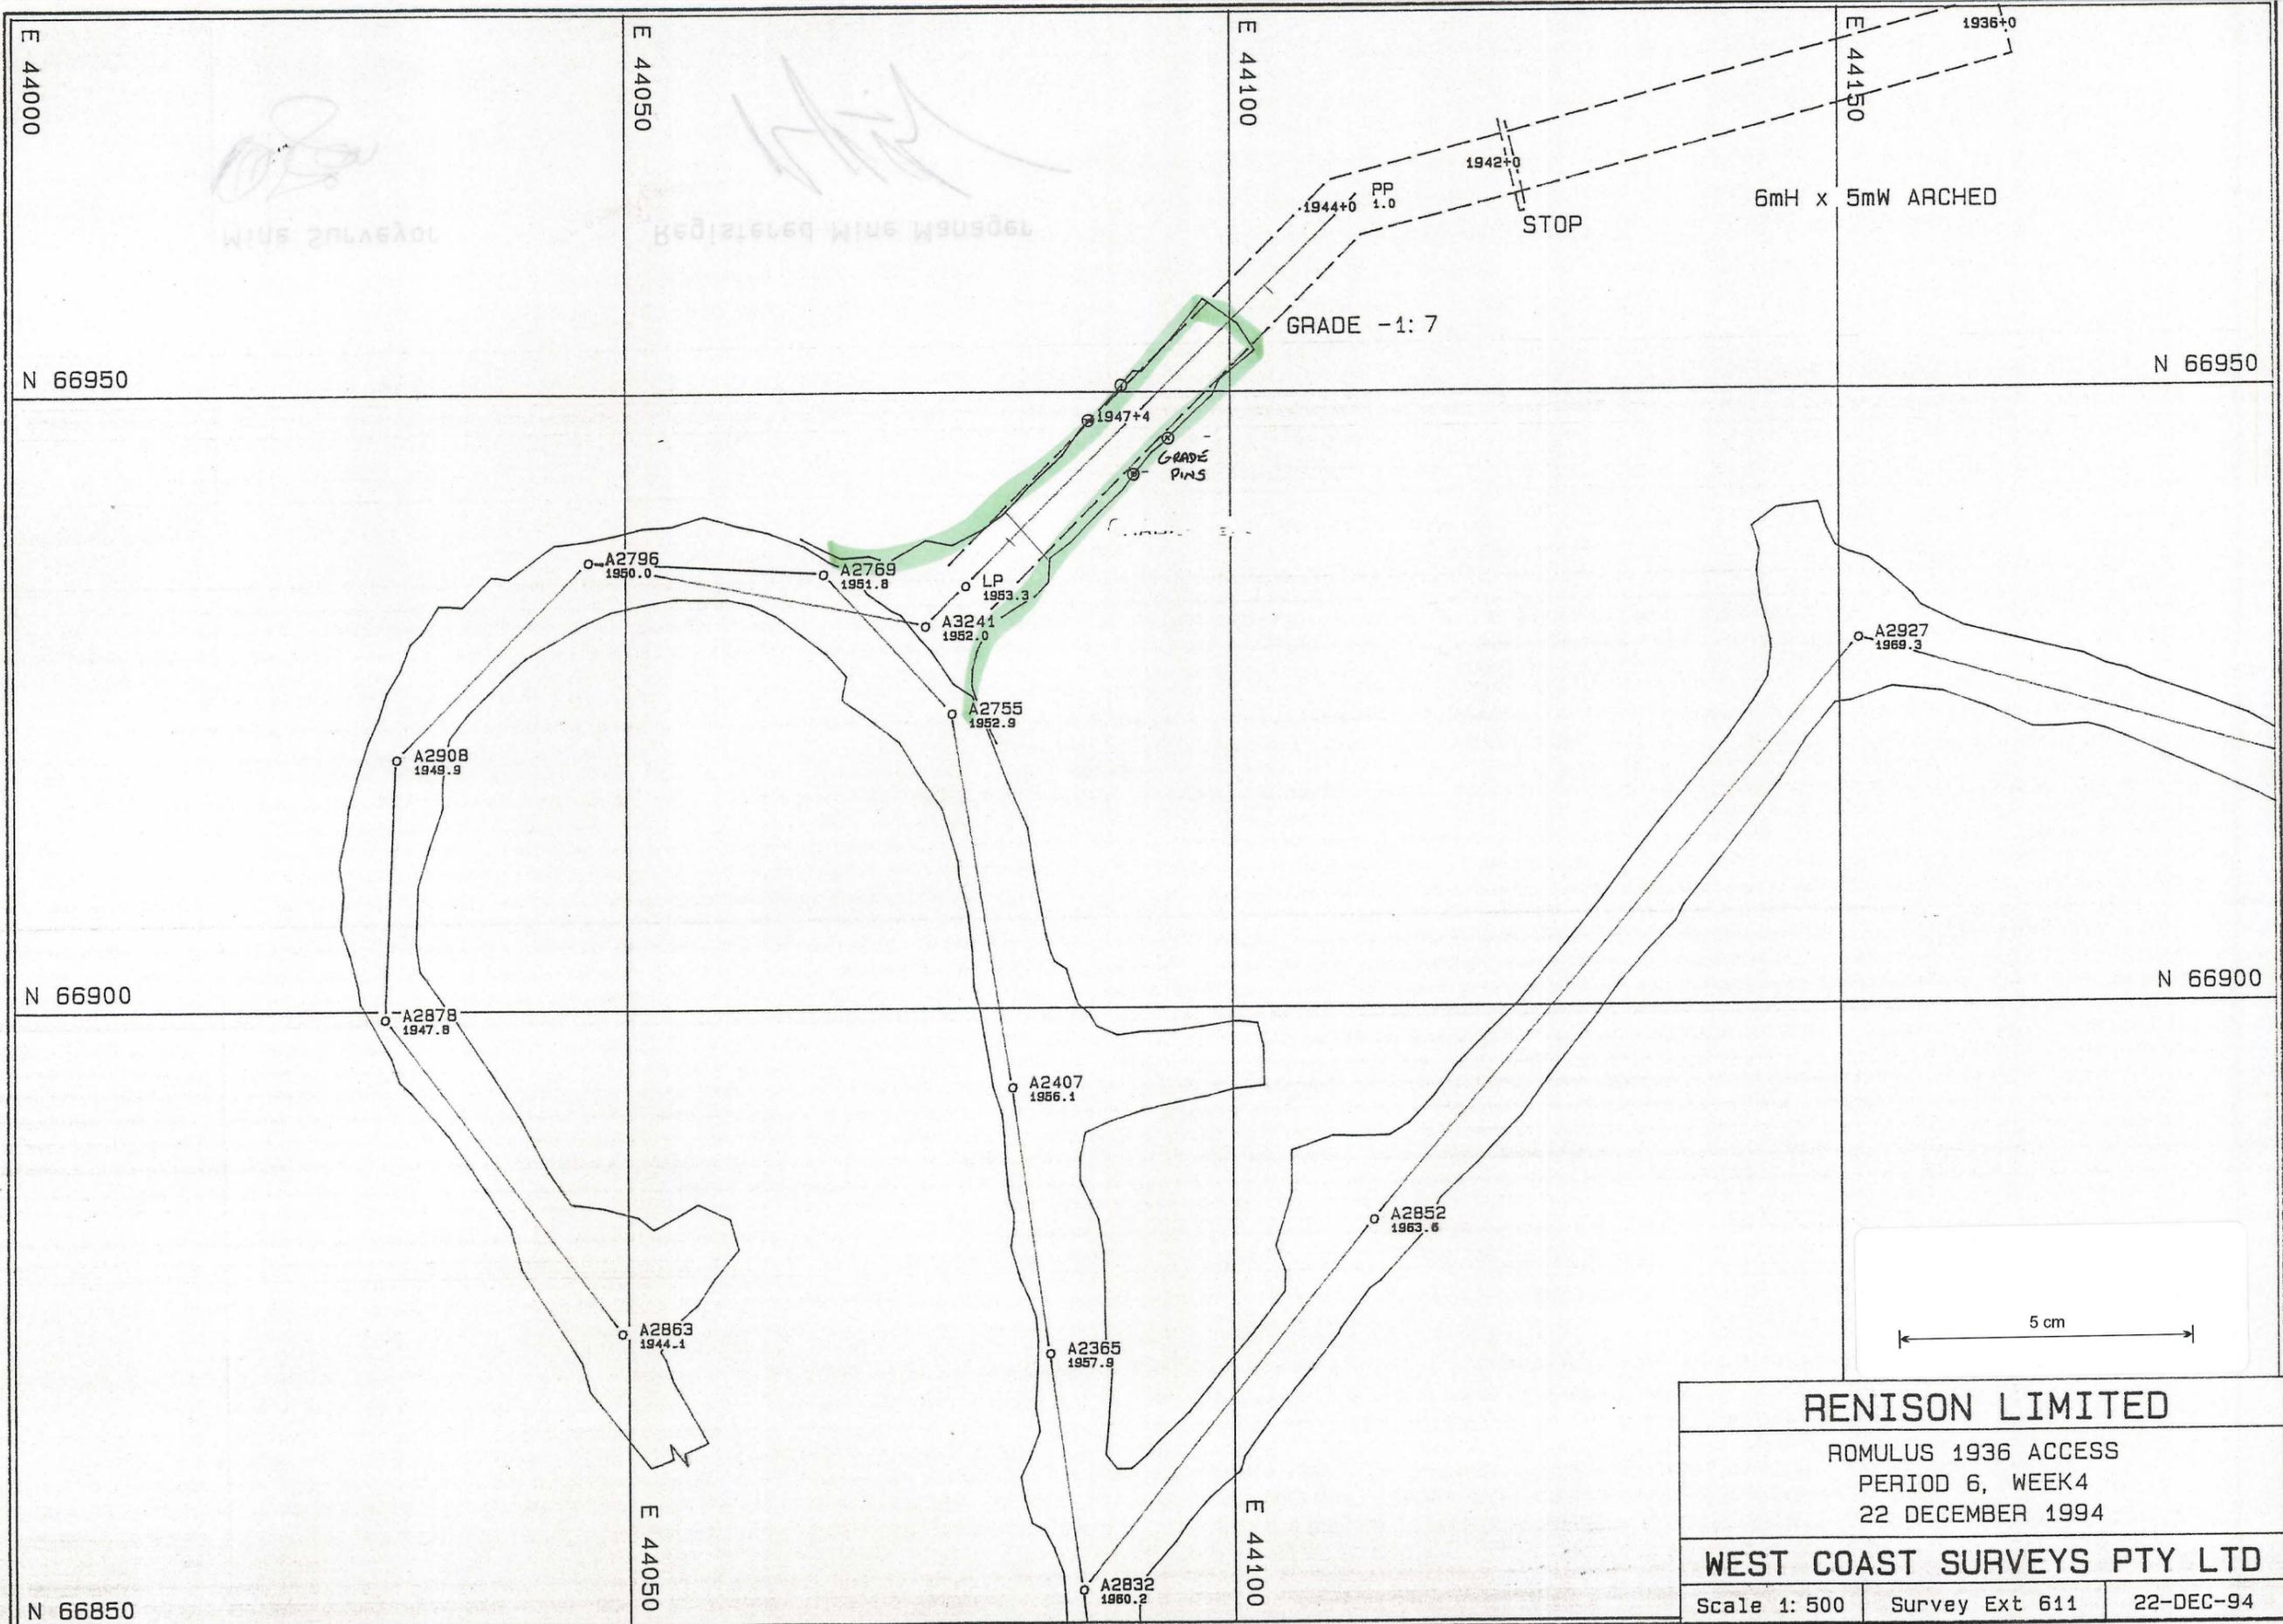

RENISON LIMITED		
ROMULUS 1936 ACCESS PERIOD 6, WEEK 4 22 DECEMBER 1994		
WEST COAST SURVEYS PTY LTD		
Scale 1: 500	Survey Ext 611	22-DEC-94