


0376-162

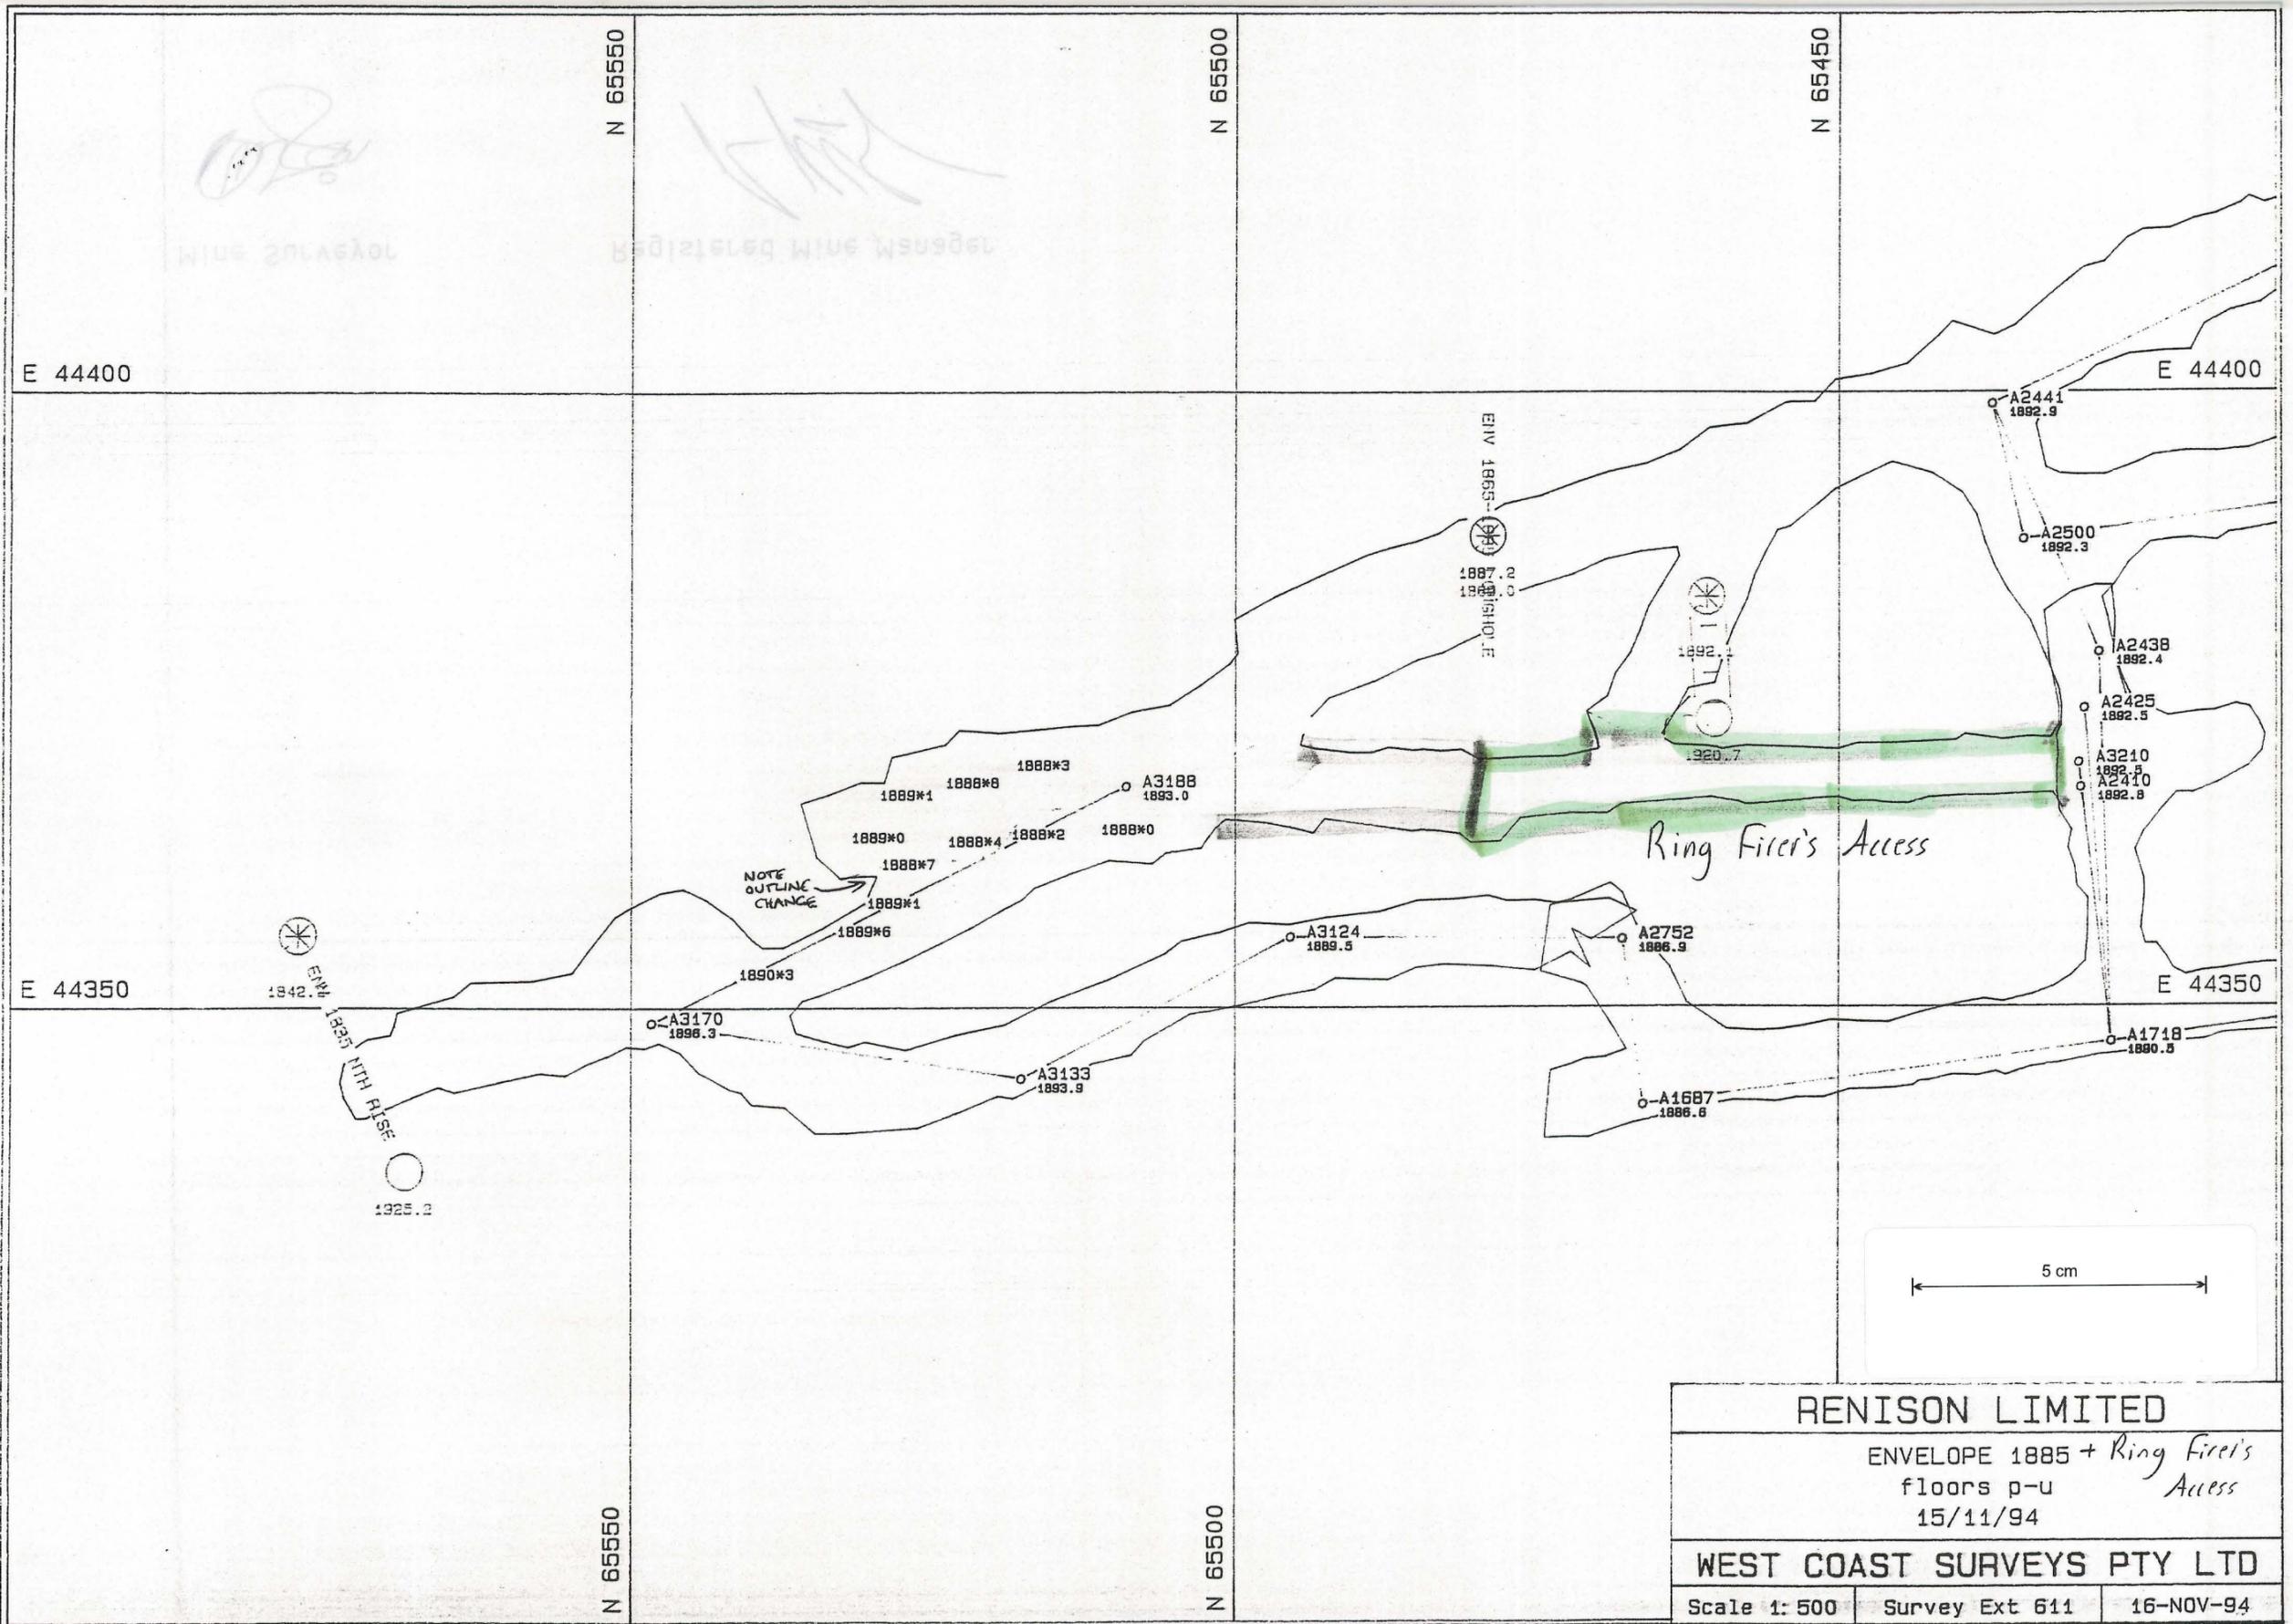

RENISON LIMITED  
 ENVELOPE 1885 + *Ring Fier's*  
 Access  
 floors p-u  
 15/11/94

WEST COAST SURVEYS PTY LTD  
 Scale 1: 500 | Survey Ext 611 | 16-NOV-94

ENVEL.C. PF