


0376-164

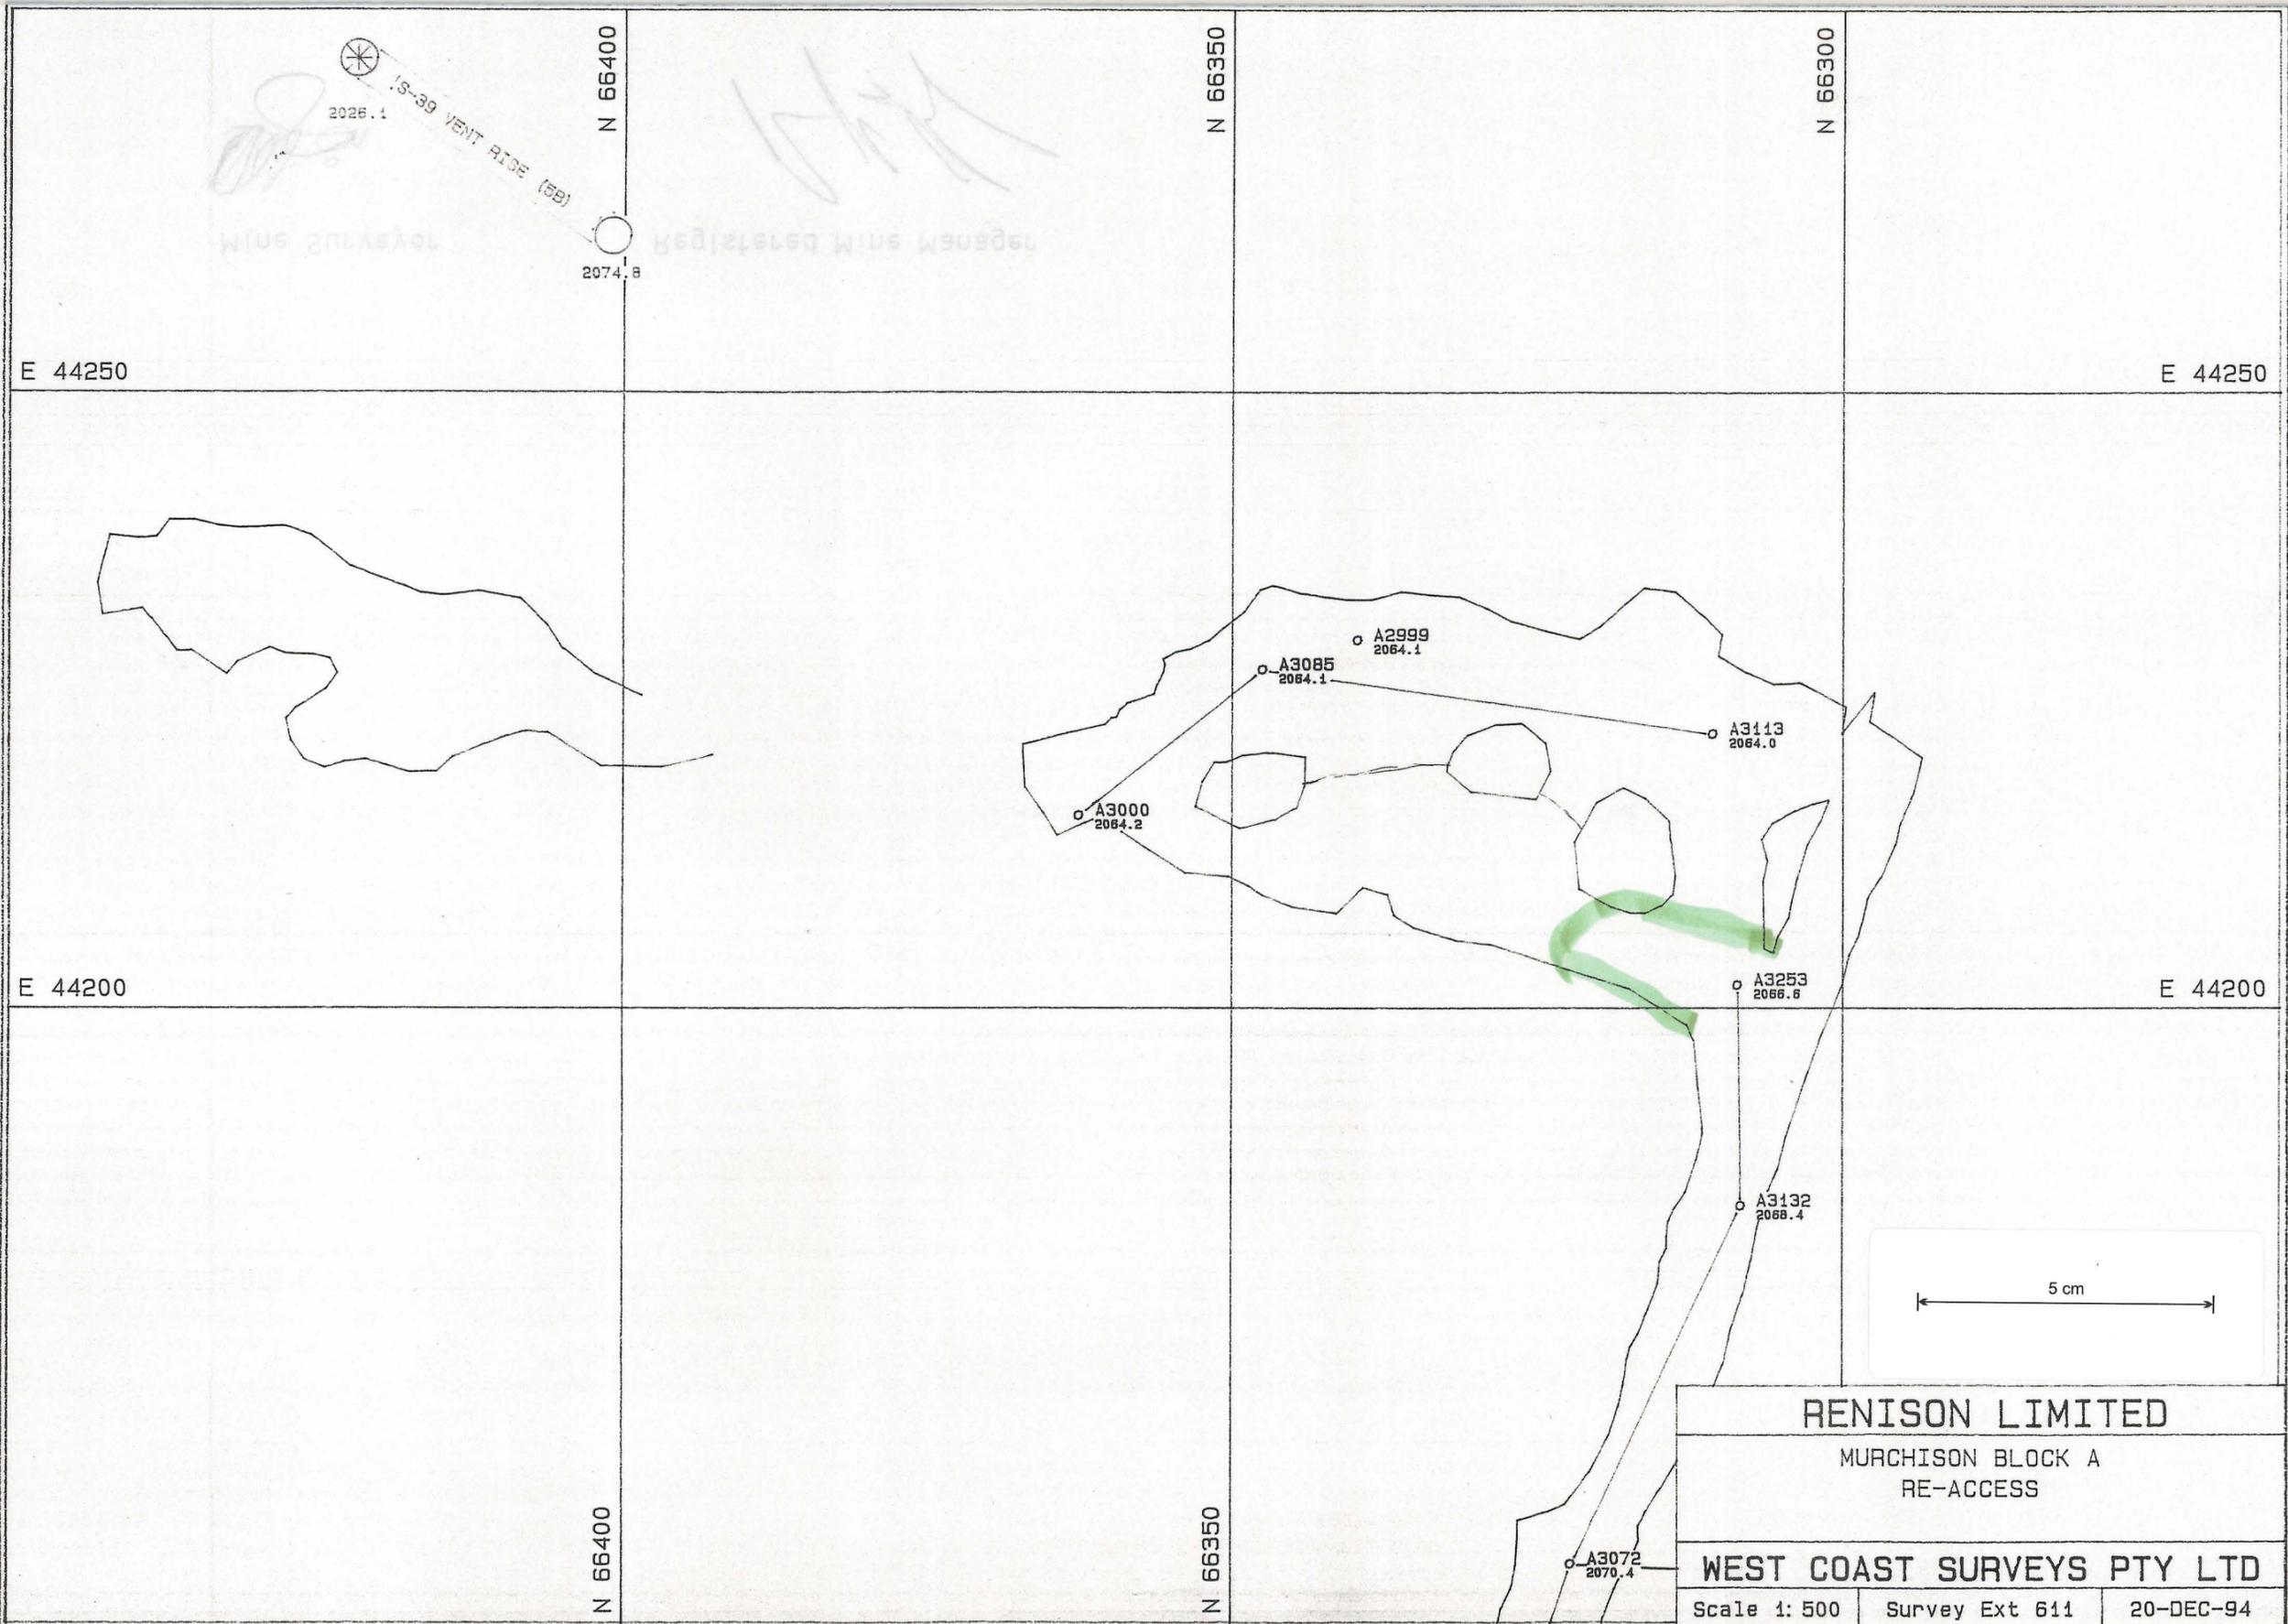

MURCHD.PF