


0376-166

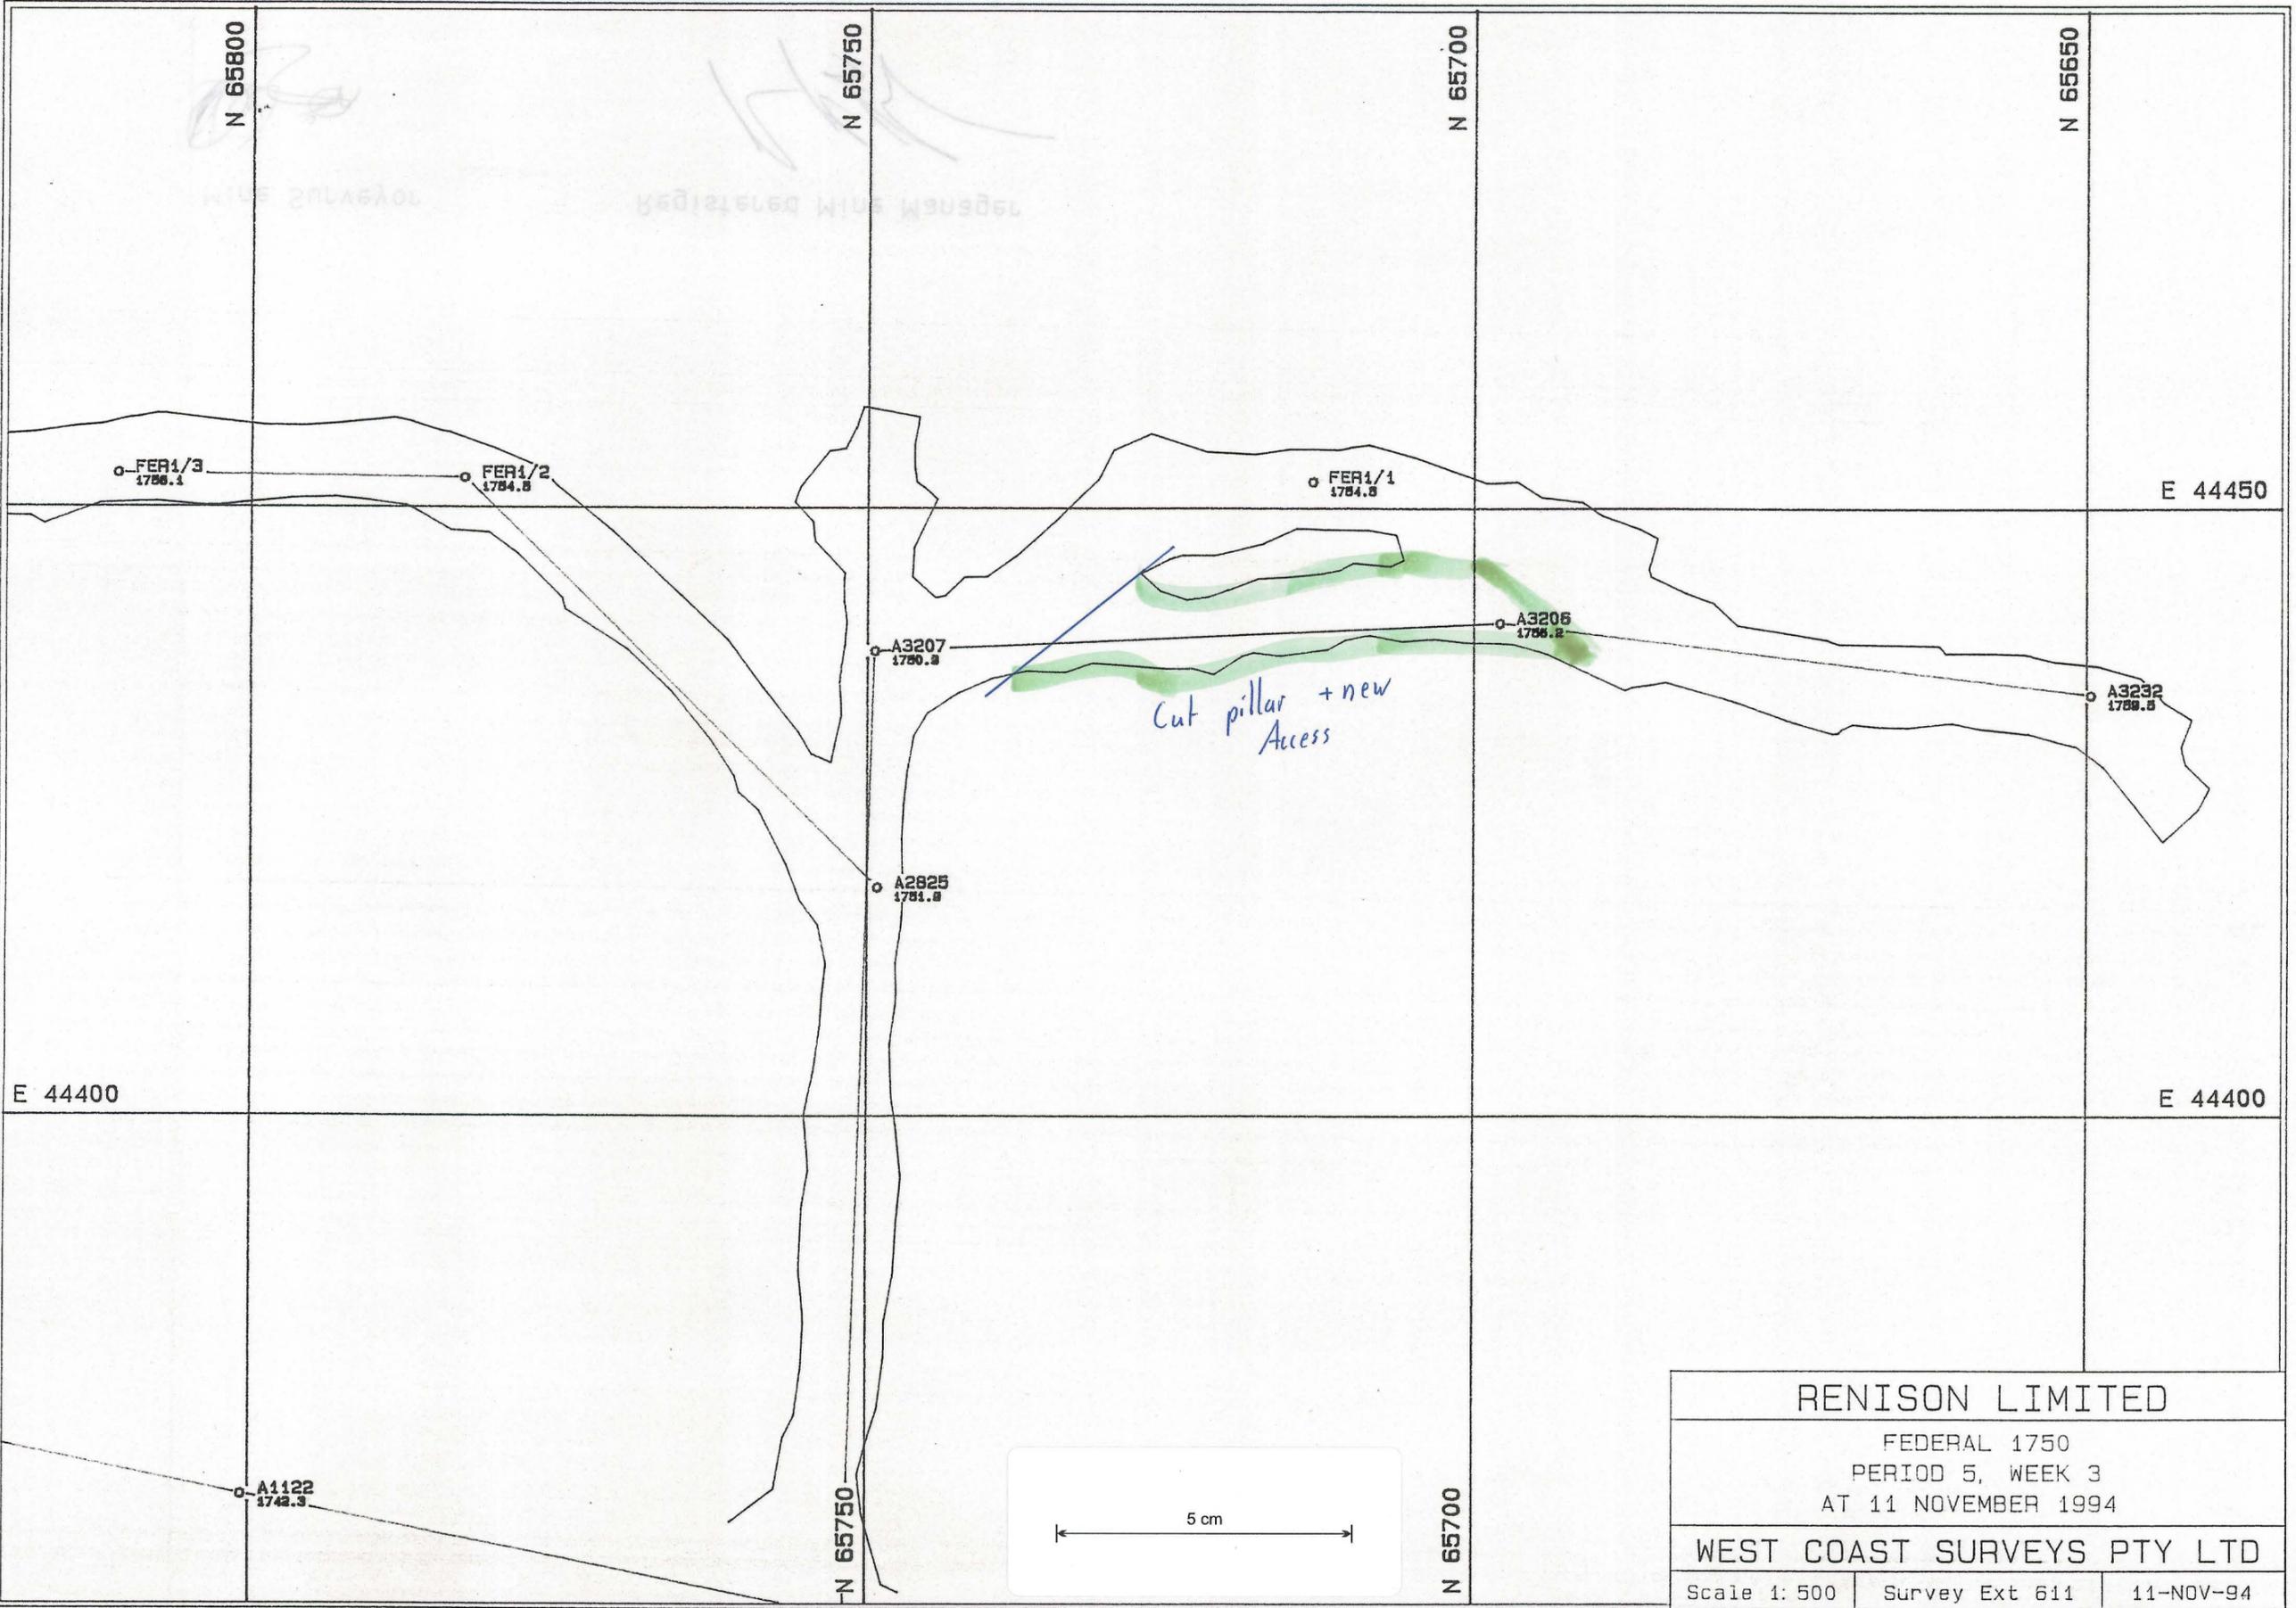

RENISON LIMITED

FEDERAL 1750  
PERIOD 5, WEEK 3  
AT 11 NOVEMBER 1994

WEST COAST SURVEYS PTY LTD

Scale 1: 500 | Survey Ext 611 | 11-NOV-94

FEDERA.PF