


0376-167

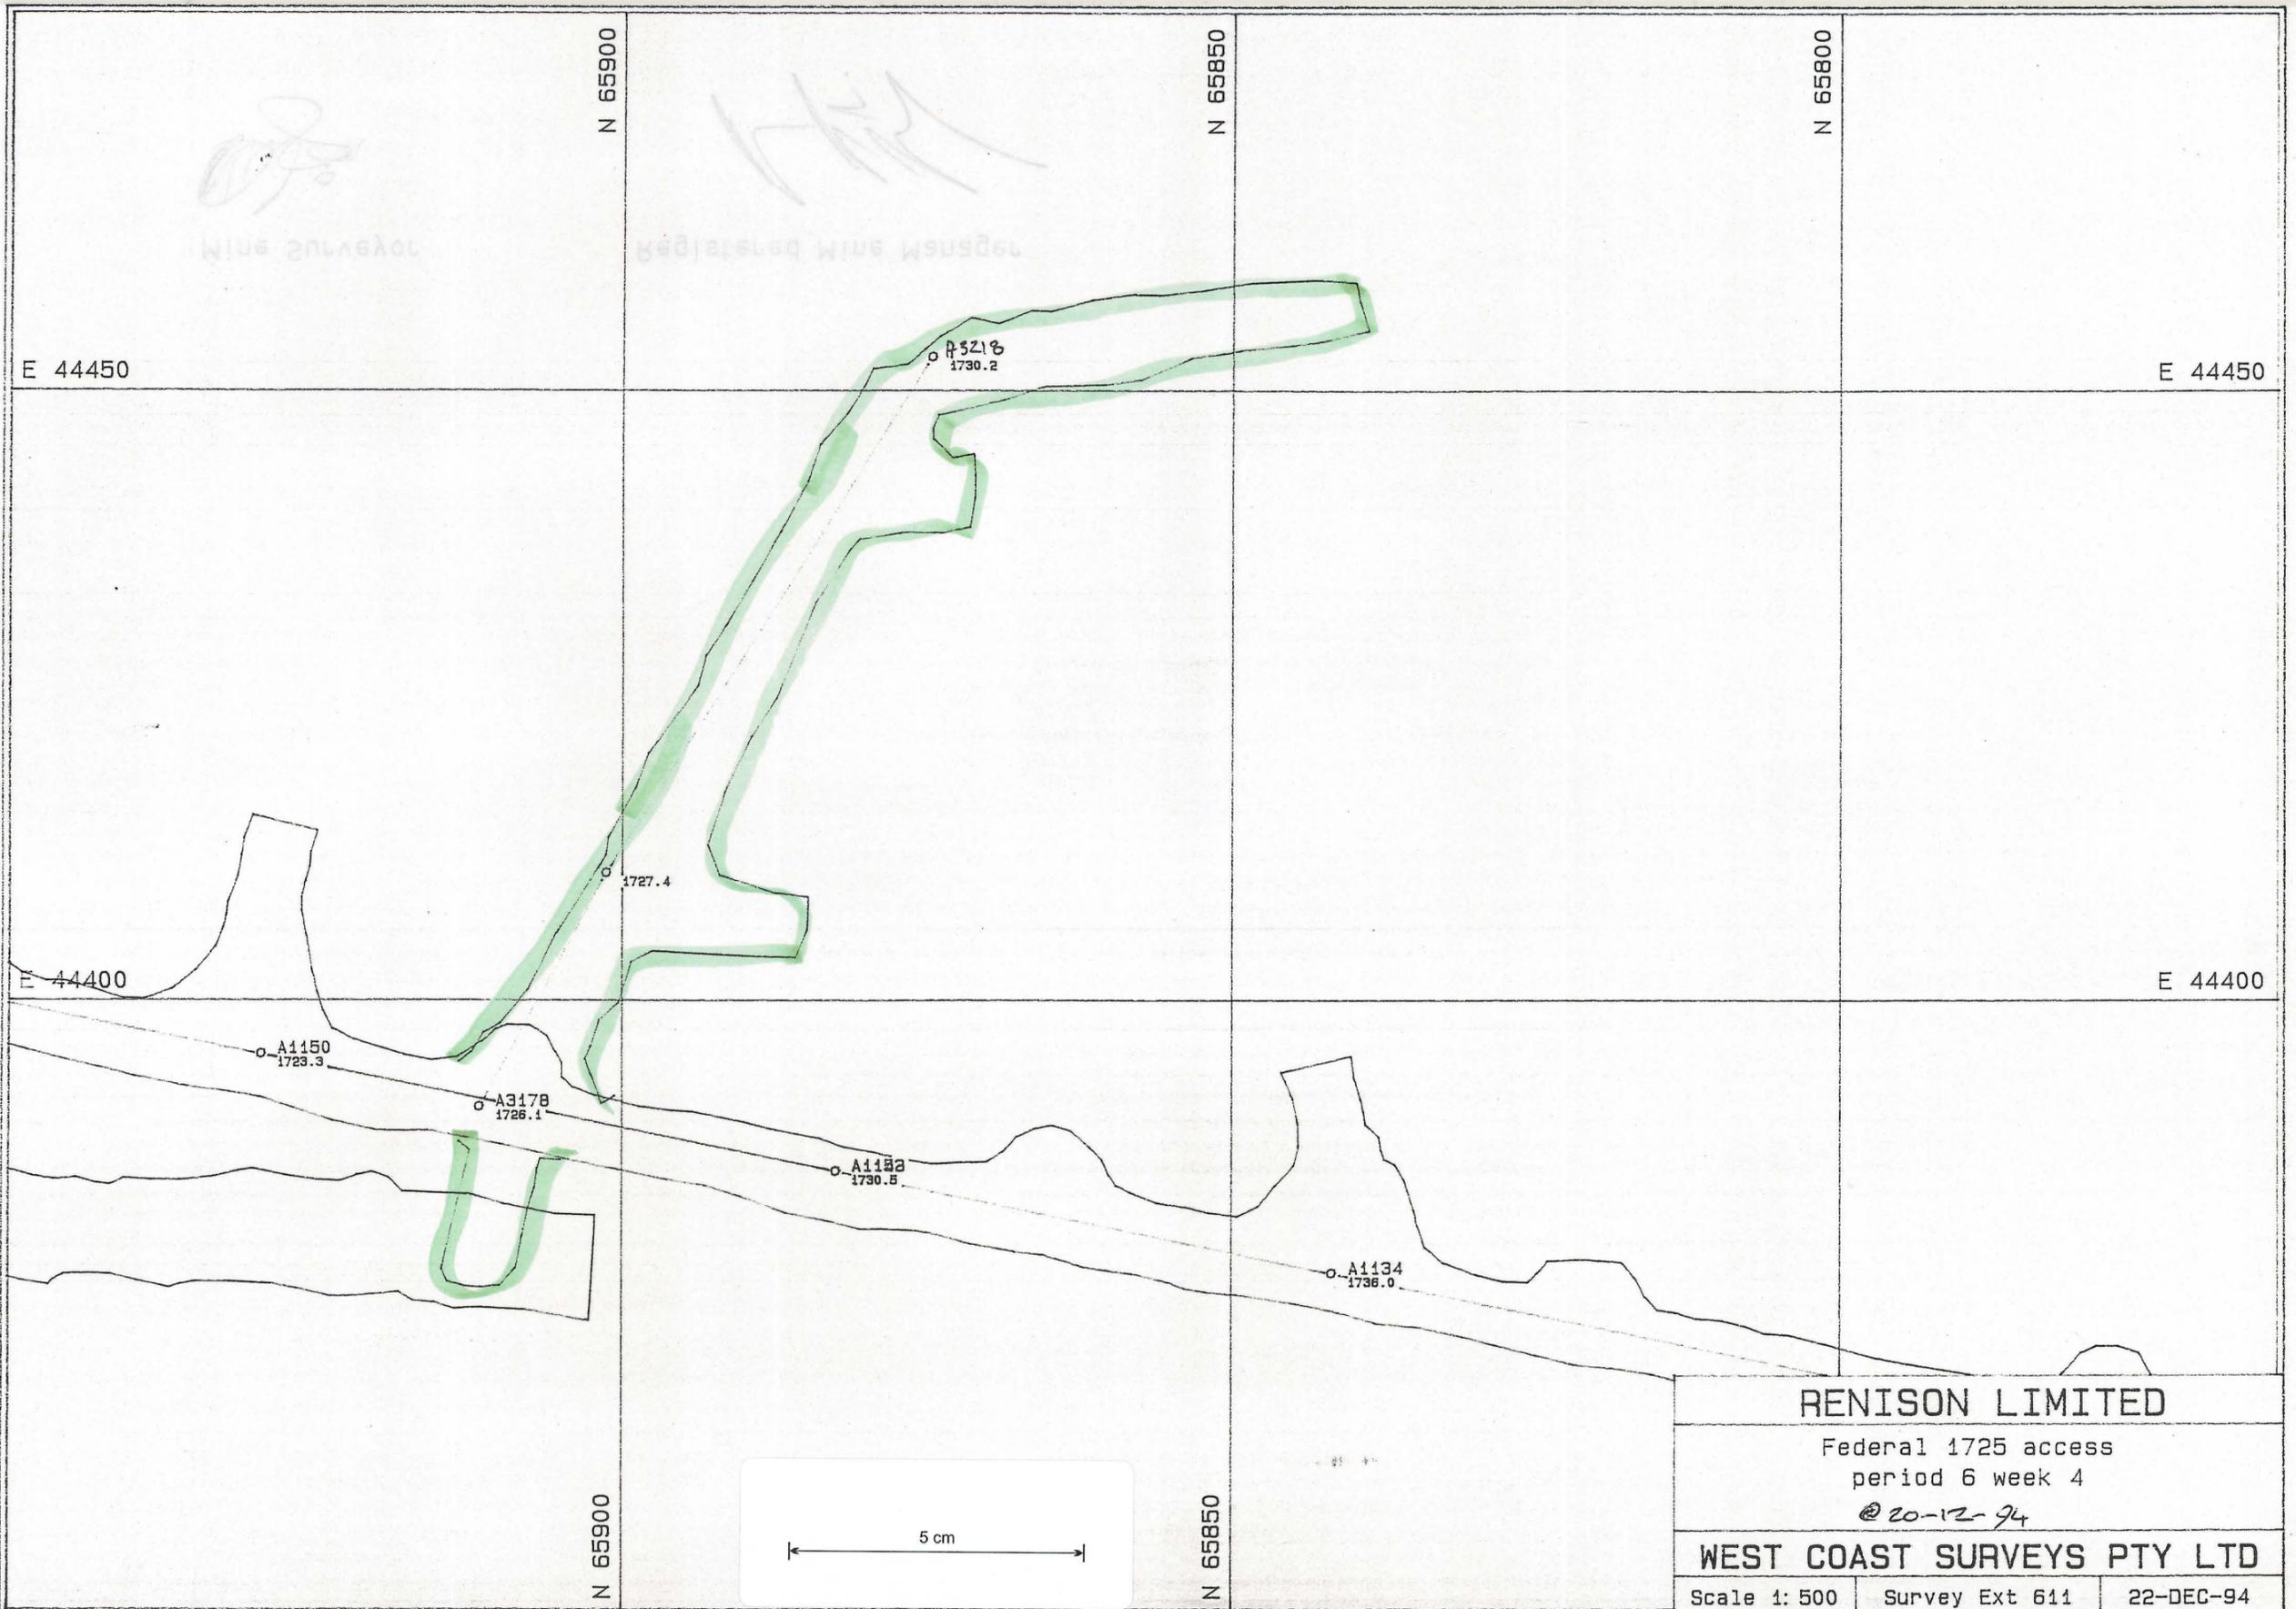

FEDERA.PF

RENISON LIMITED
 Federal 1725 access
 period 6 week 4
 @ 20-12-94
WEST COAST SURVEYS PTY LTD
 Scale 1: 500 | Survey Ext 611 | 22-DEC-94