


0376-168

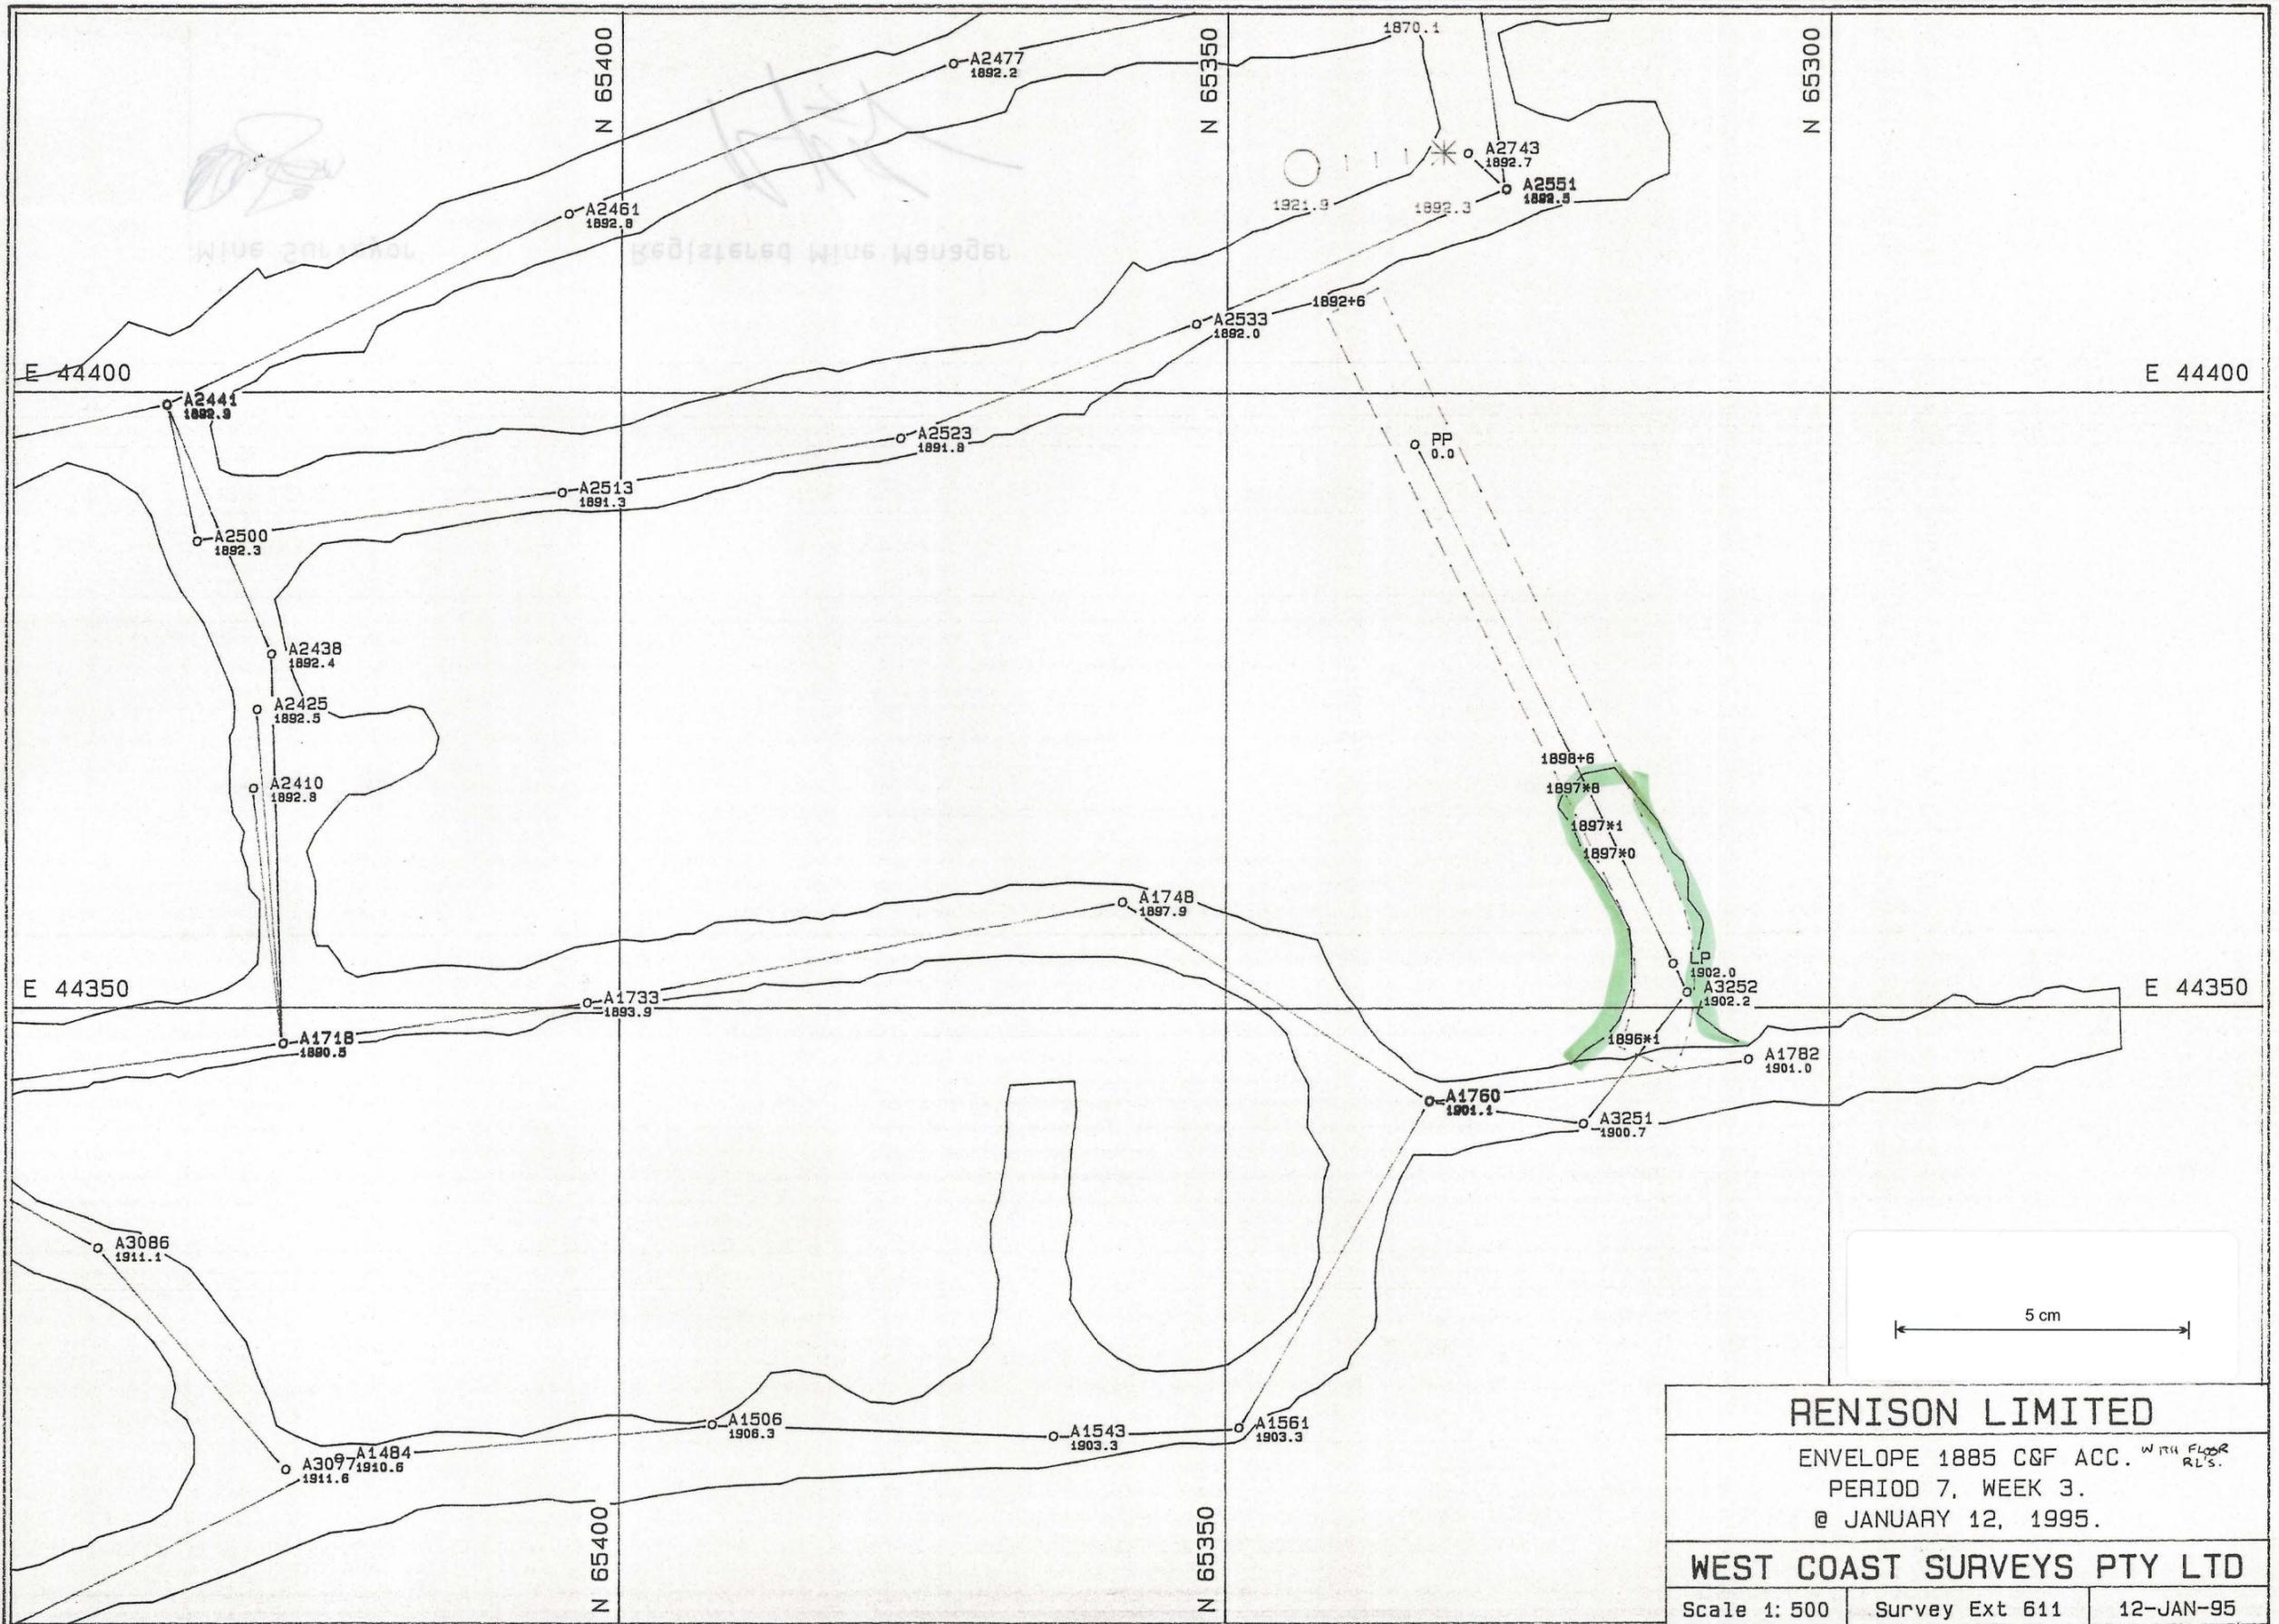

RENISON LIMITED

ENVELOPE 1885 C&F ACC. WITH FLOOR
PERIOD 7, WEEK 3.
@ JANUARY 12, 1995.

WEST COAST SURVEYS PTY LTD

Scale 1: 500 | Survey Ext 611 | 12-JAN-95

ENVCF1.PF