


0376-169

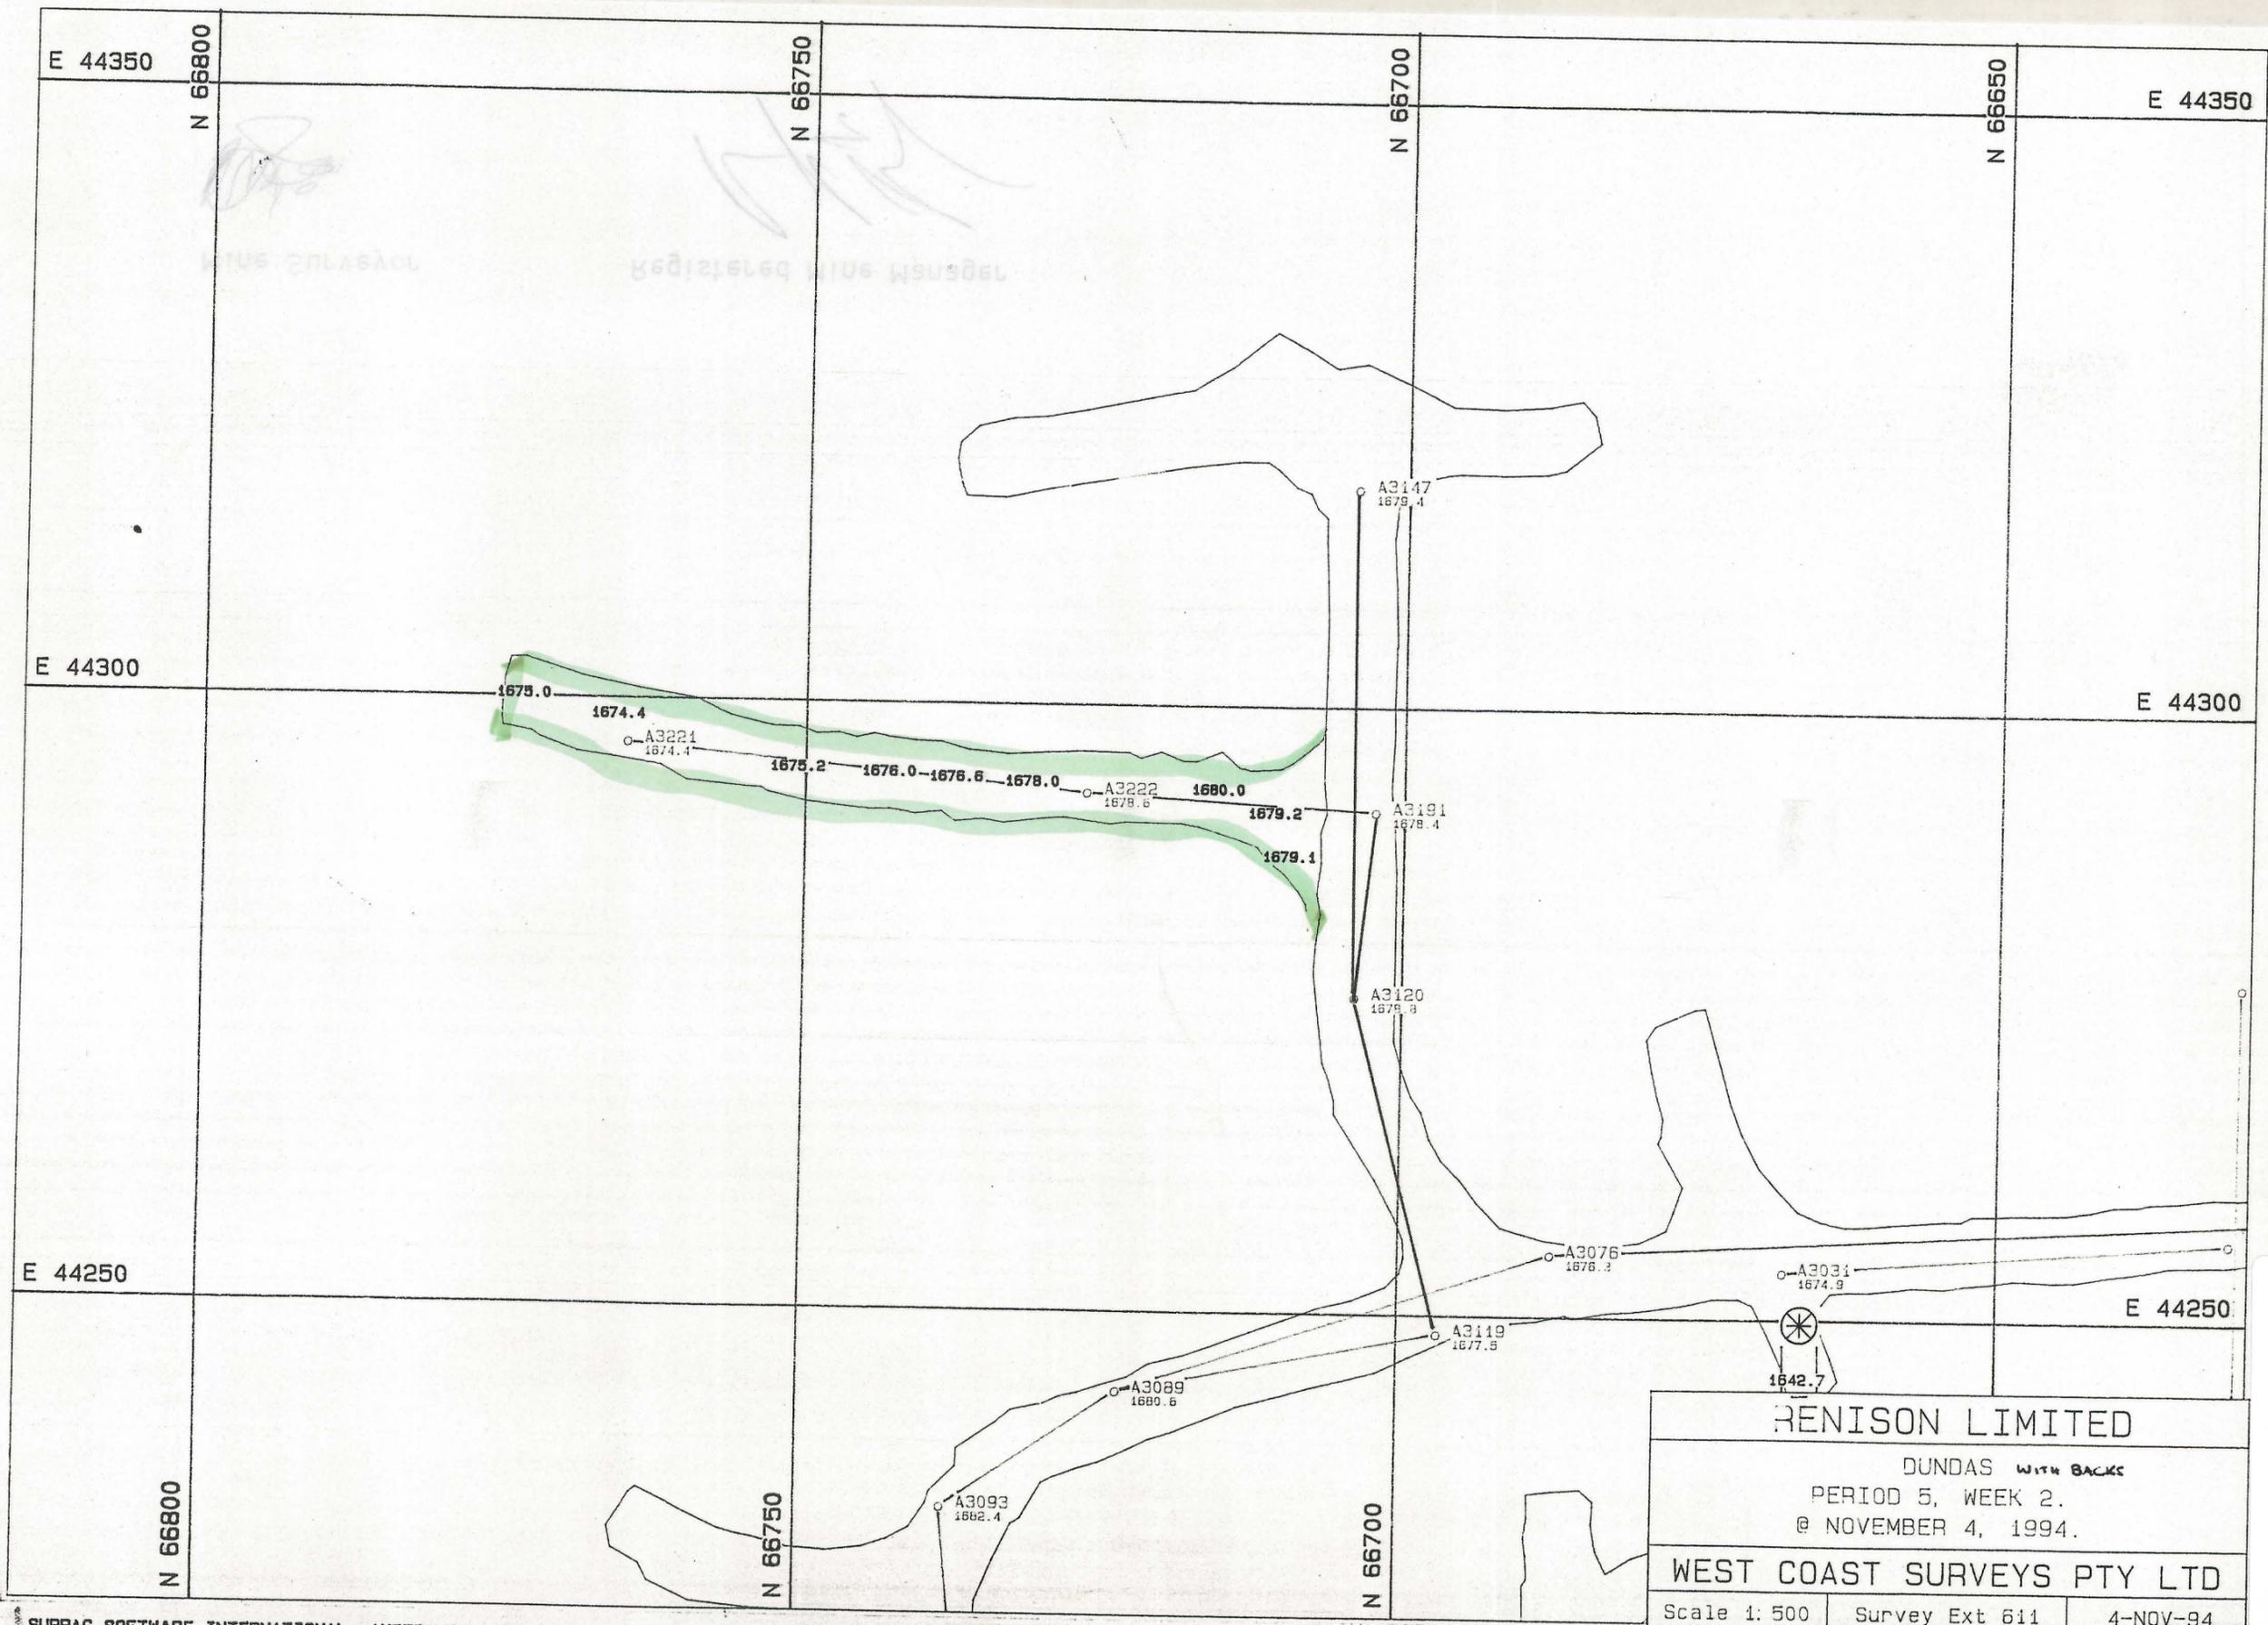

RENISON LIMITED		
DUNDAS WITH BACKS		
PERIOD 5, WEEK 2.		
@ NOVEMBER 4, 1994.		
WEST COAST SURVEYS PTY LTD		
Scale 1: 500	Survey Ext 611	4-NOV-94

5 cm

DUNDAS.PF