


0376-170

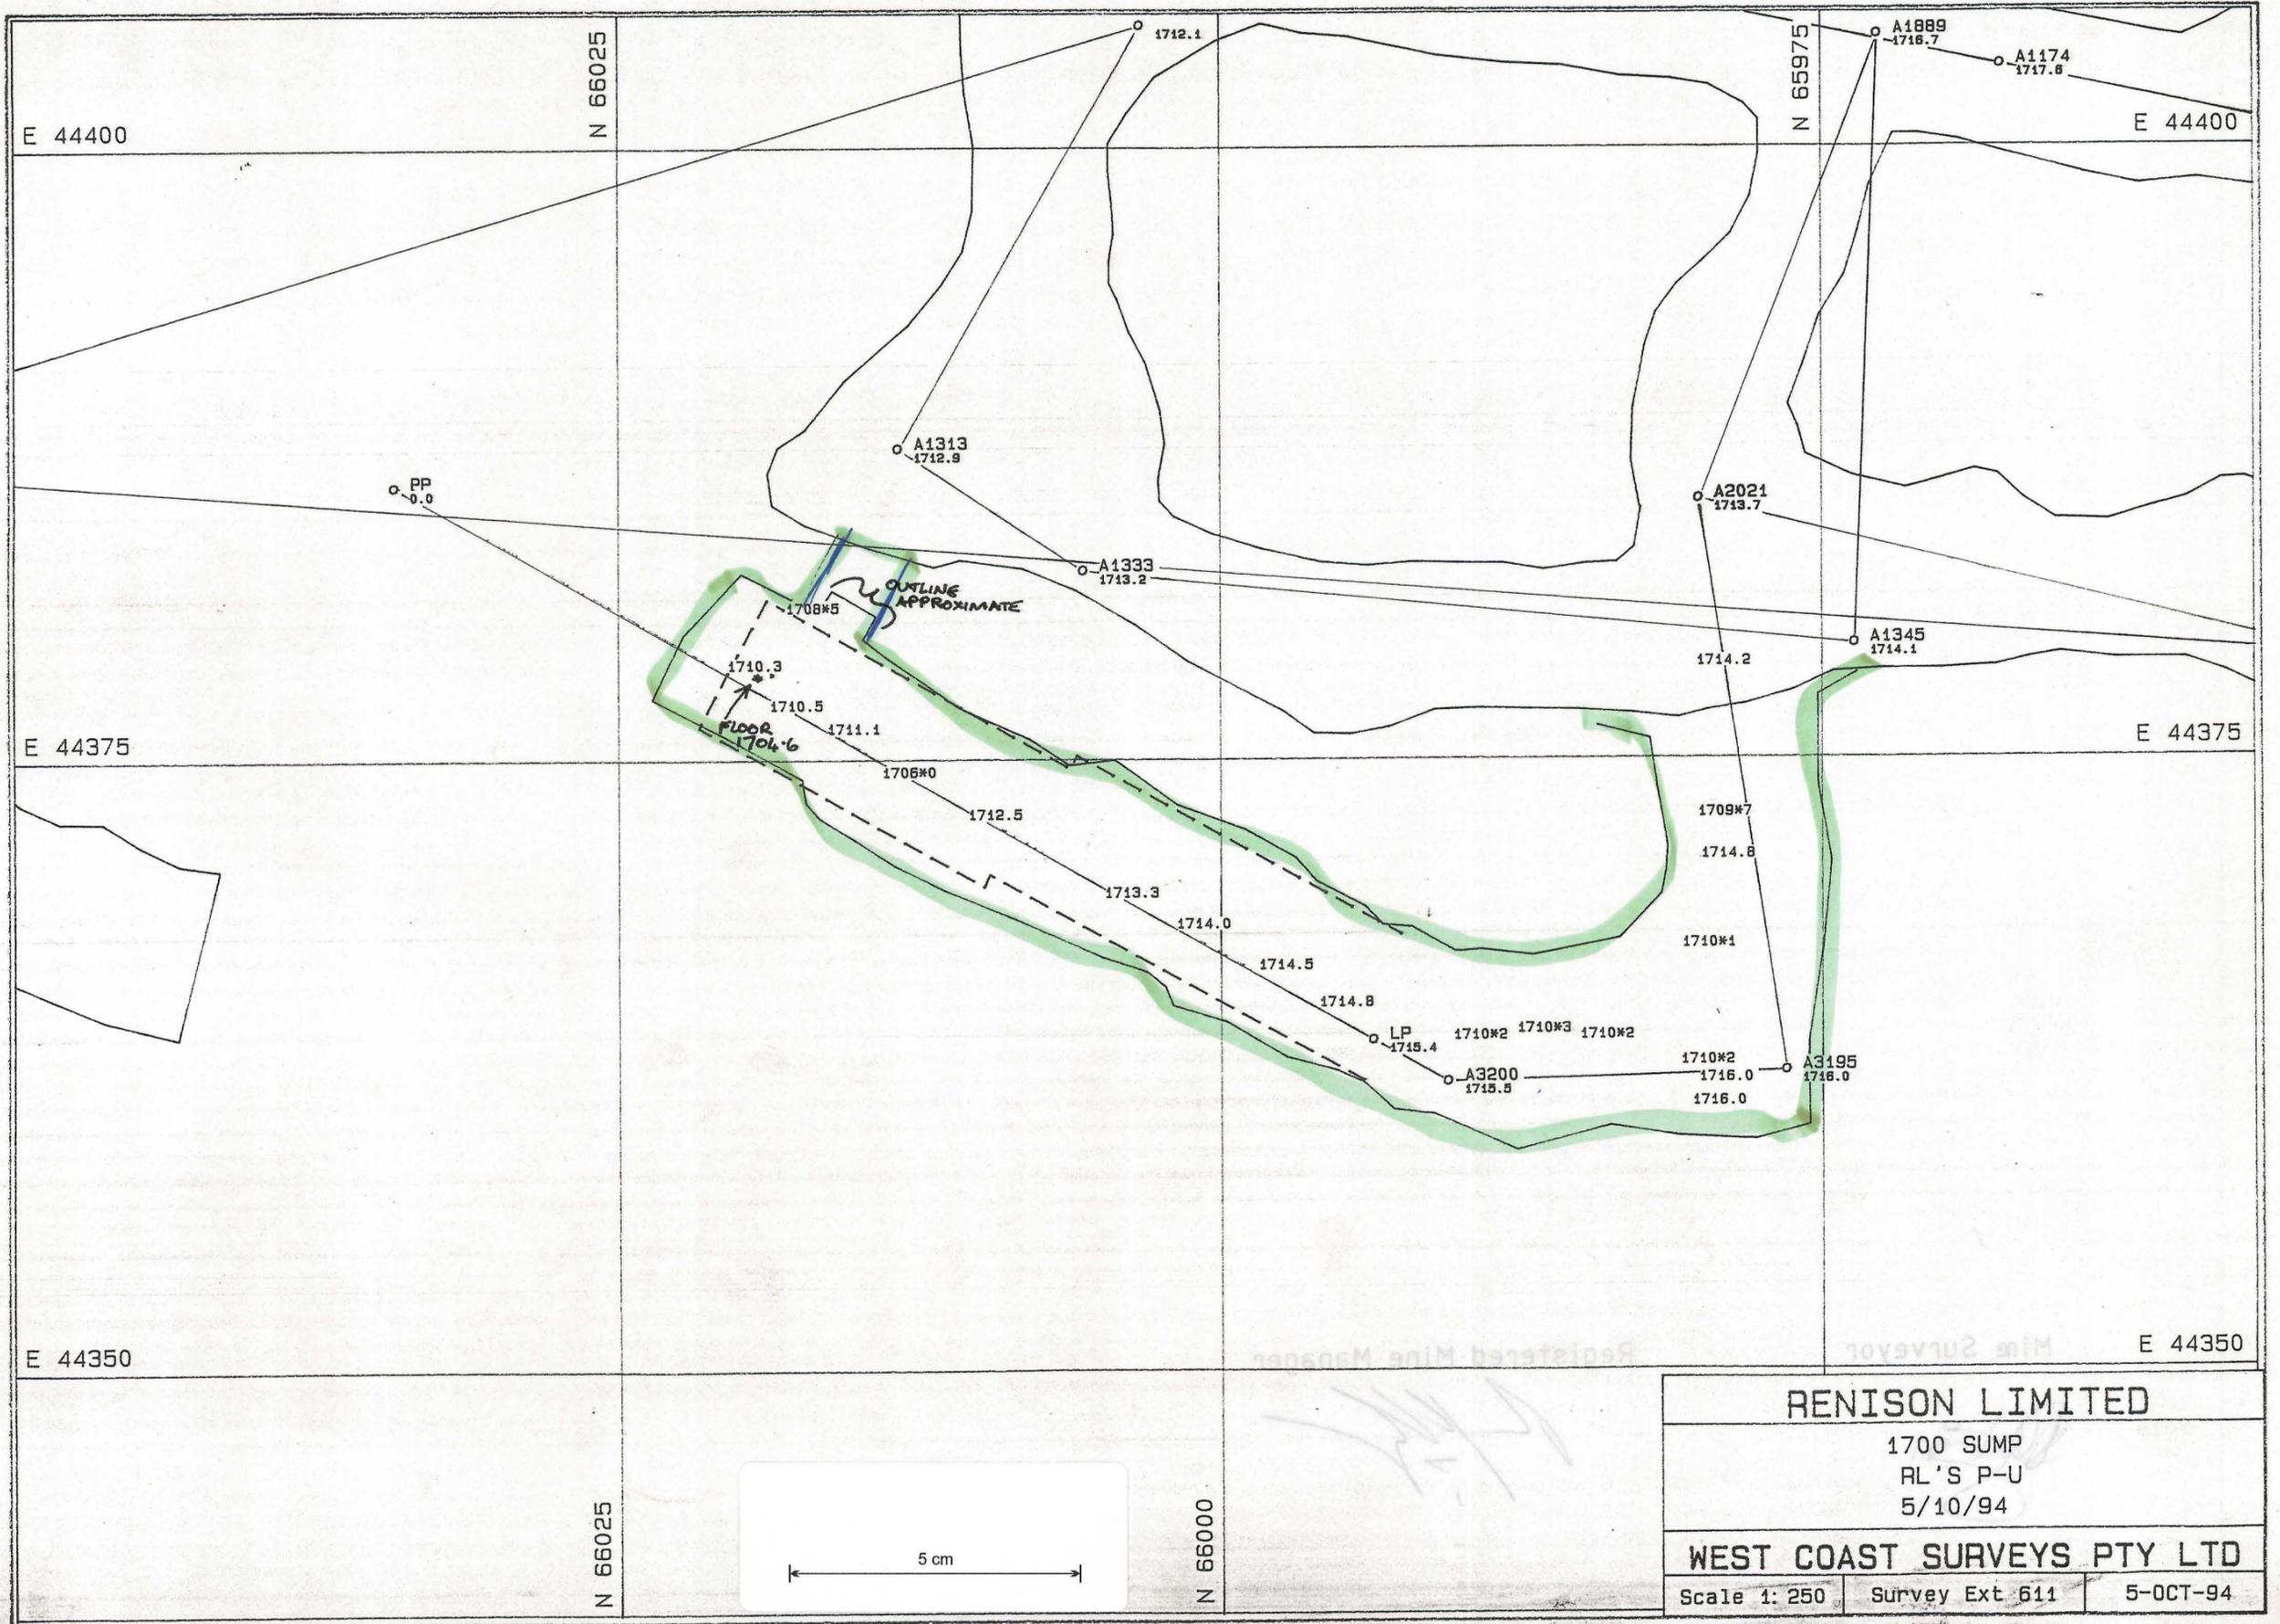

RENISON LIMITED

1700 SUMP
RL'S P-U
5/10/94

WEST COAST SURVEYS PTY LTD

Scale 1: 250	Survey Ext 611	5-OCT-94
--------------	----------------	----------

1700SF.PF