


0376-171

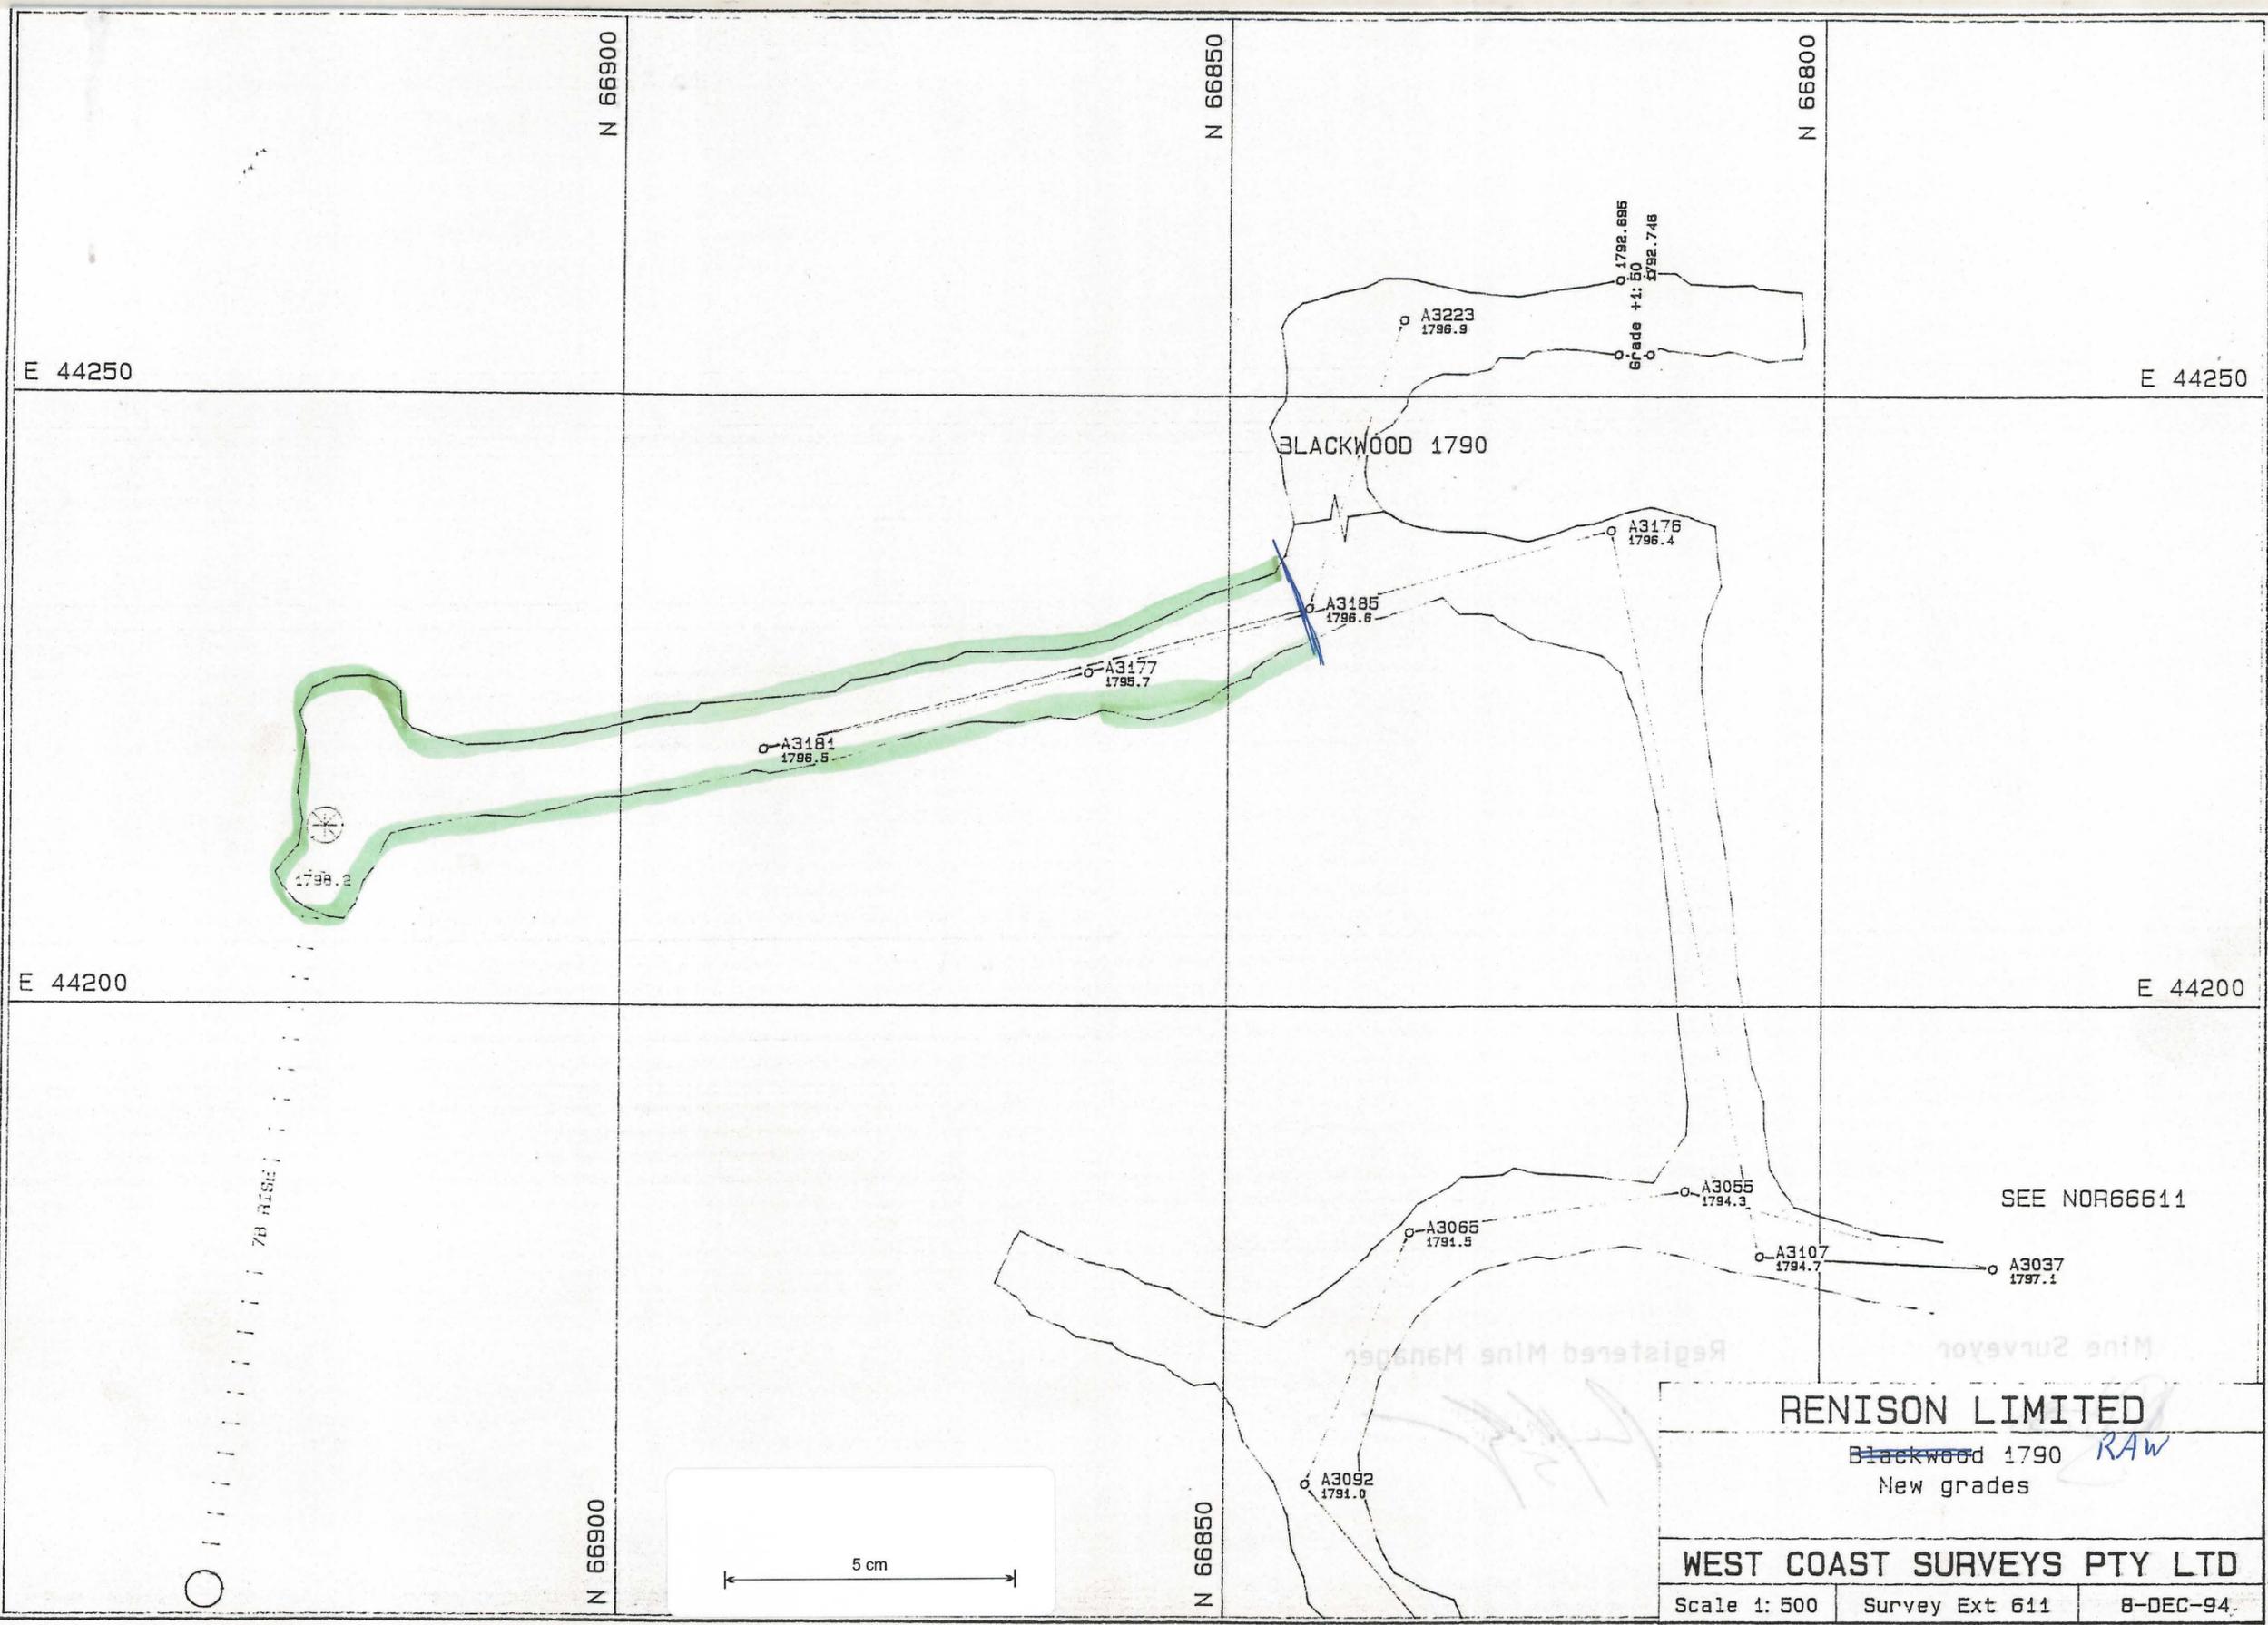

SEE NOR66611

RENISON LIMITED

Blackwood 1790 *RAW*
New grades

WEST COAST SURVEYS PTY LTD

Scale 1: 500 | Survey Ext 611 | 8-DEC-94.

BLACKB.PF