


0376-172

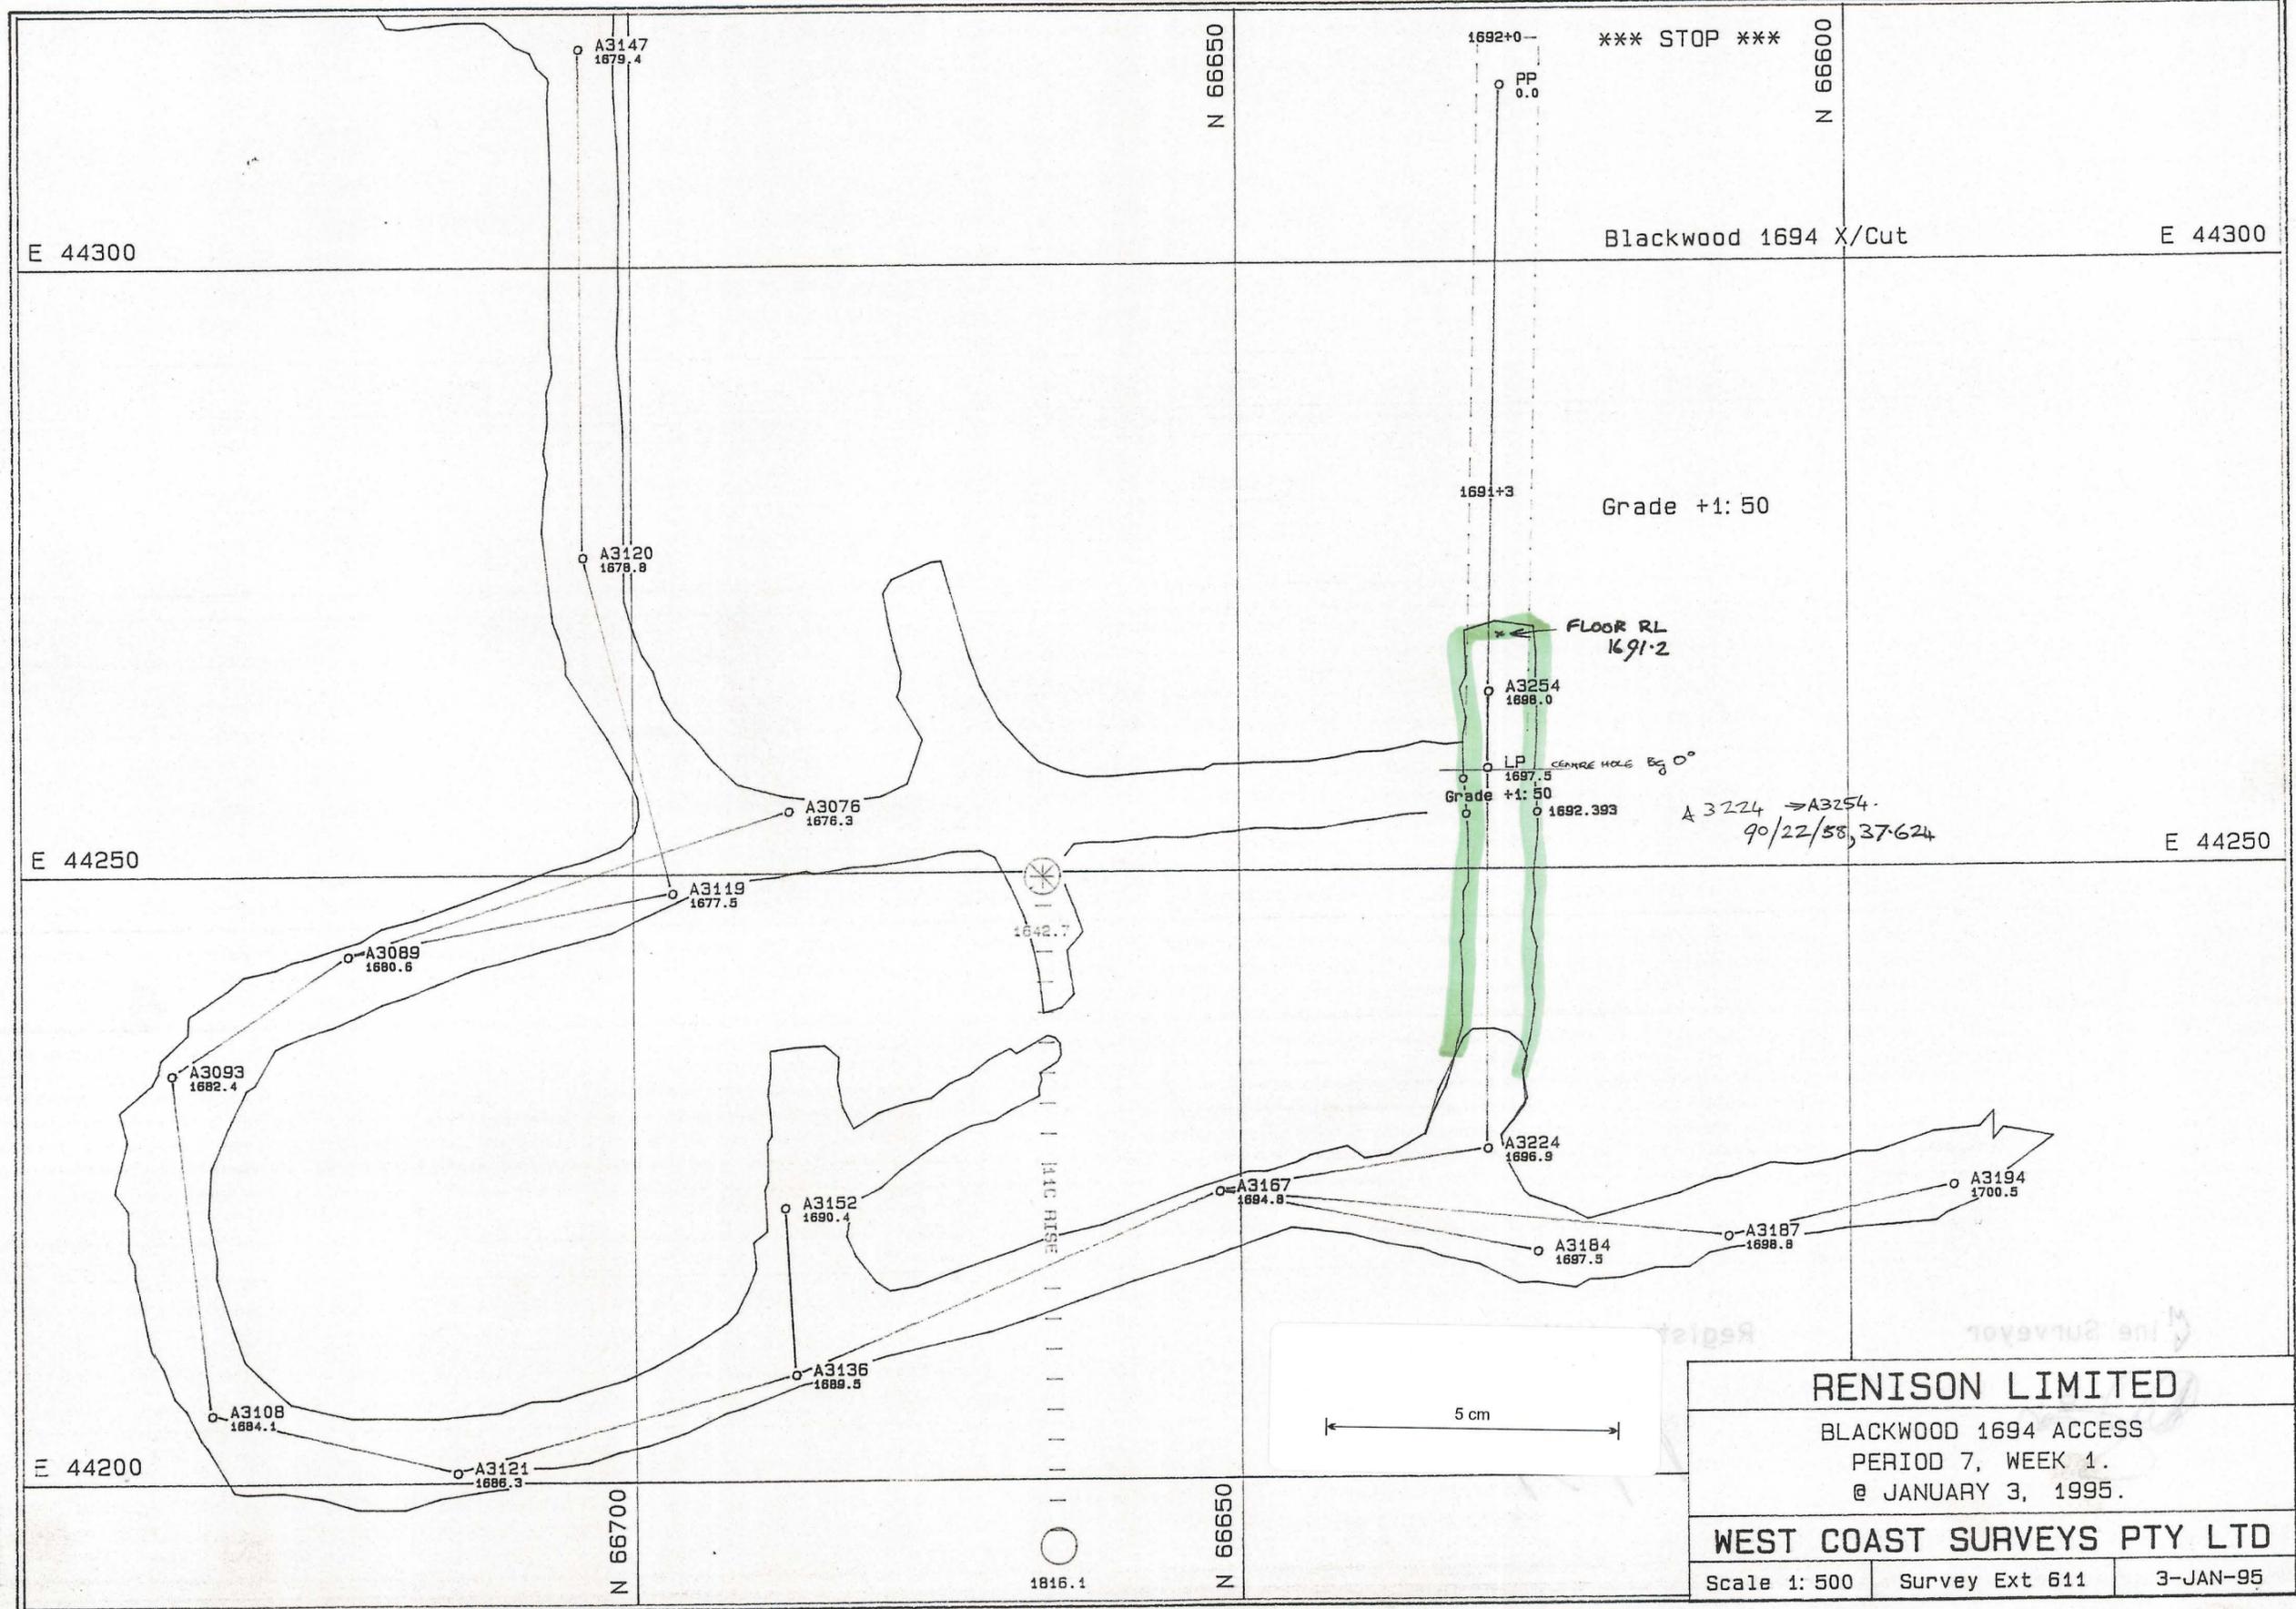

RENISON LIMITED		
BLACKWOOD 1694 ACCESS PERIOD 7, WEEK 1. @ JANUARY 3, 1995.		
WEST COAST SURVEYS PTY LTD		
Scale 1: 500	Survey Ext 611	3-JAN-95

BLACKA.PF