


0376-173

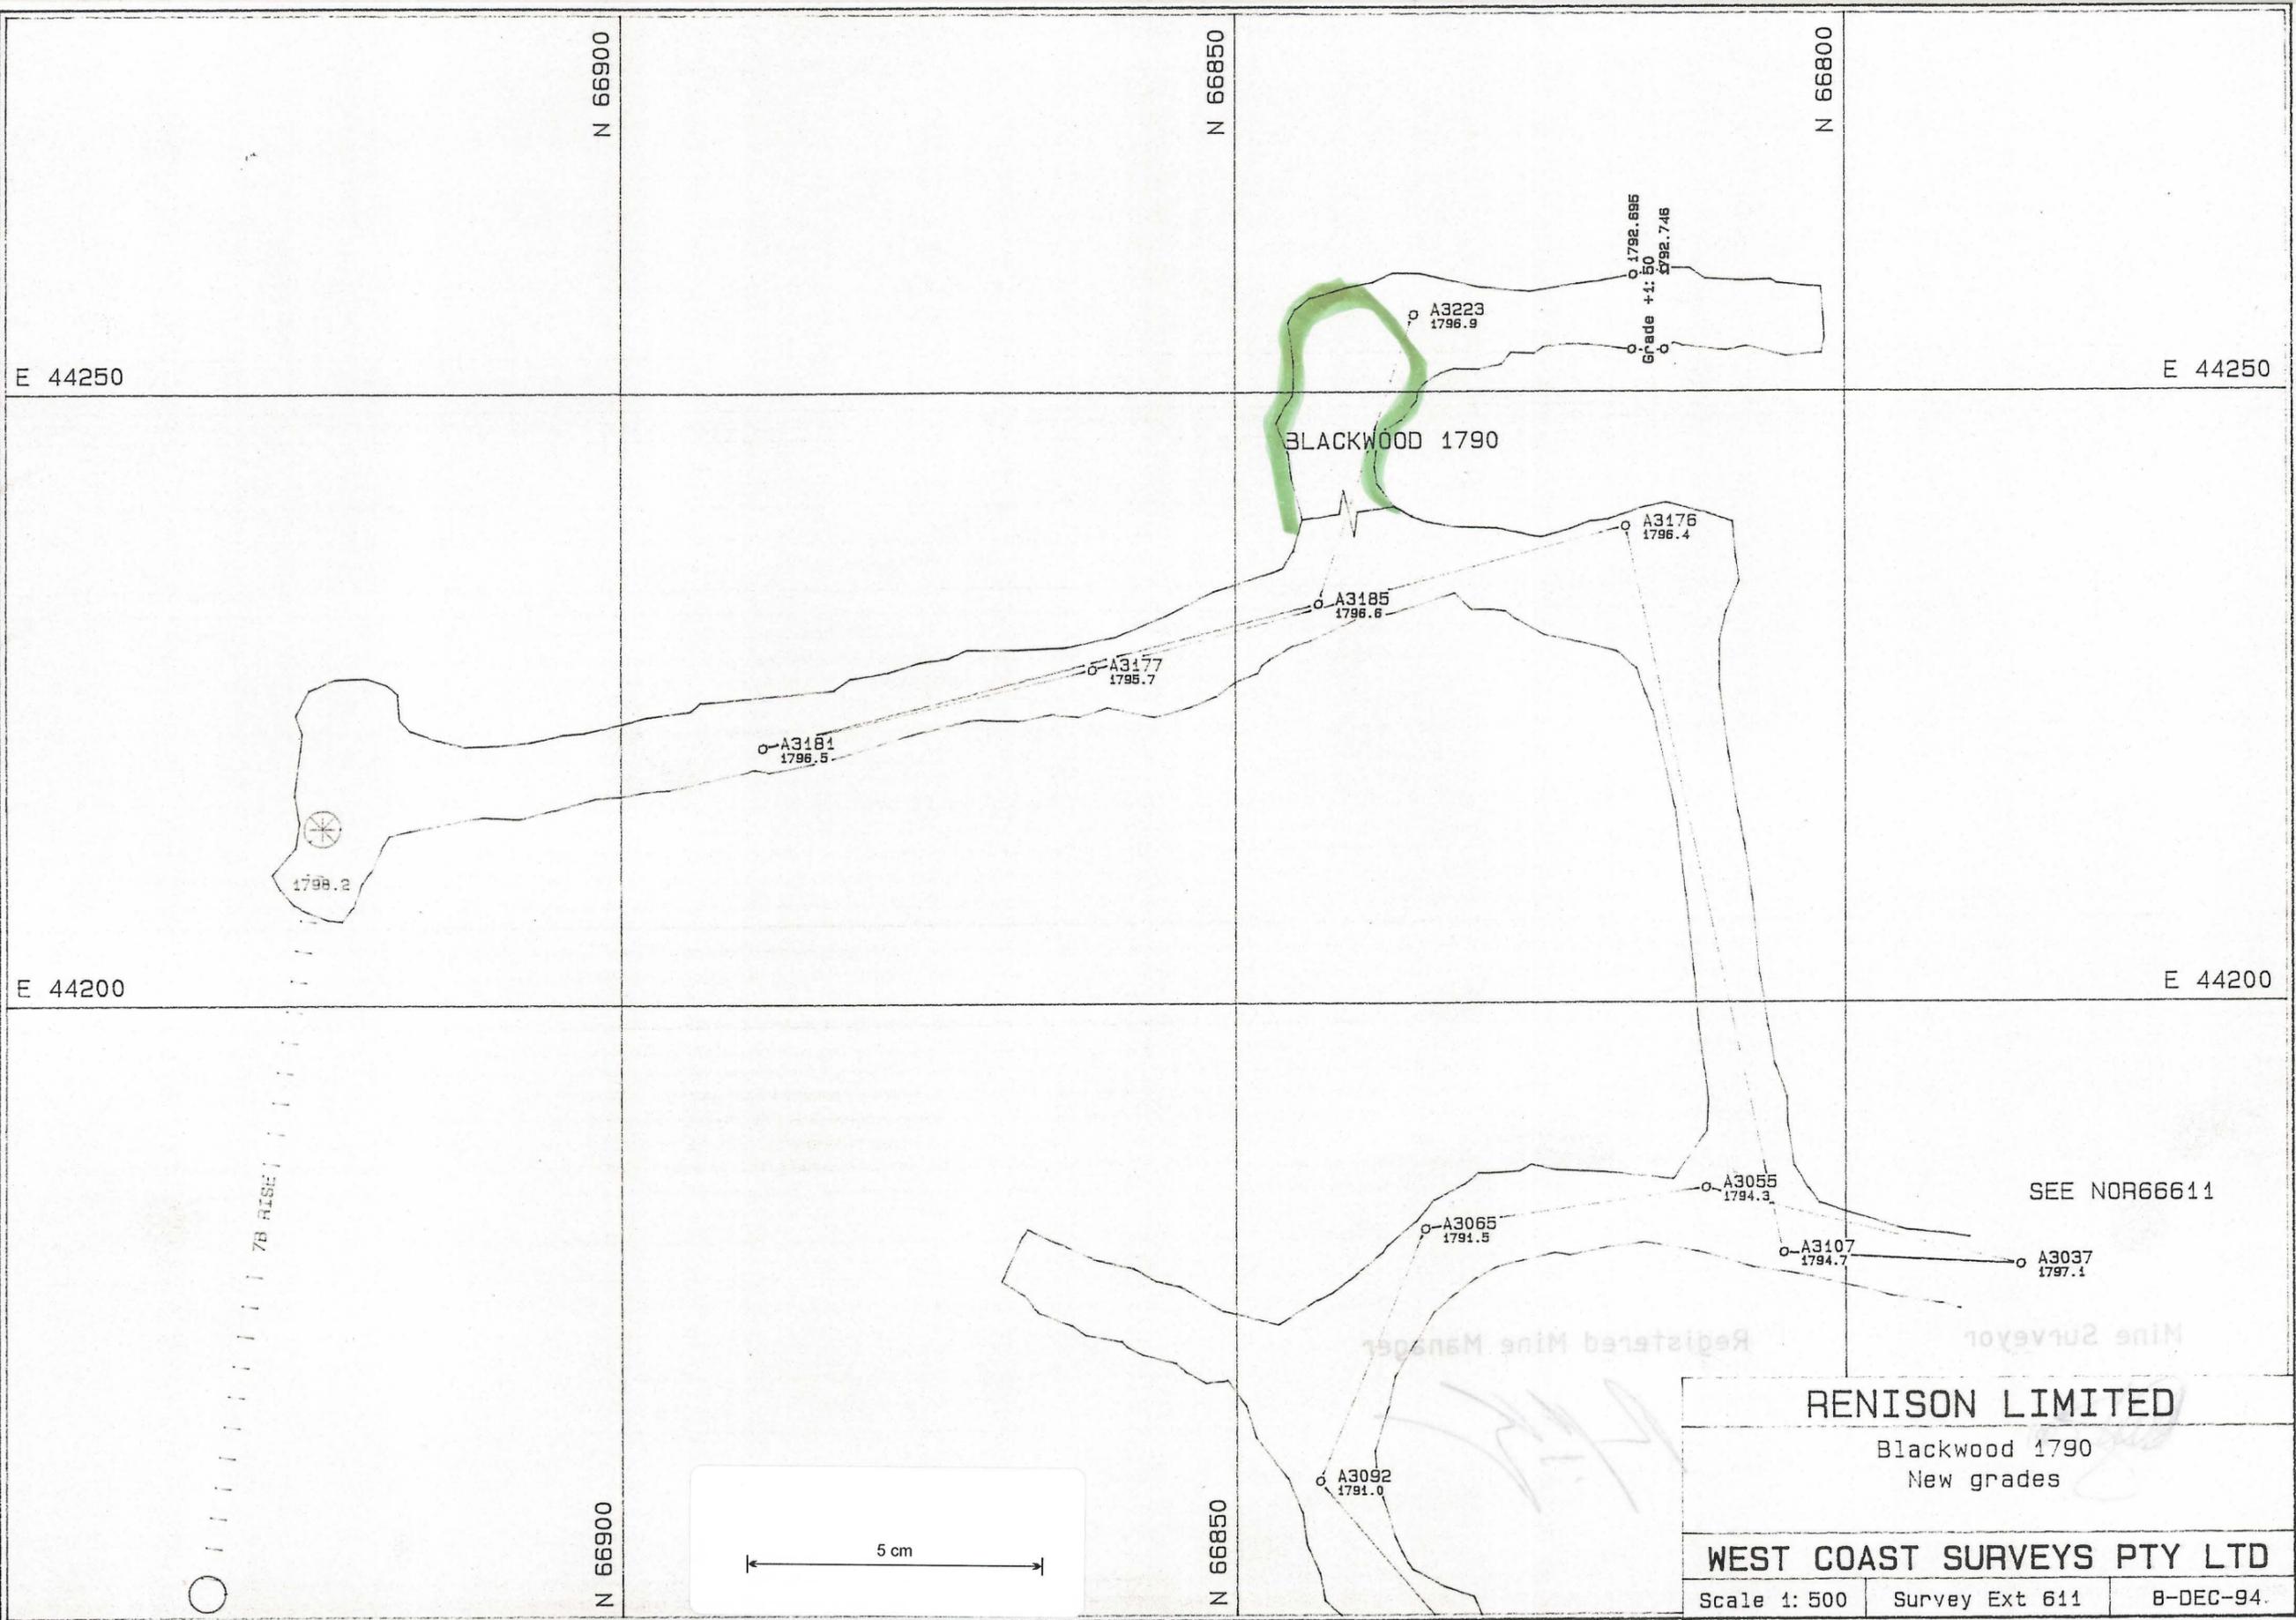

SEE NOR66611

RENISON LIMITED

Blackwood 1790
New grades

WEST COAST SURVEYS PTY LTD

Scale 1: 500	Survey Ext 611	B-DEC-94.
--------------	----------------	-----------

BLACKB.PF