


0376-174

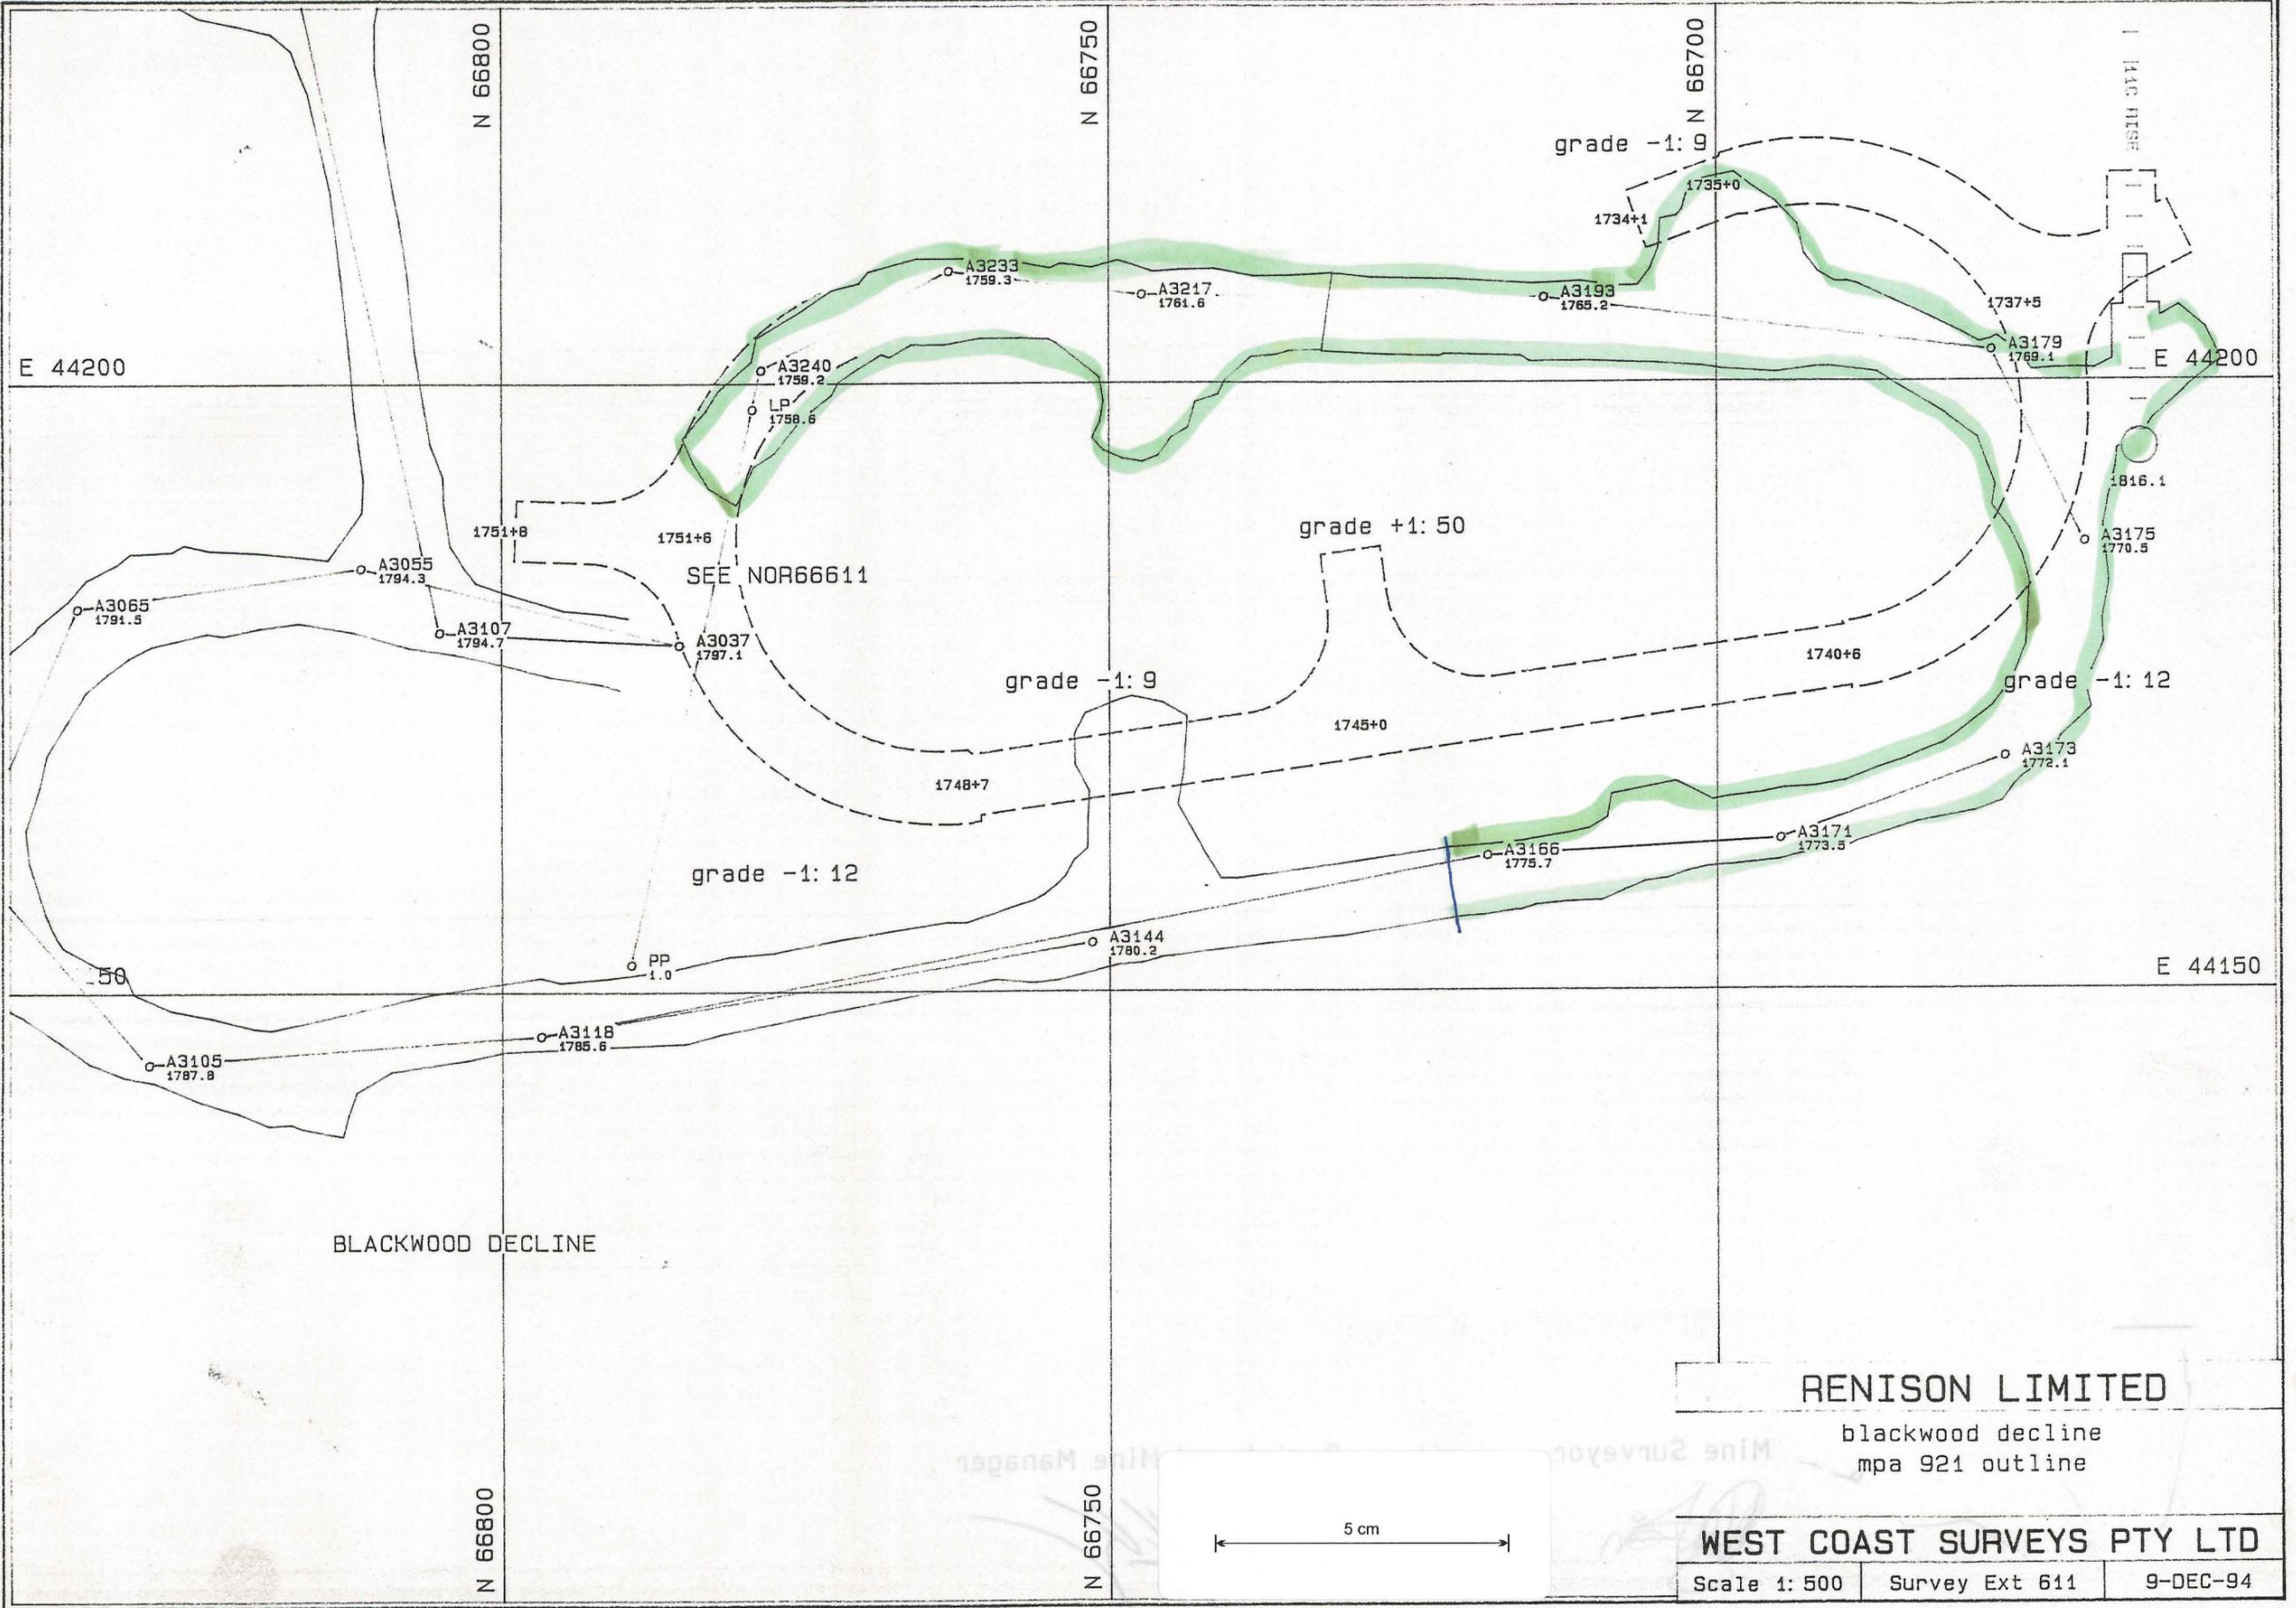

RENISON LIMITED

blackwood decline  
mpa 921 outline

WEST COAST SURVEYS PTY LTD

Scale 1: 500	Survey Ext 611	9-DEC-94
--------------	----------------	----------

BLACKA.PF