


0376-175

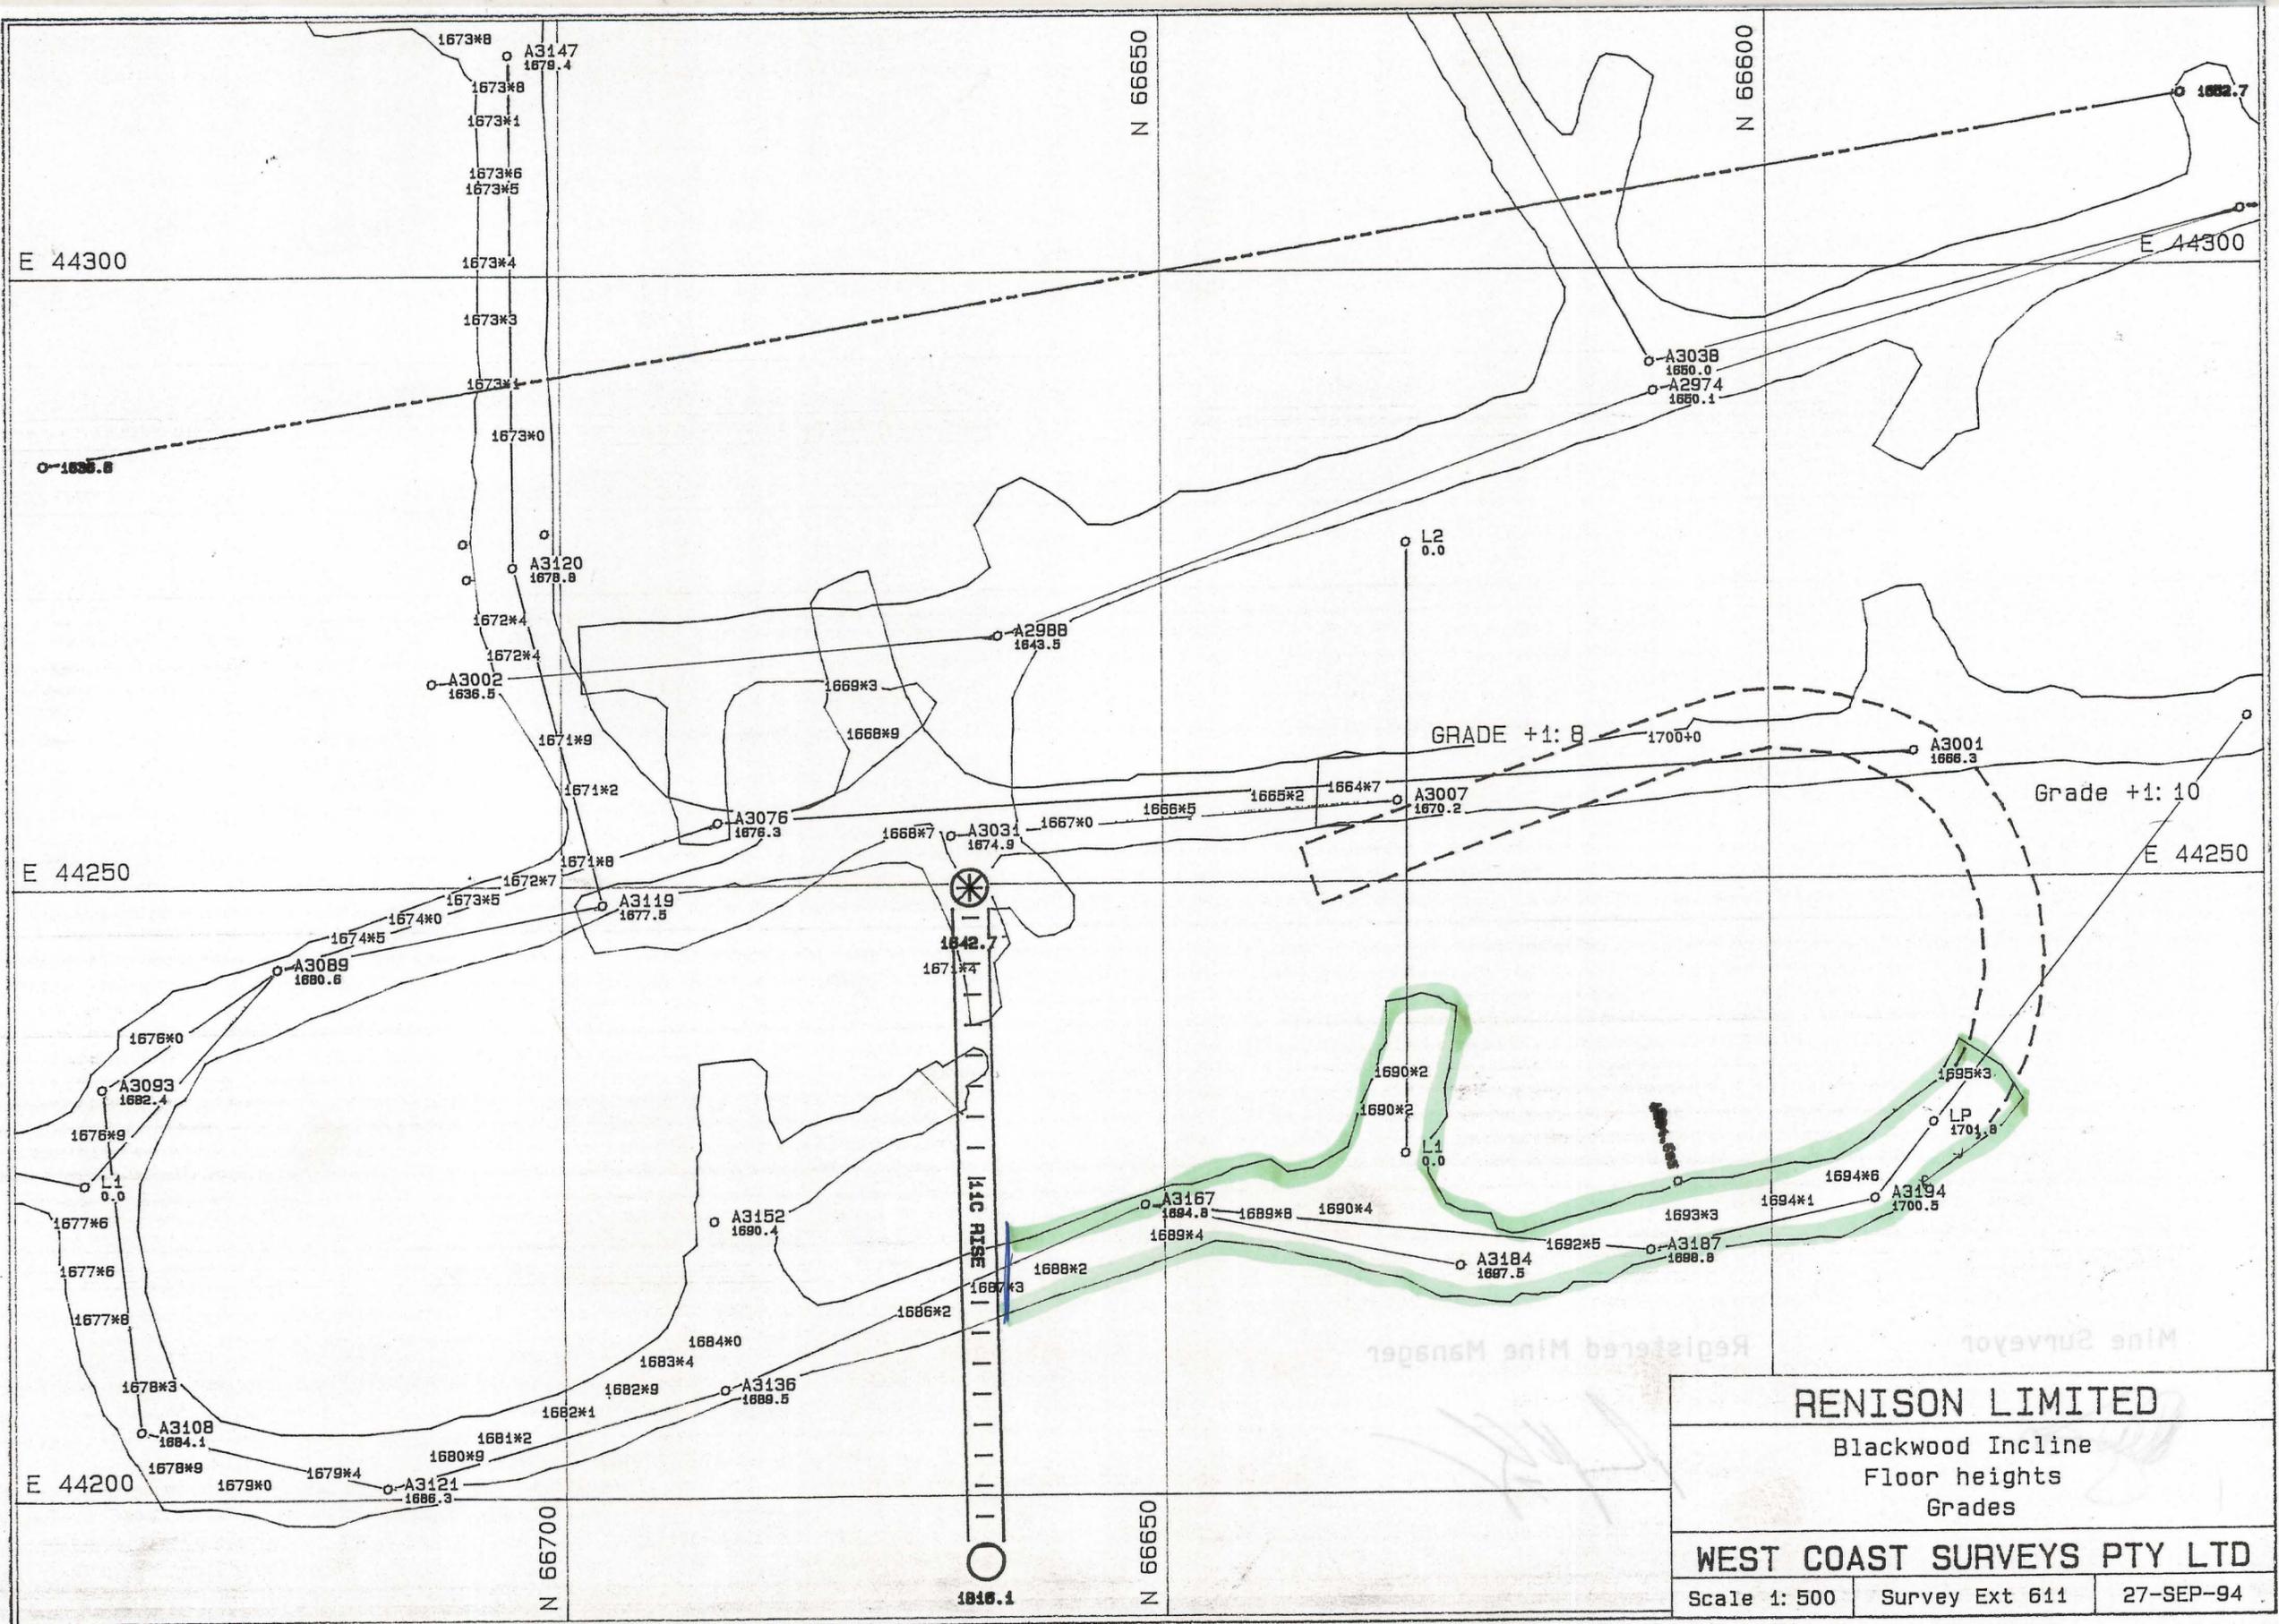

RENISON LIMITED		
Blackwood Incline Floor heights Grades		
WEST COAST SURVEYS PTY LTD		
Scale 1: 500	Survey Ext 611	27-SEP-94

BLACKC.PF