


0376-176

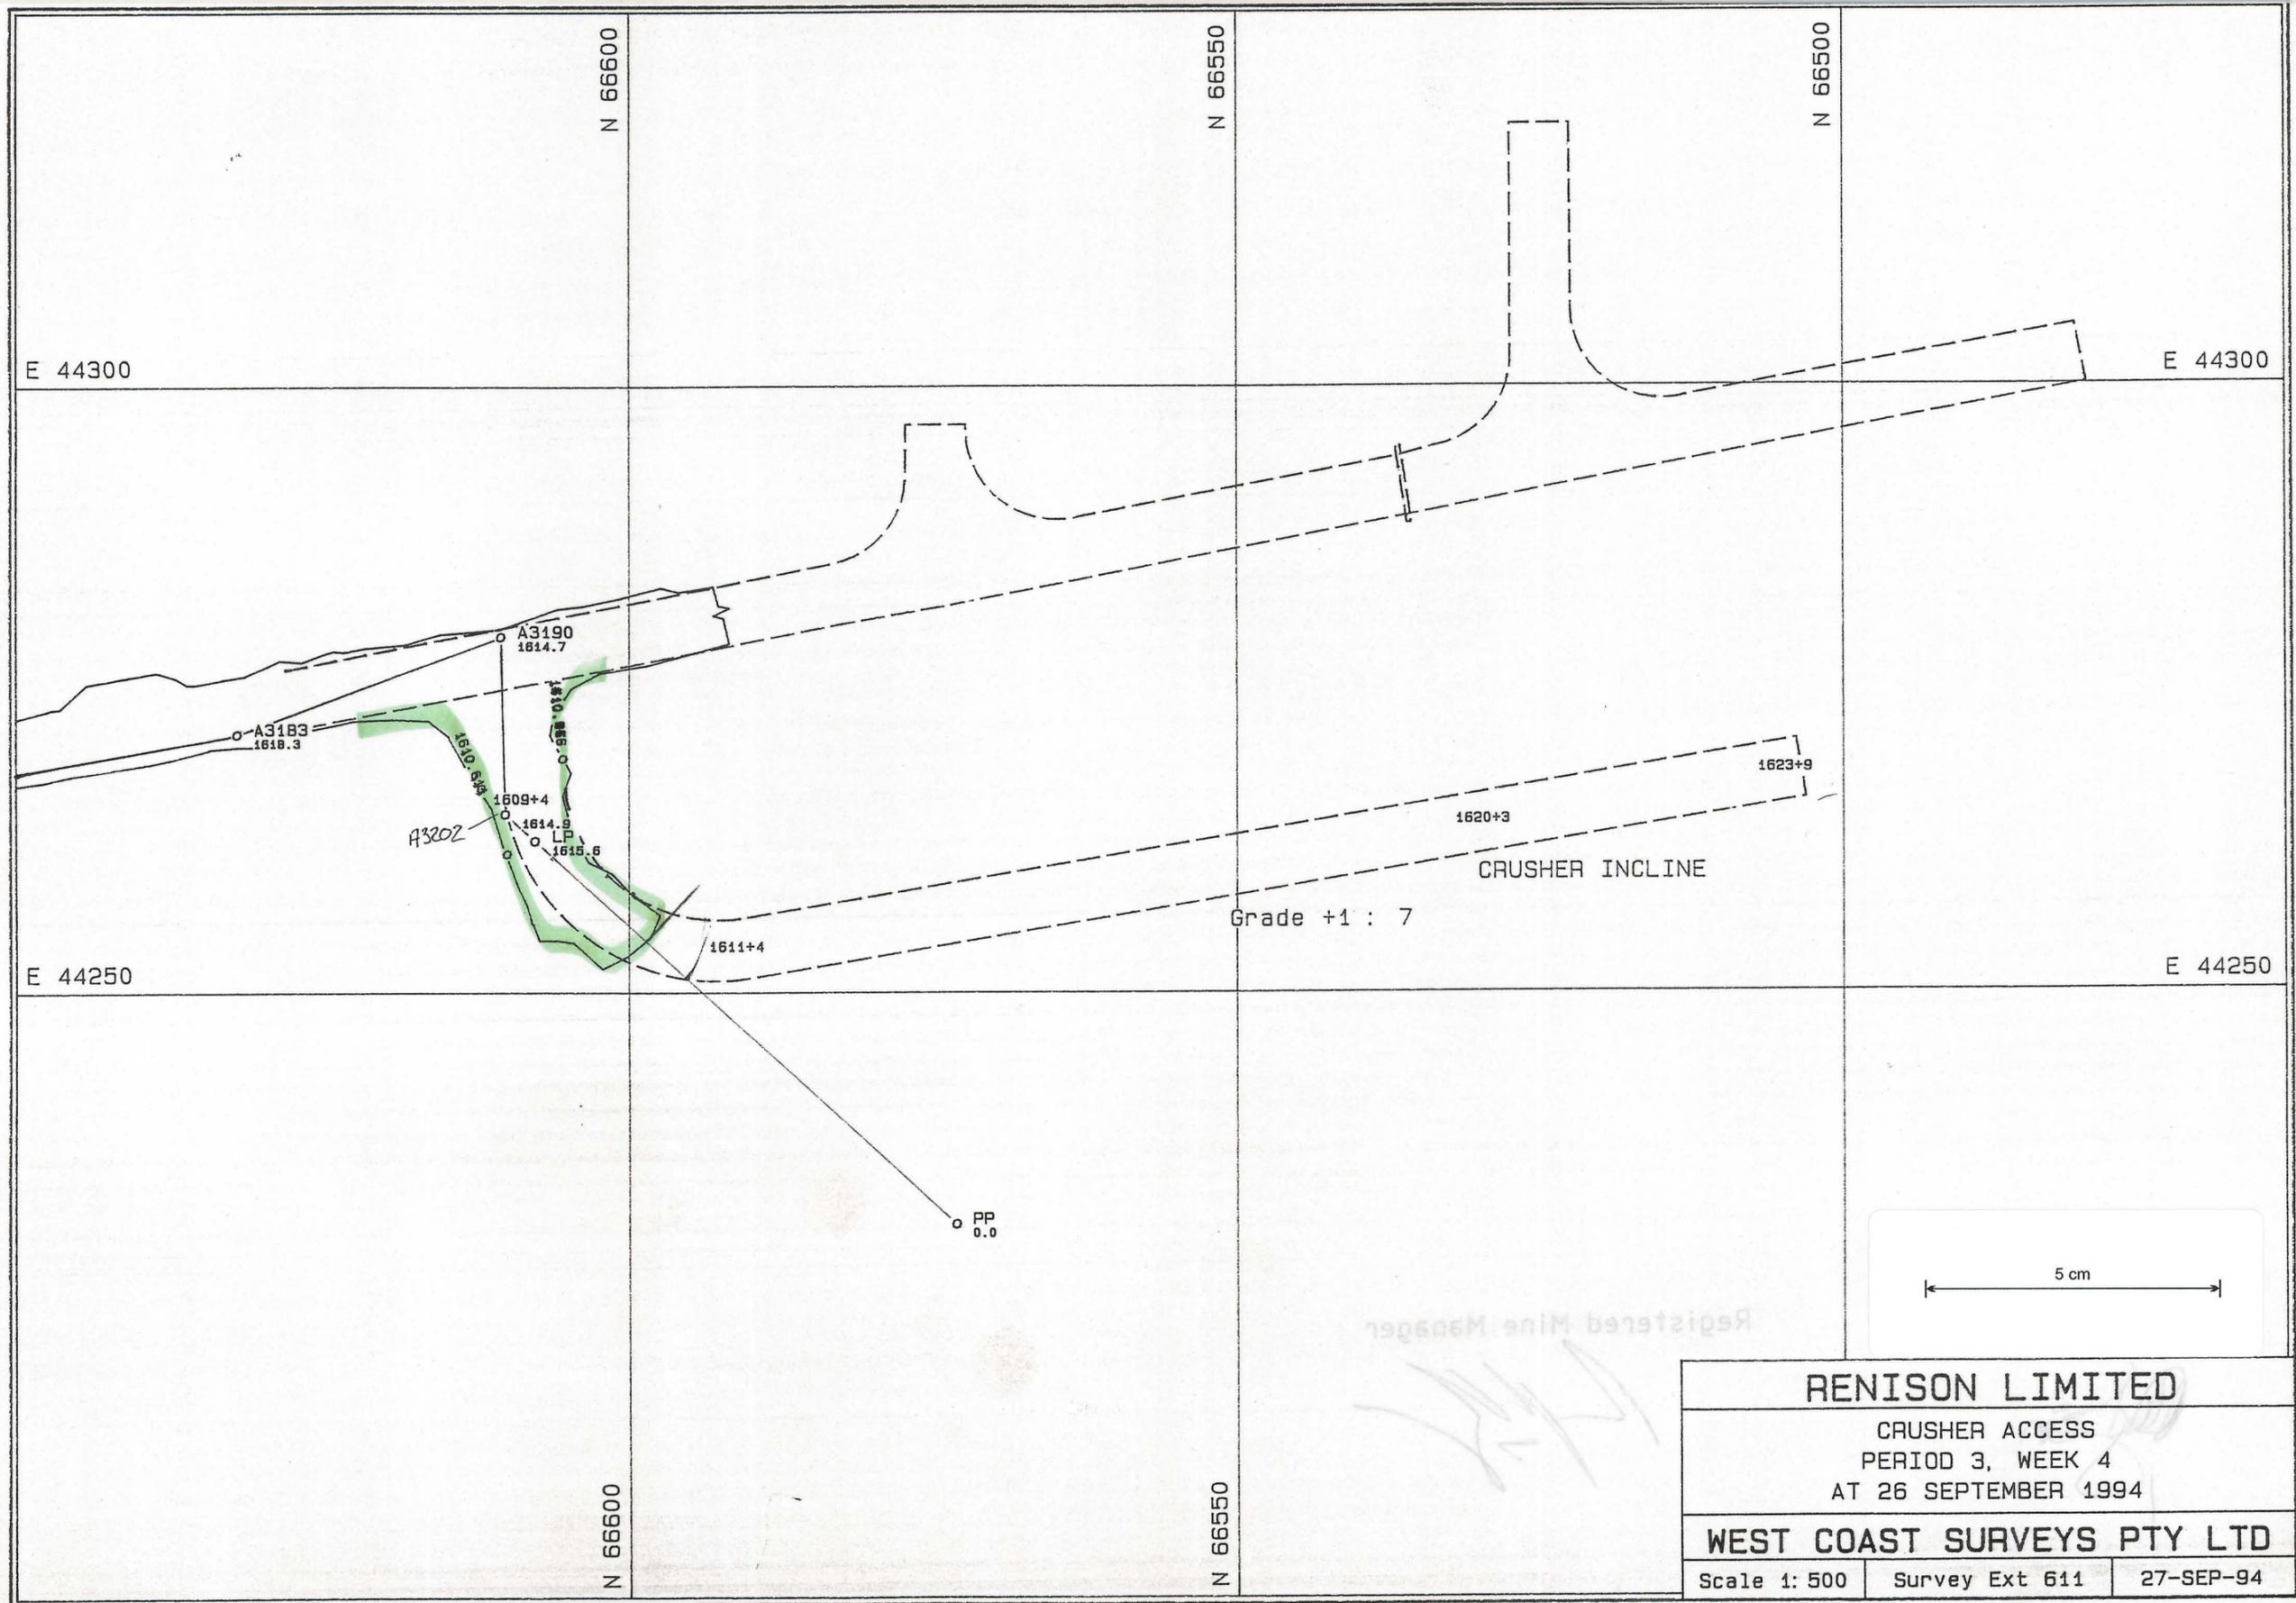

Registered Mine Manager

[Handwritten signature]

RENISON LIMITED		
CRUSHER ACCESS PERIOD 3, WEEK 4 AT 26 SEPTEMBER 1994		
WEST COAST SURVEYS PTY LTD		
Scale 1: 500	Survey Ext 611	27-SEP-94

CRUSHB.PF