


0376-177

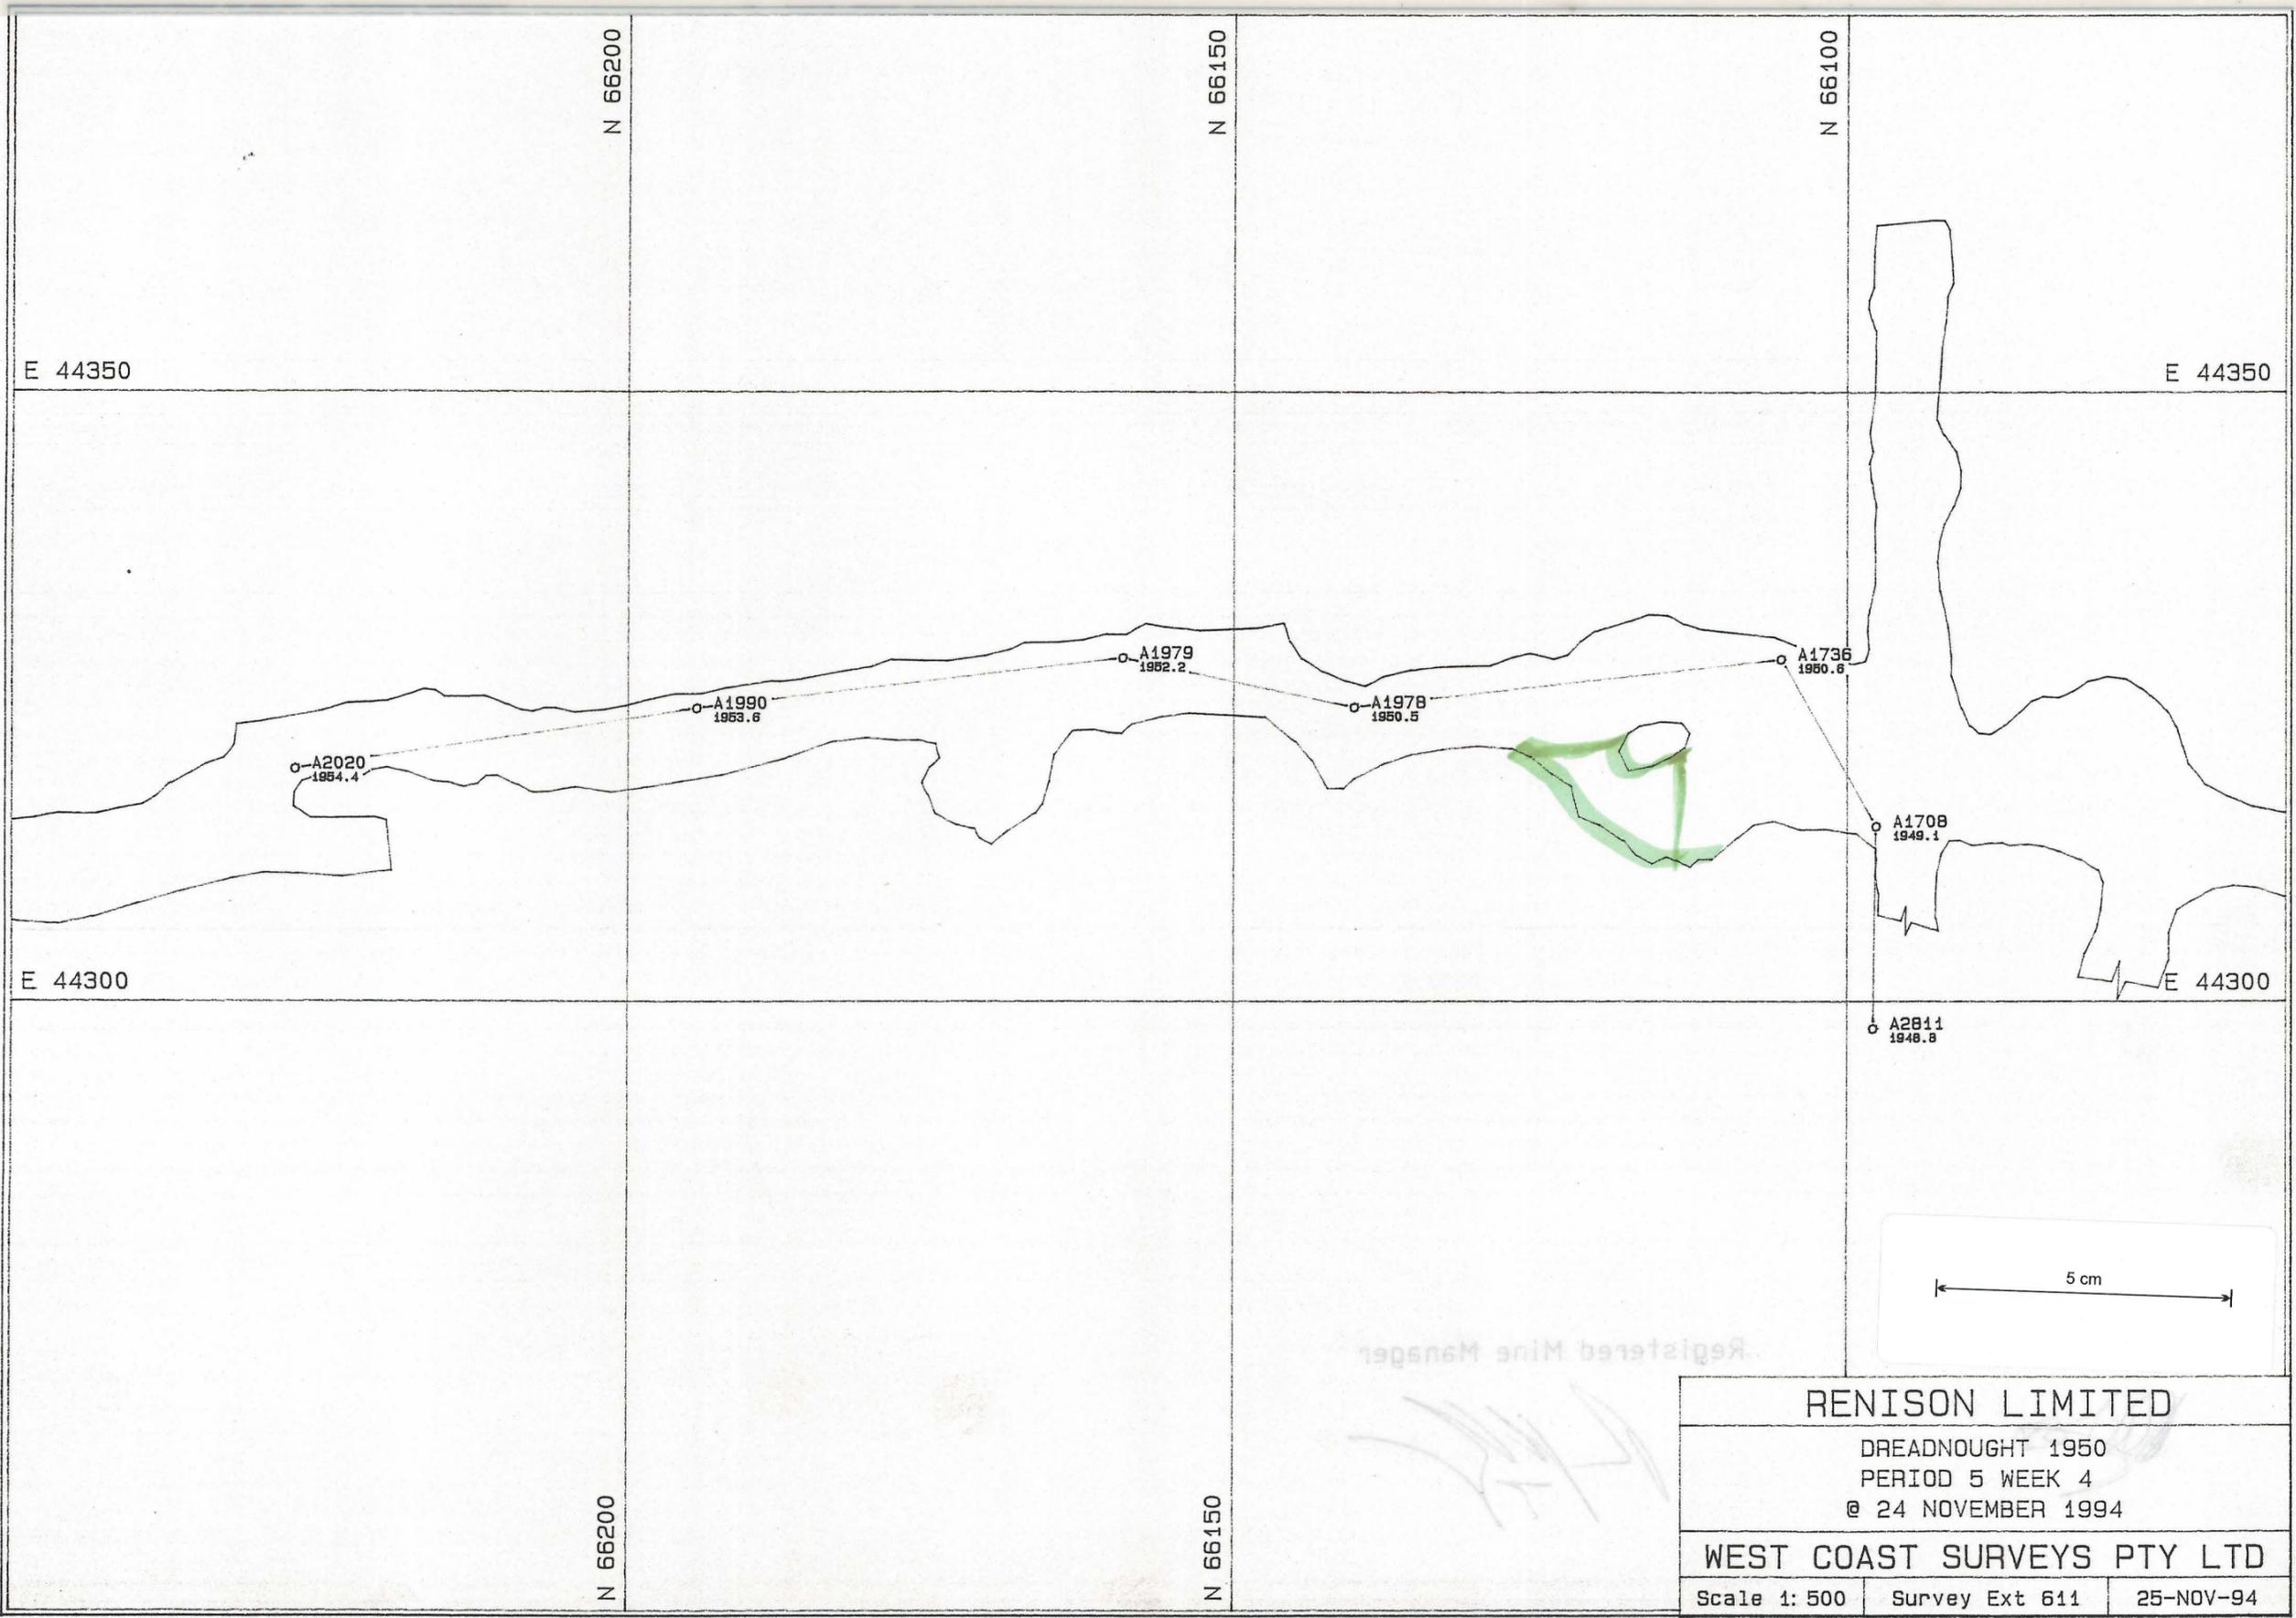

Registered Mine Manager

RENISON LIMITED

DREADNOUGHT 1950  
PERIOD 5 WEEK 4  
@ 24 NOVEMBER 1994

WEST COAST SURVEYS PTY LTD

Scale 1: 500    Survey Ext 611    25-NOV-94

DREADA, PF