


0376 - 178

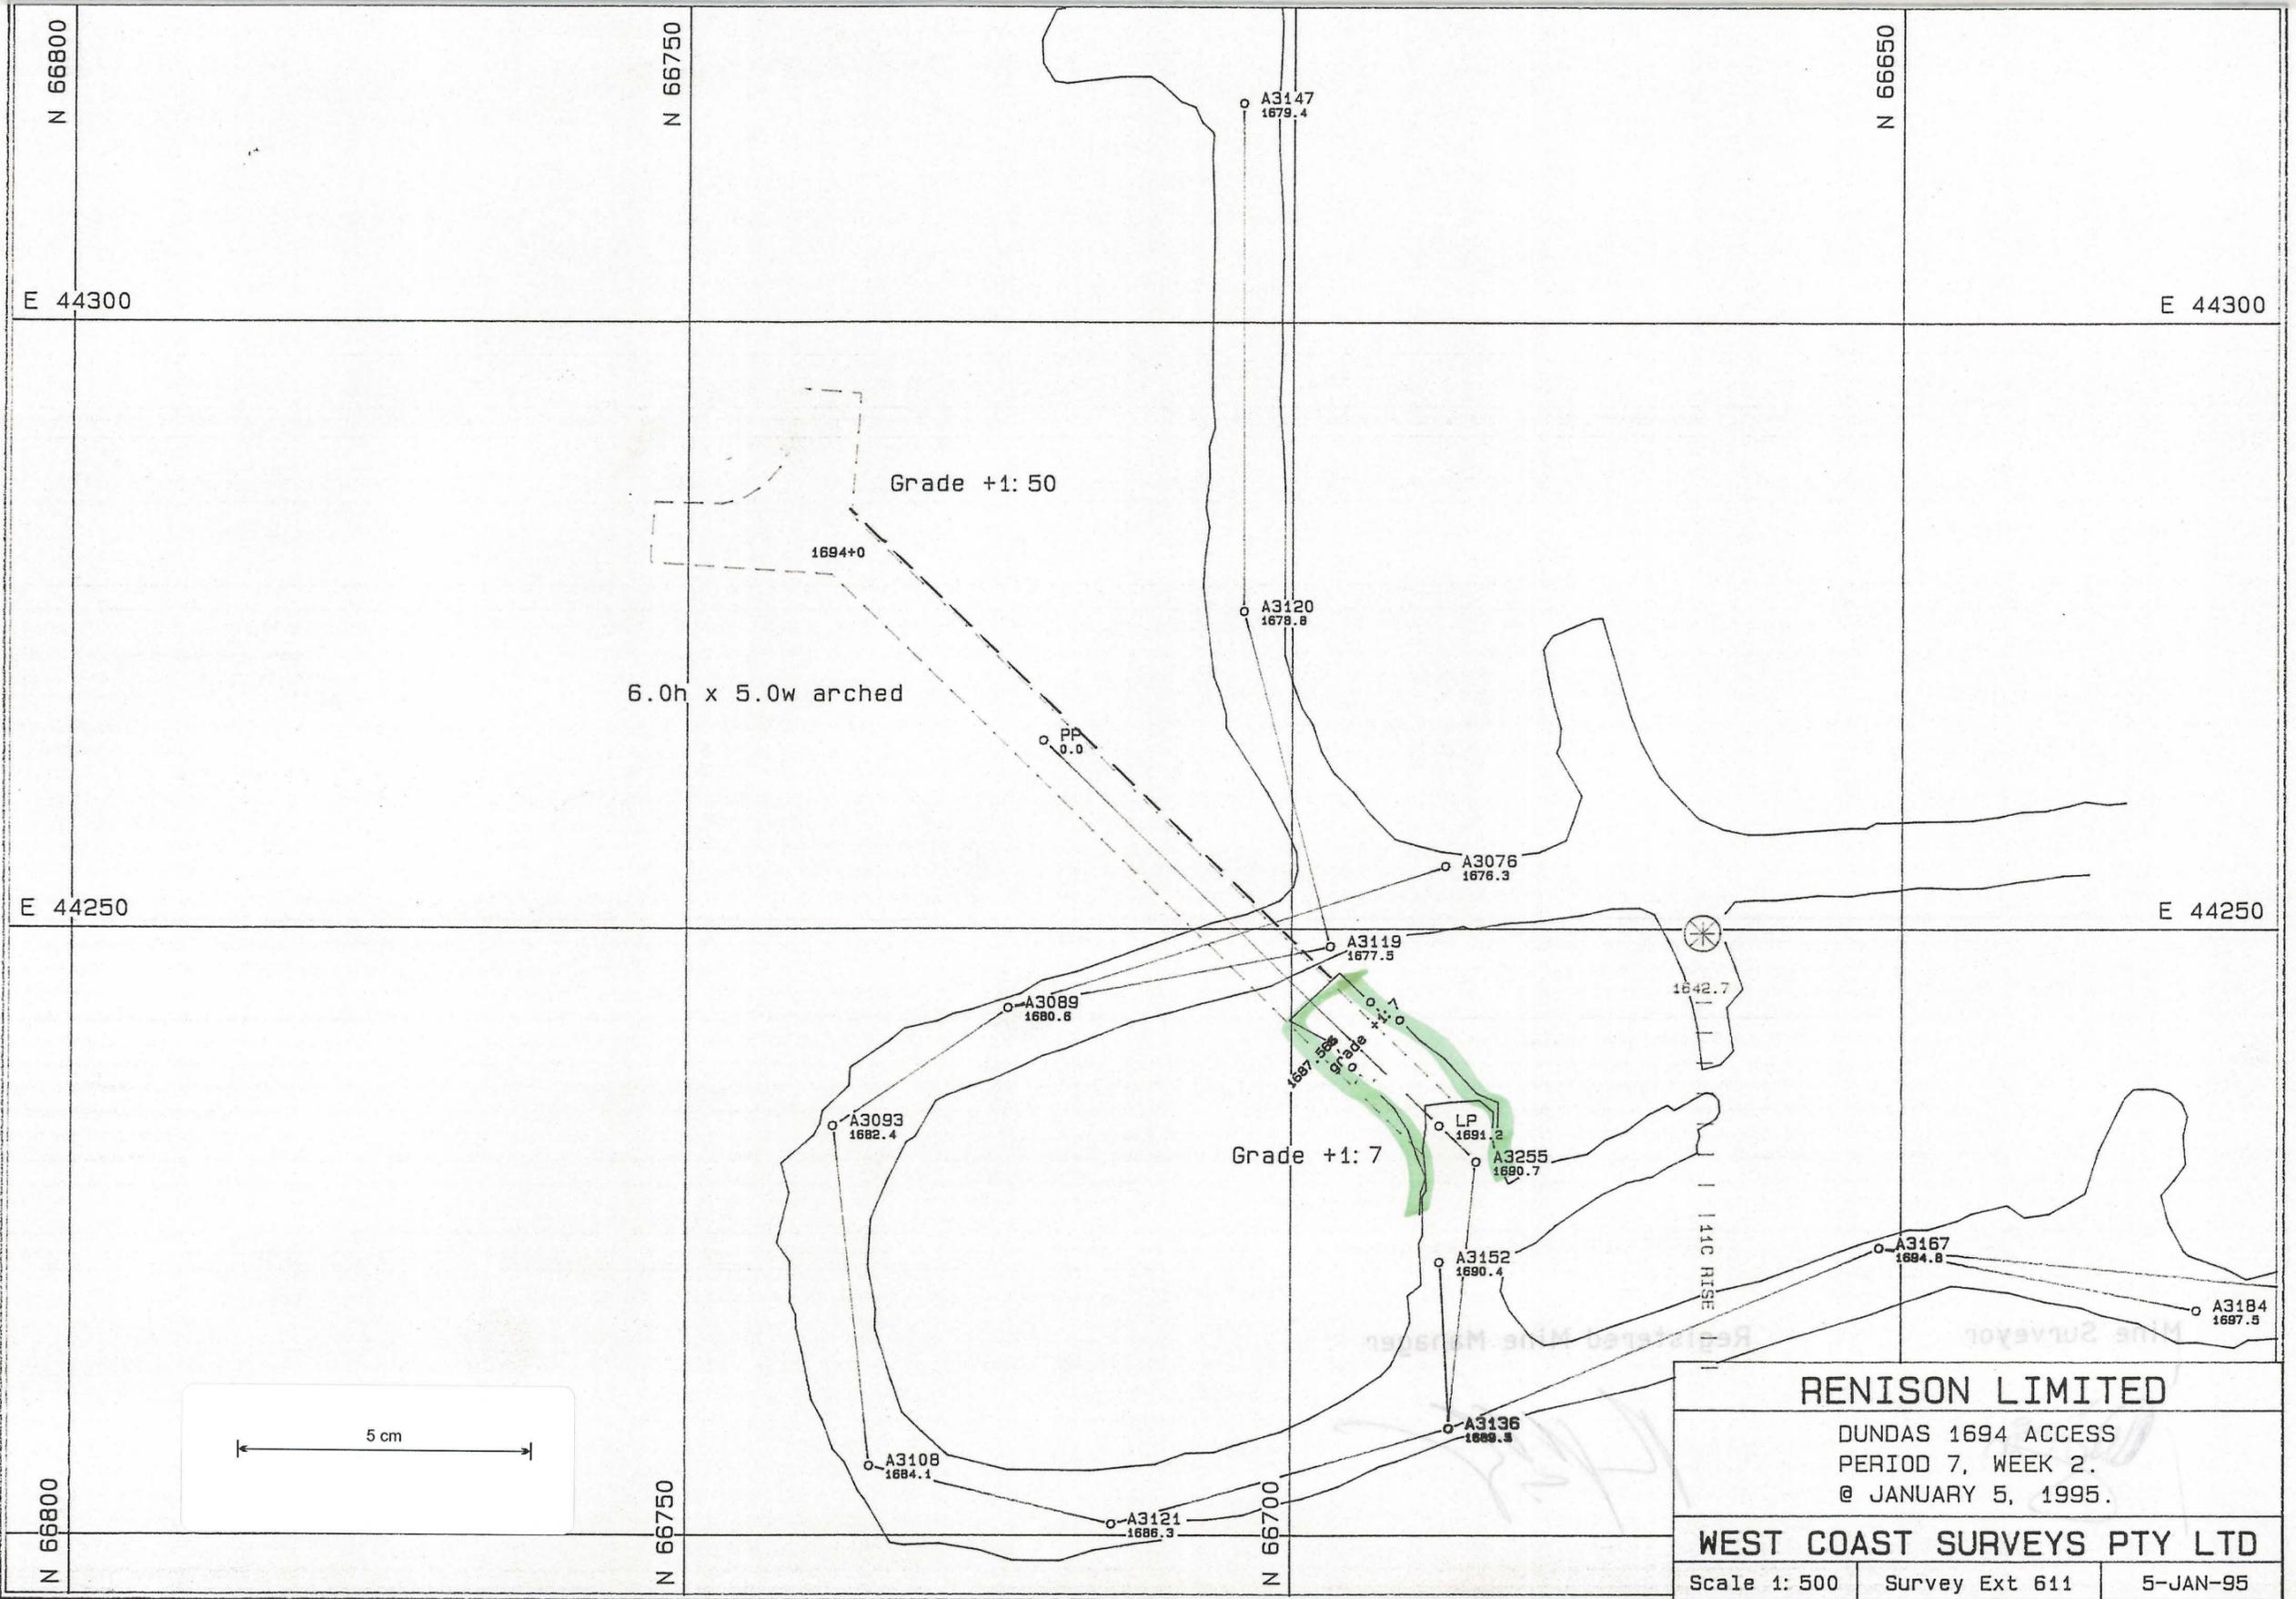

<b>RENISON LIMITED</b>		
DUNDAS 1694 ACCESS PERIOD 7, WEEK 2. @ JANUARY 5, 1995.		
<b>WEST COAST SURVEYS PTY LTD</b>		
Scale 1: 500	Survey Ext 611	5-JAN-95

DUNDAS .PF