


0376-179

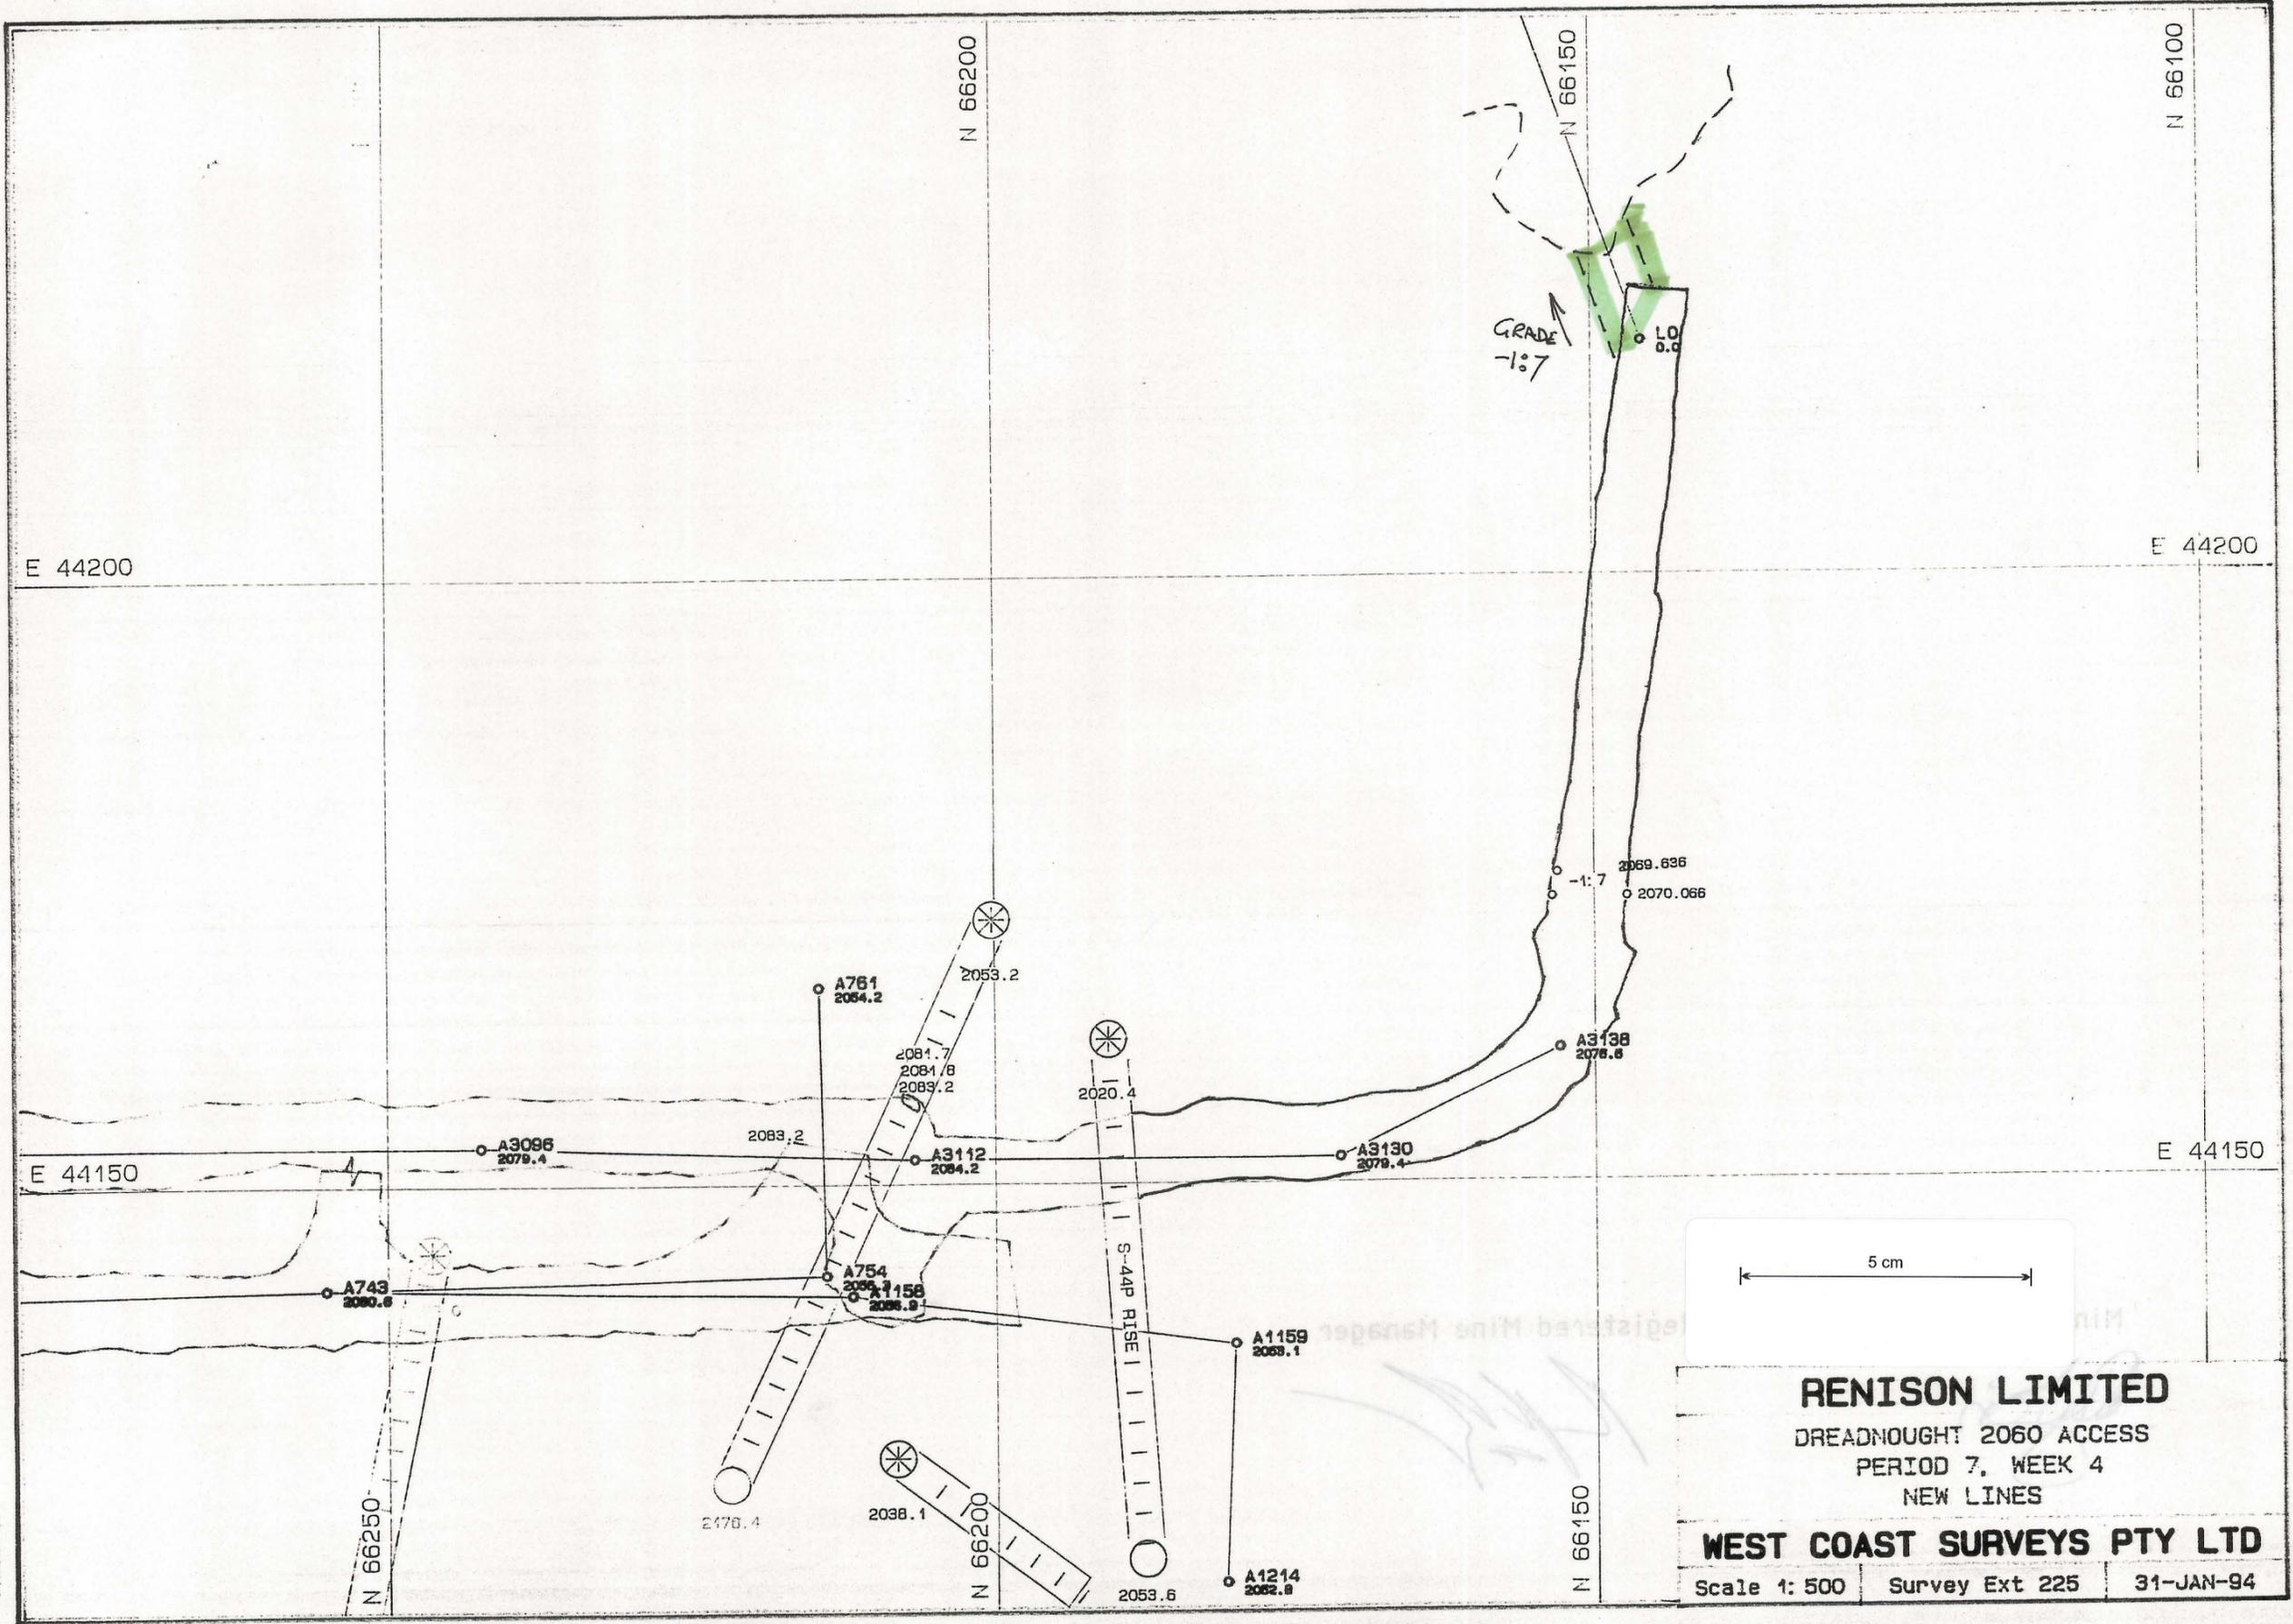

RENISON LIMITED
 DREADNOUGHT 2060 ACCESS
 PERIOD 7, WEEK 4
 NEW LINES

WEST COAST SURVEYS PTY LTD
 Scale 1: 500 | Survey Ext 225 | 31-JAN-94

DREADC.PF