
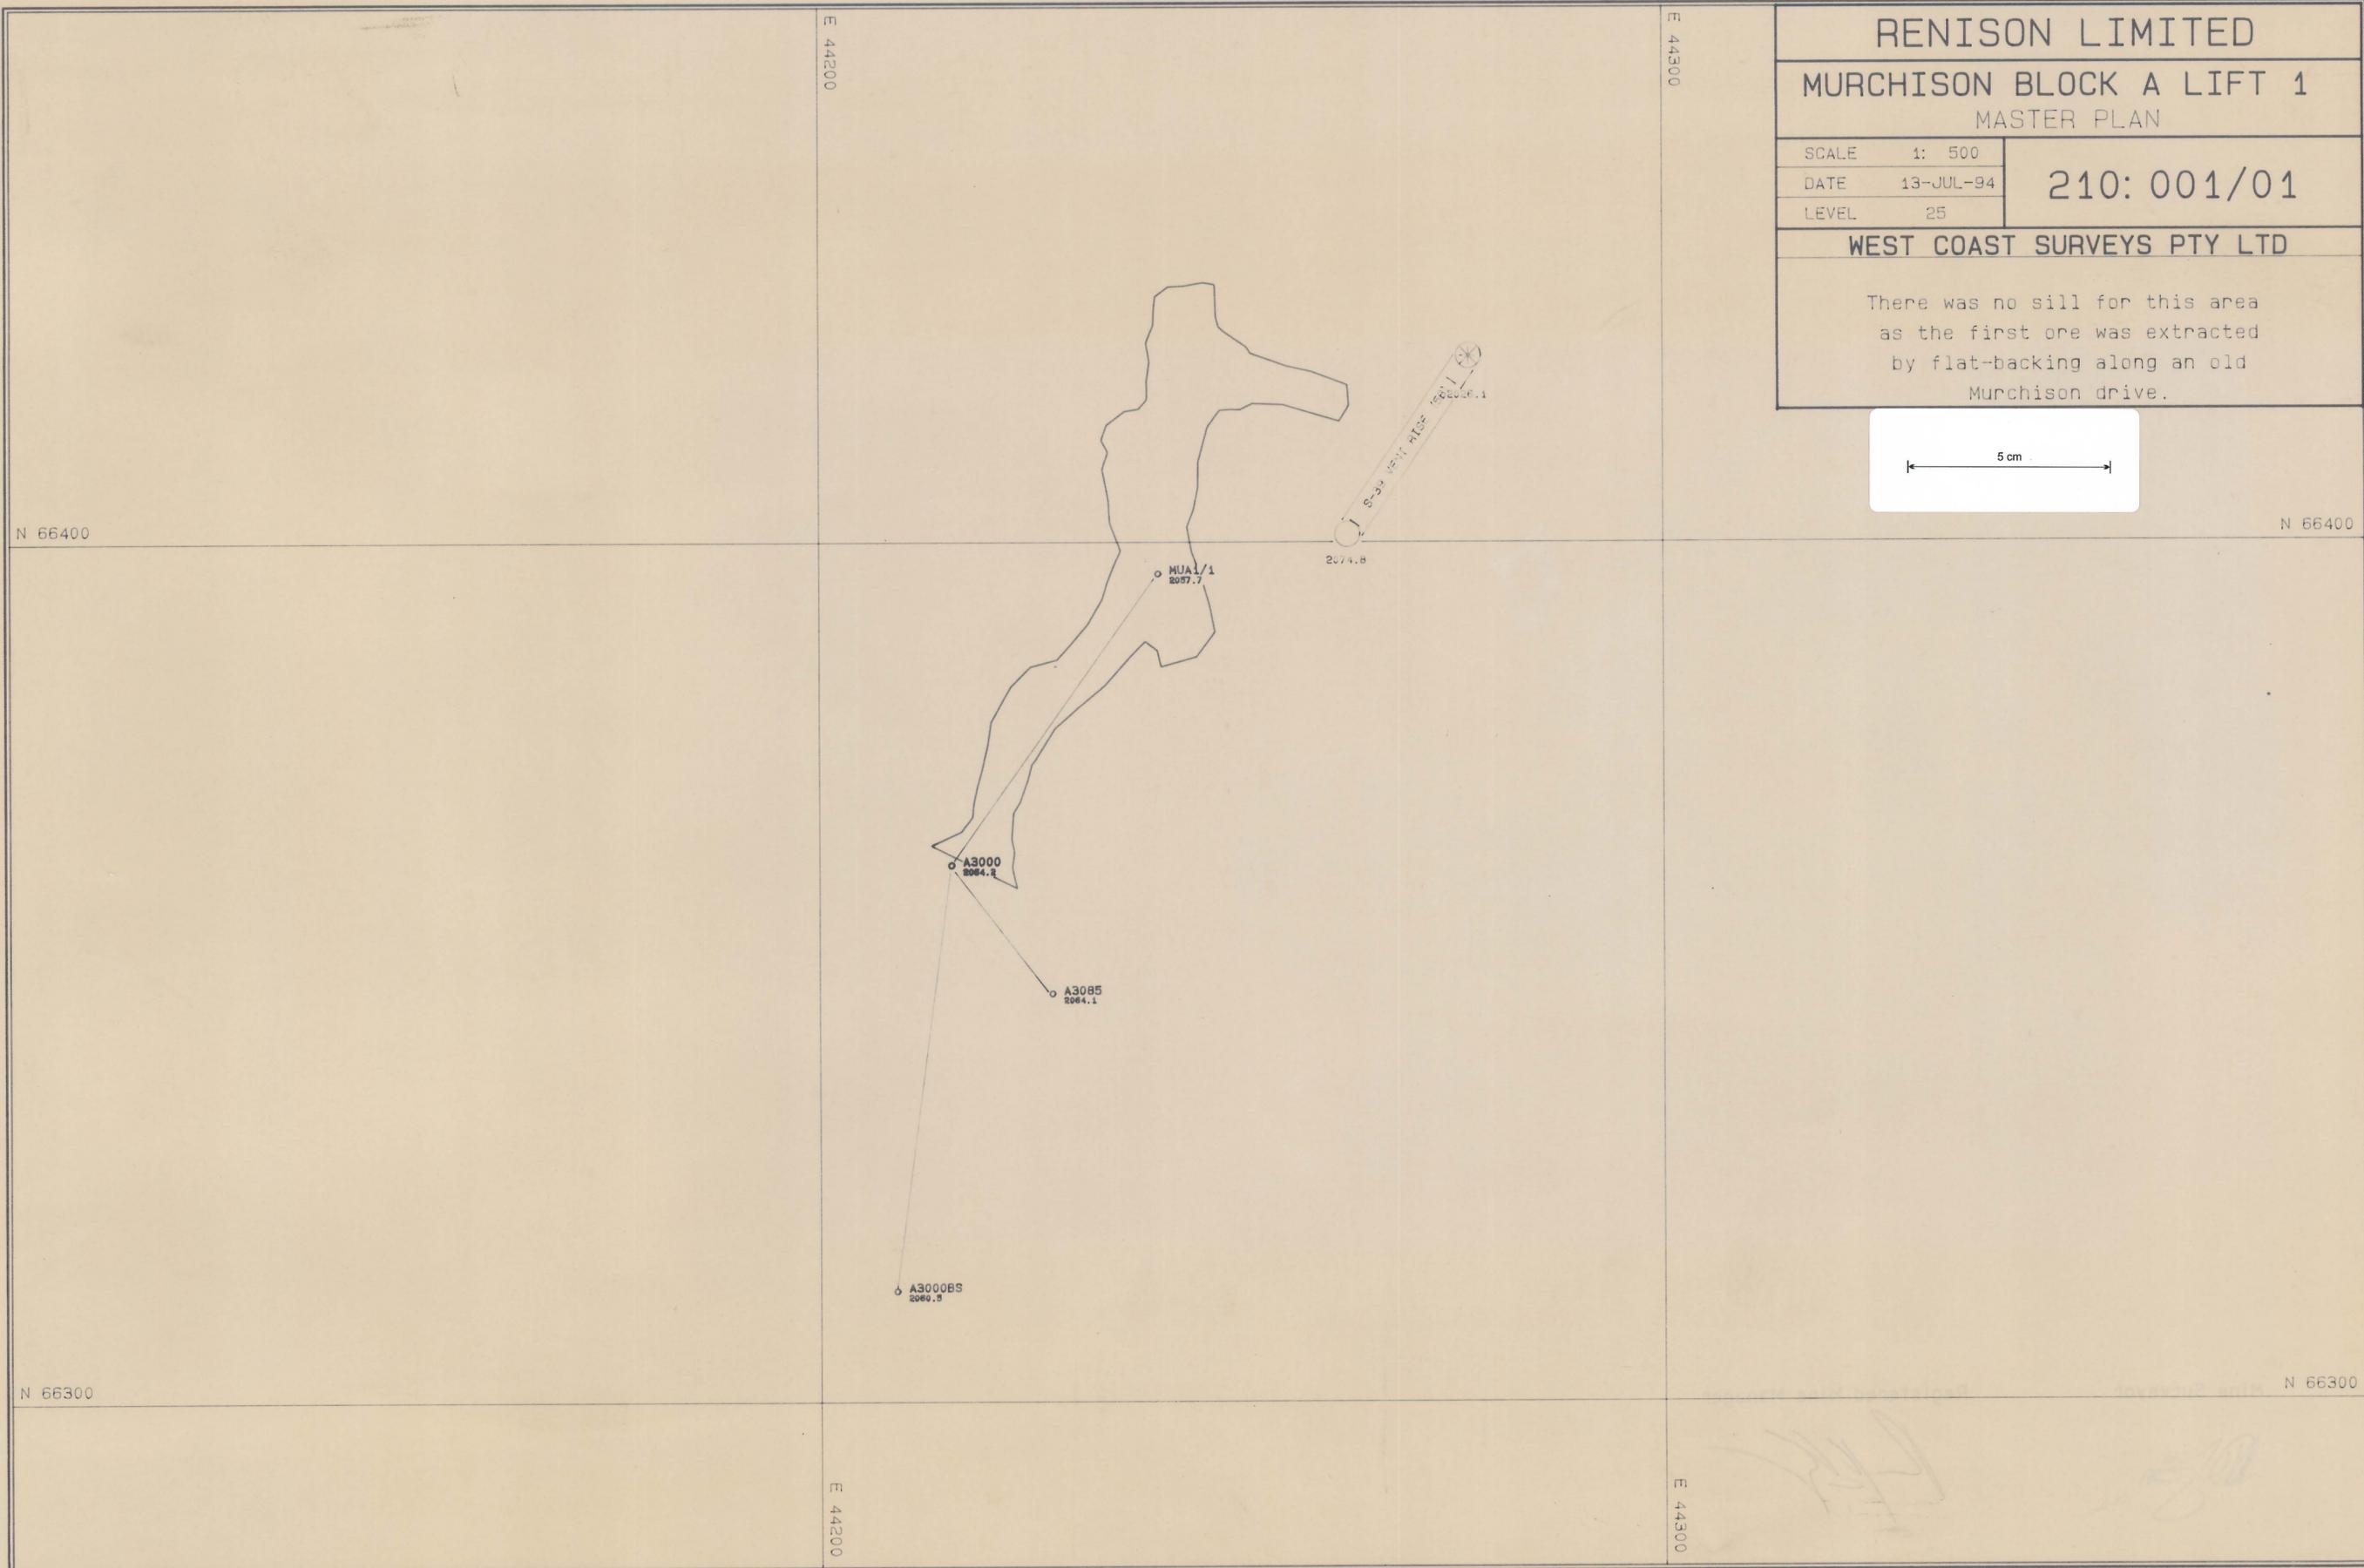


0376-180

RENISON LIMITED		
MURCHISON BLOCK A LIFT 1		
MASTER PLAN		
SCALE	1: 500	210: 001/01
DATE	13-JUL-94	
LEVEL	25	
WEST COAST SURVEYS PTY LTD		
<p>There was no sill for this area as the first ore was extracted by flat-backing along an old Murchison drive.</p>		

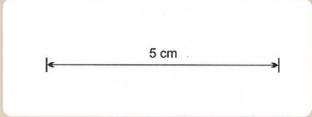

MASTEA.PF

MASTER PLAN