



0376 - 181

RENISON LIMITED
MURCHISON BLOCK A LIFT 2
 MASTER PLAN

SCALE	1: 500	210: 002/01
DATE	13-JUL-94	
LEVEL	25	

WEST COAST SURVEYS PTY LTD

Normal stoping lift.

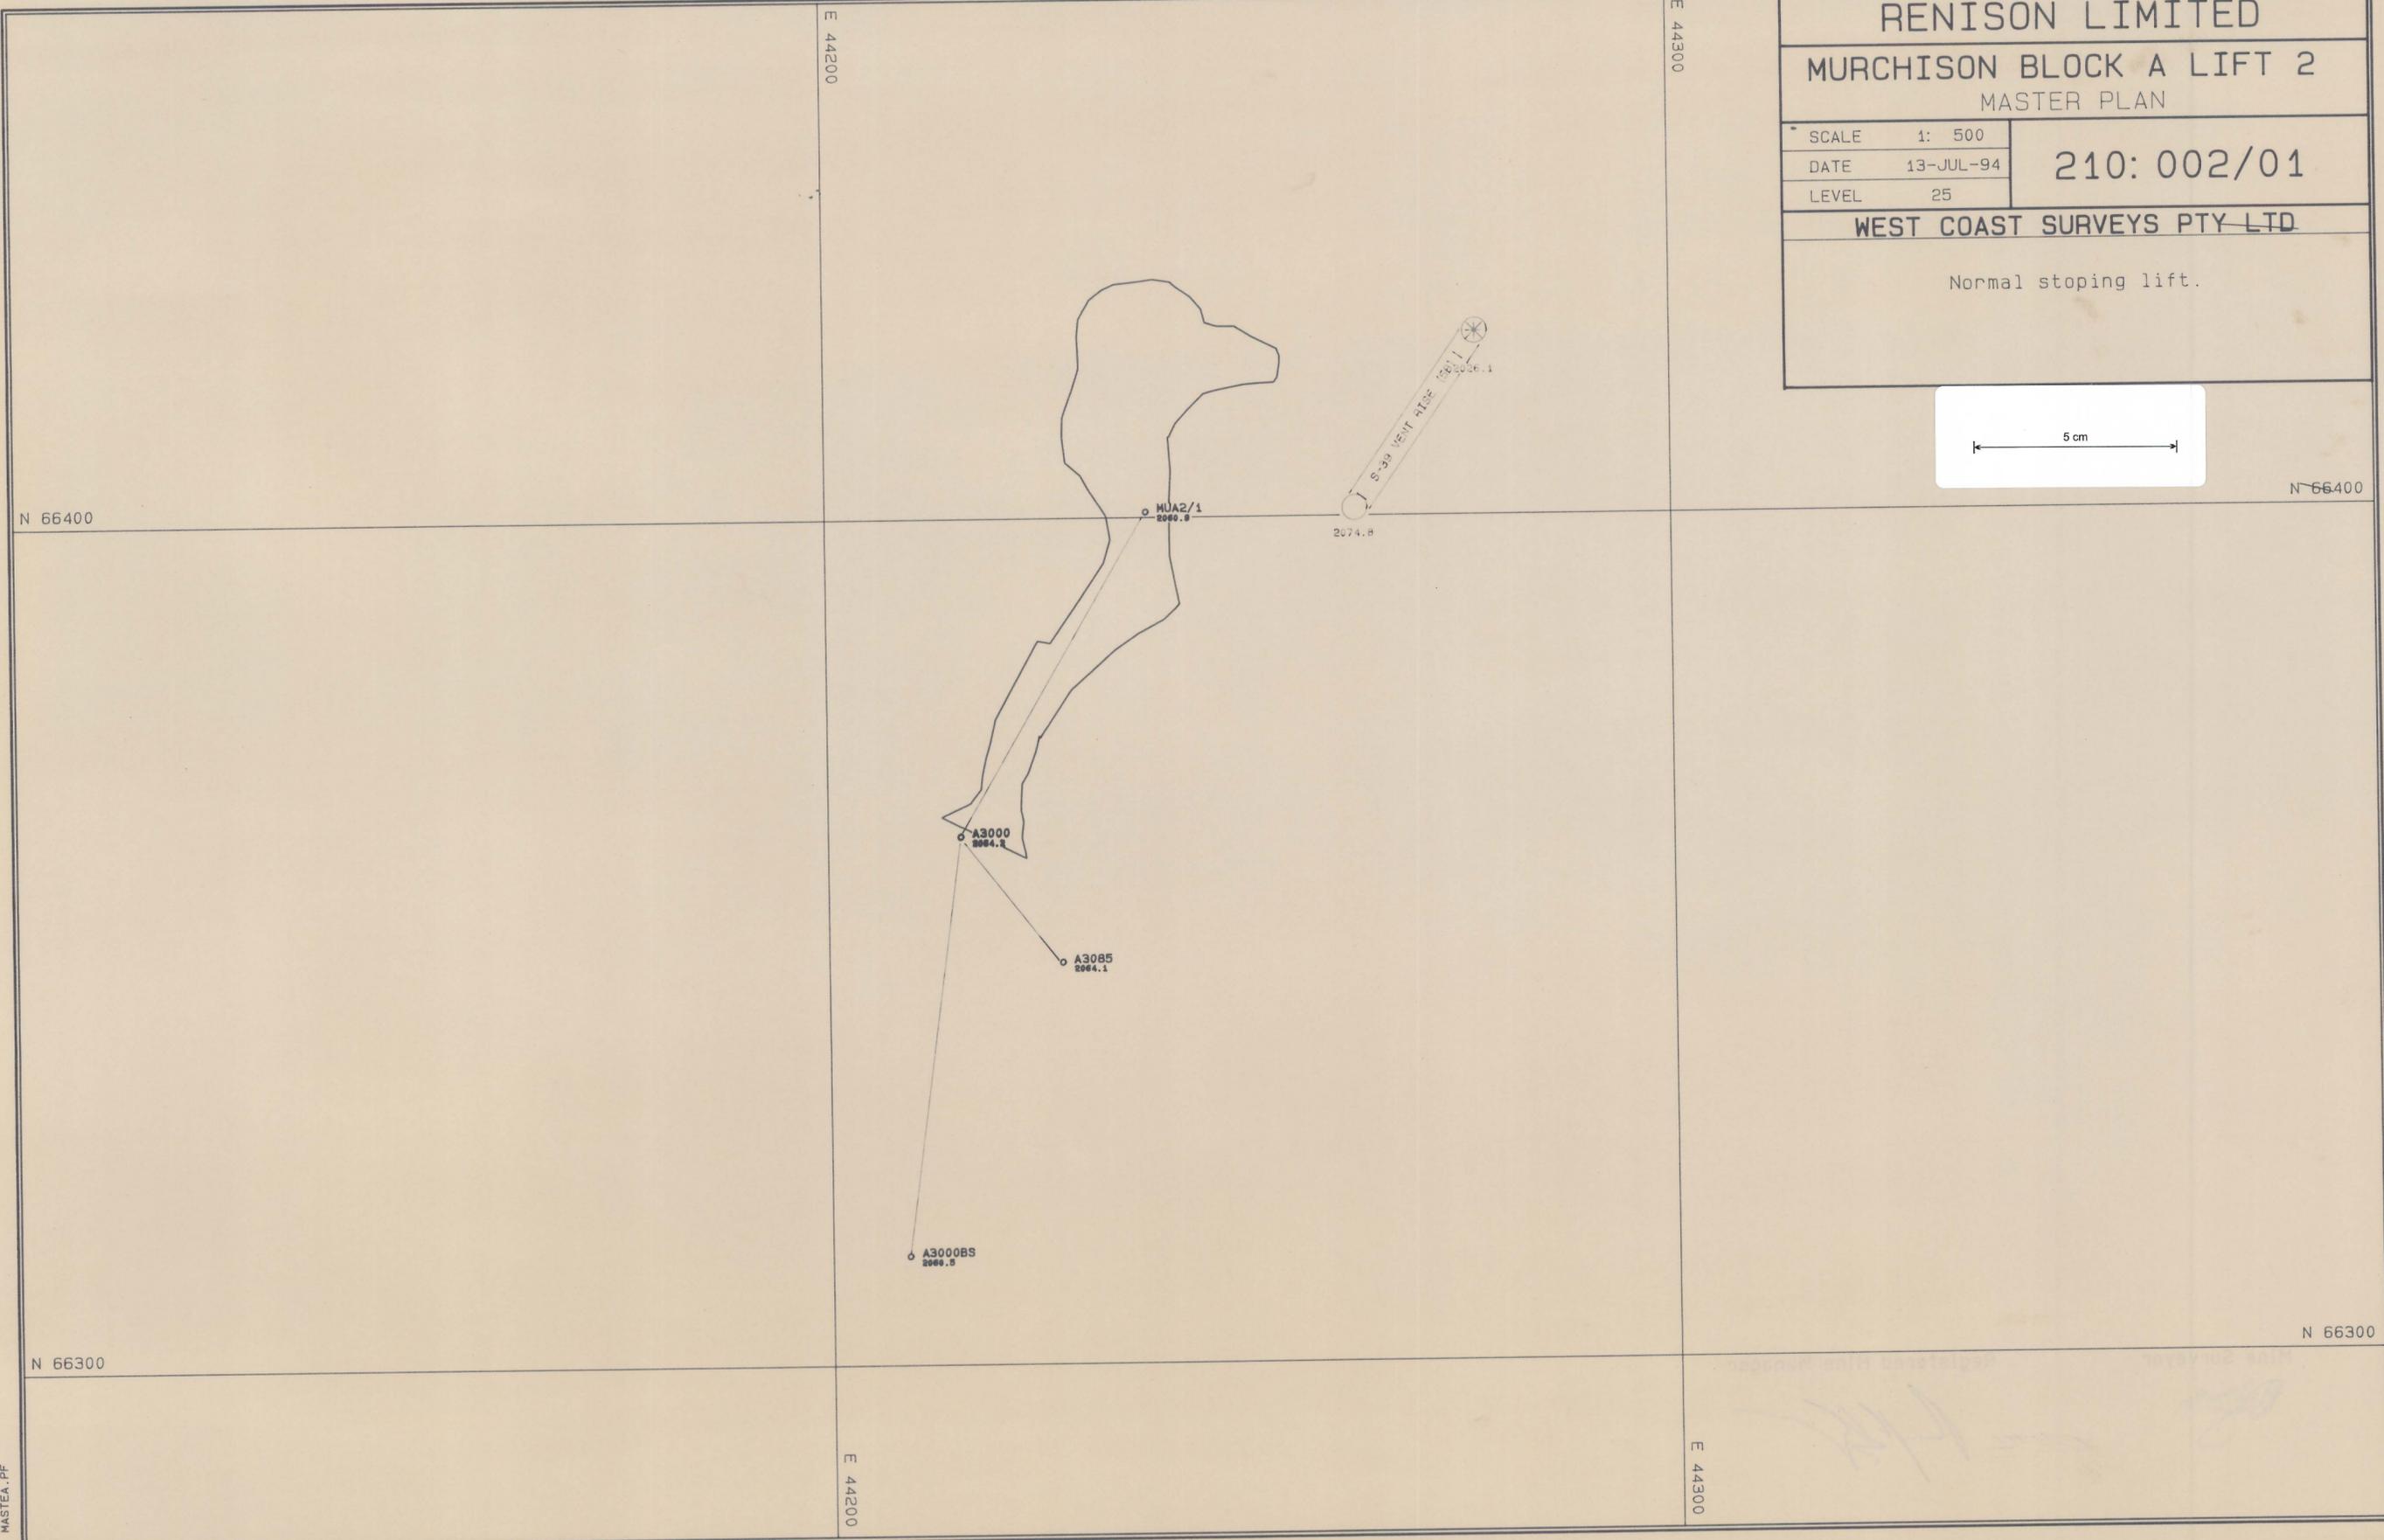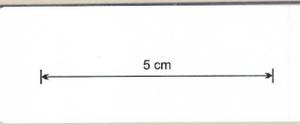

N 66400

N 66400

N 66300

N 66300

E 44200

E 44300

E 44200

E 44300

MASTEA.PF

210: 002/01