

0376-184

RENISON LIMITED

ELDON 2 SILL

MASTER PLAN



SCALE 1: 500

DATE 16-AUG-94

LEVEL 22

211: 000/01

WEST COAST SURVEYS PTY LTD

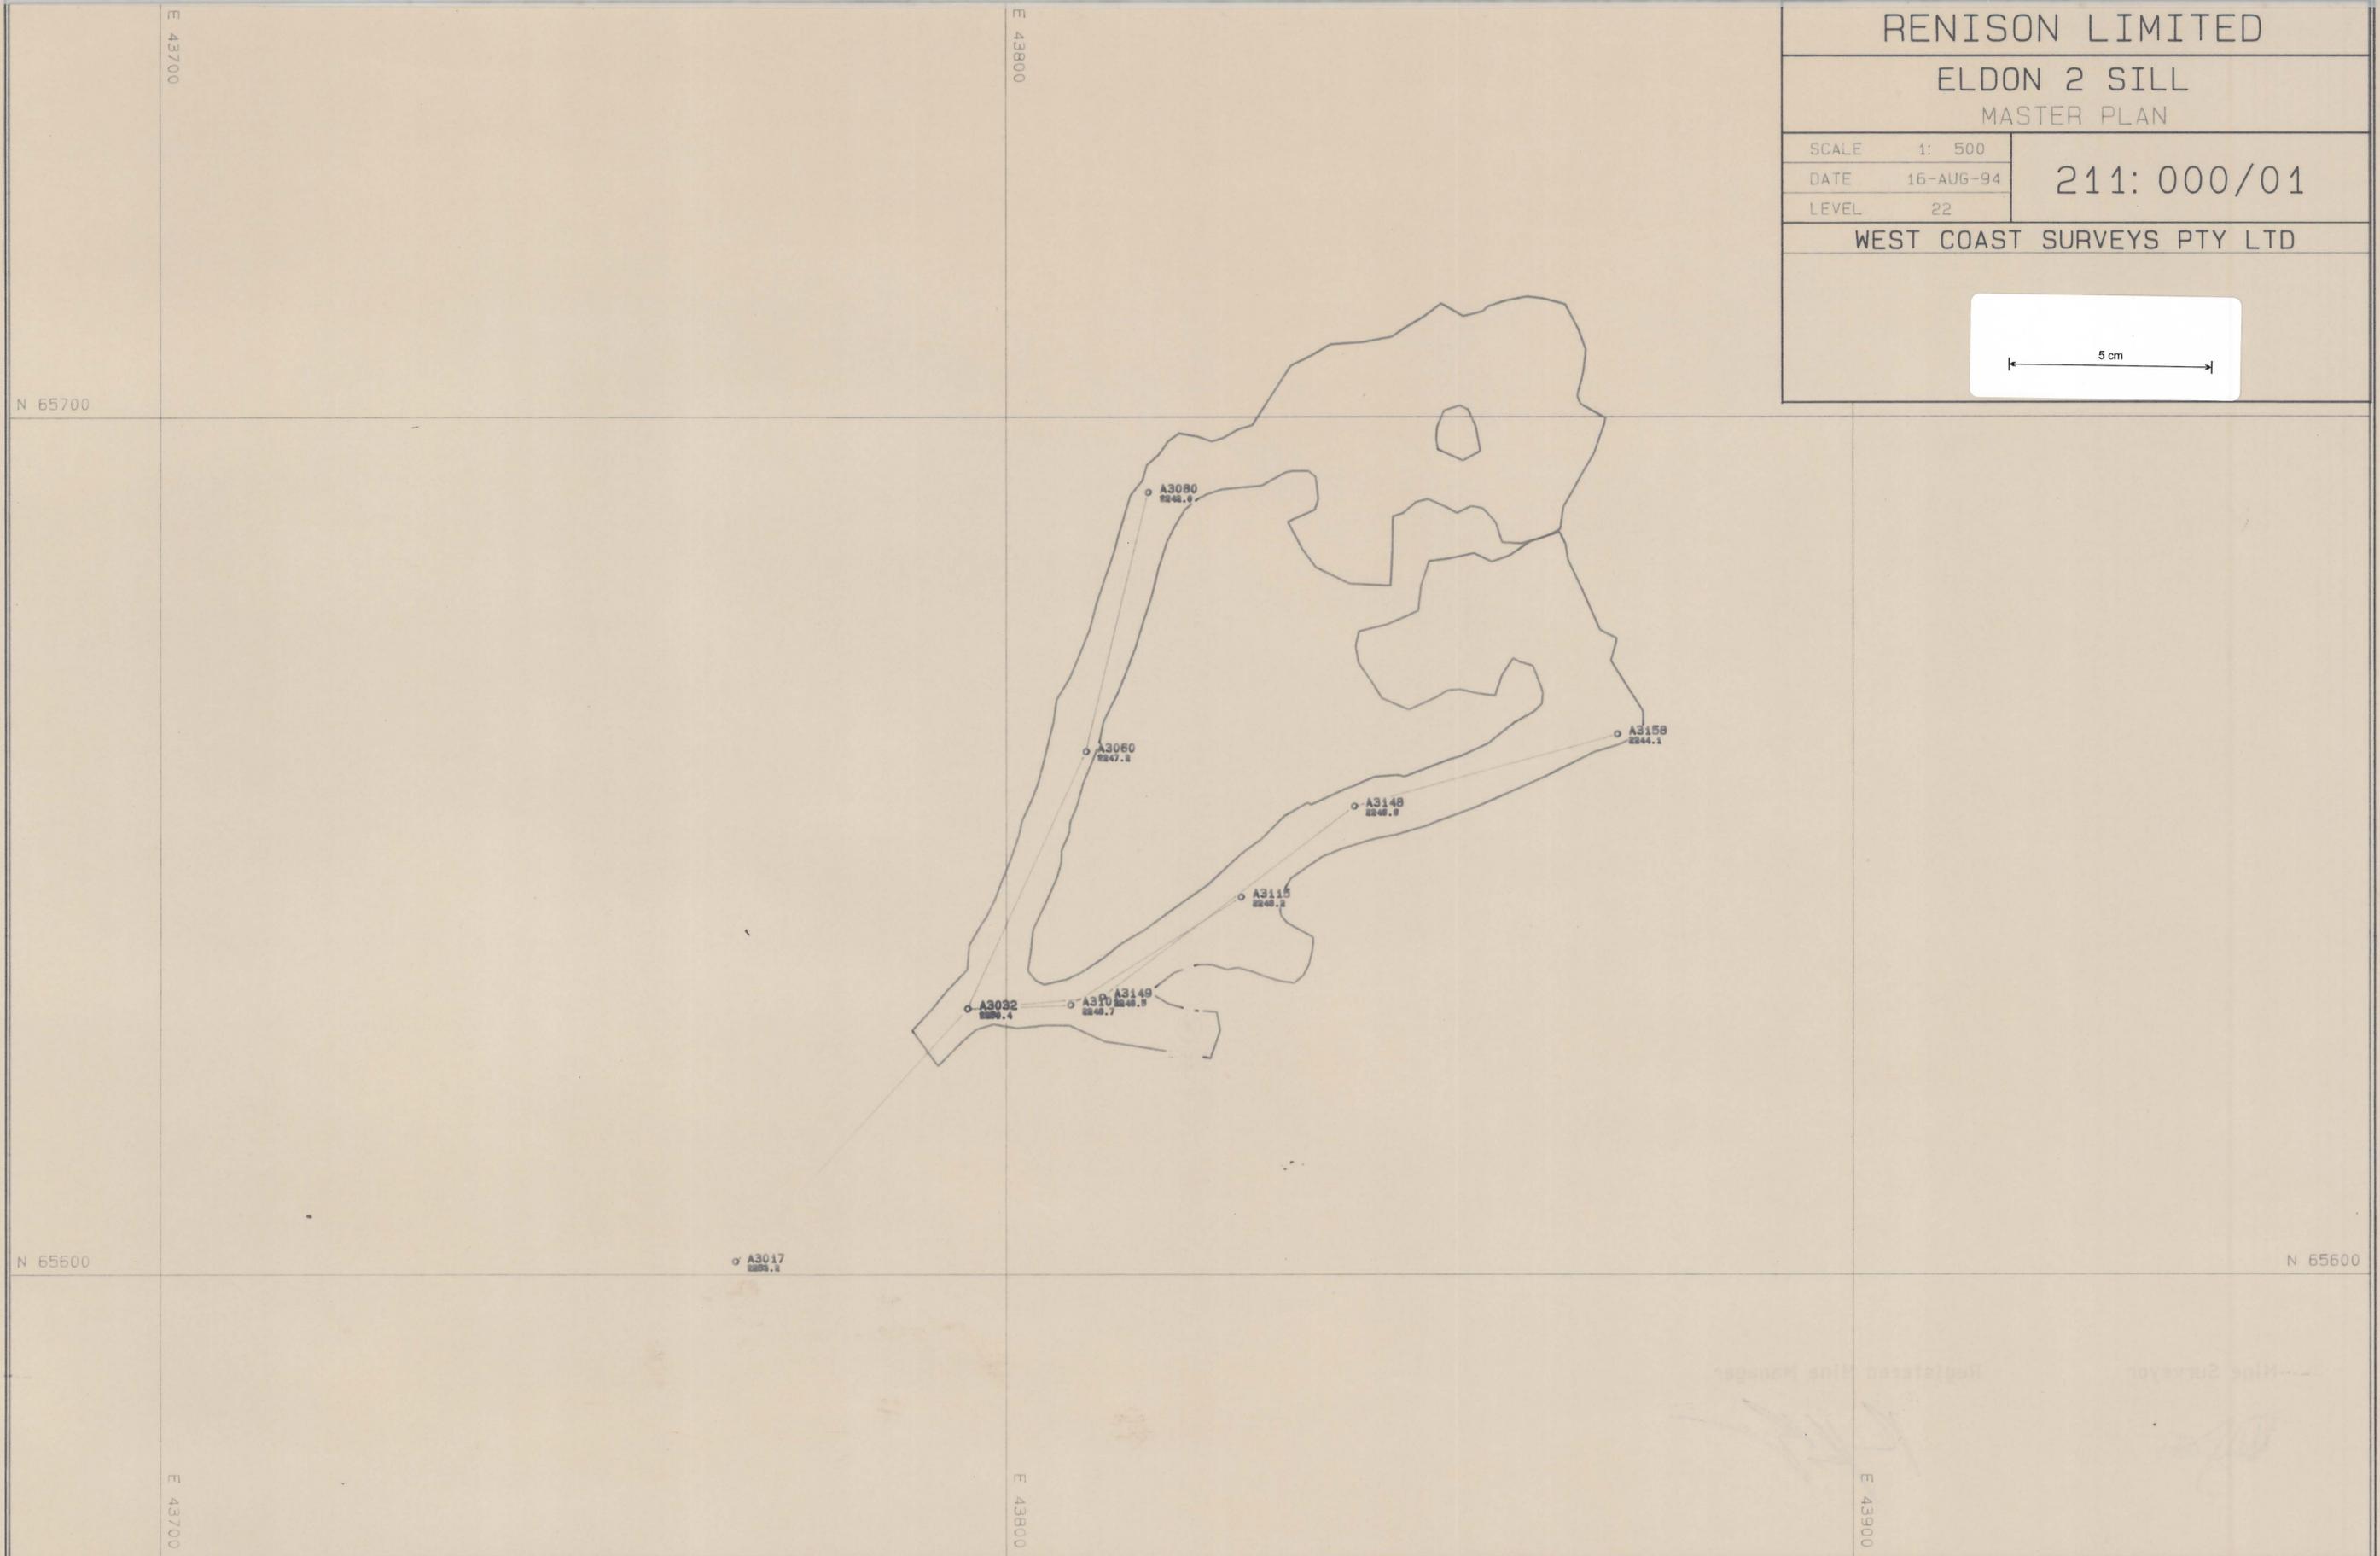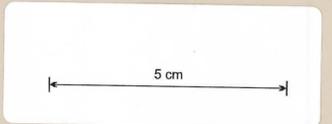

MASTEAF.PF