

0376-187

RENISON LIMITED



SLIGO 3 LIFT 1 MASTER PLAN

SCALE	1: 500
DATE	13-JUL-94
LEVEL	38

209: 001/1

WEST COAST SURVEYS PTY LTD

NORMAL CUT & FILL LIFT
ACCESS FILLING COMPLETED BY
INITIAL WASTE FLAT-BACKING

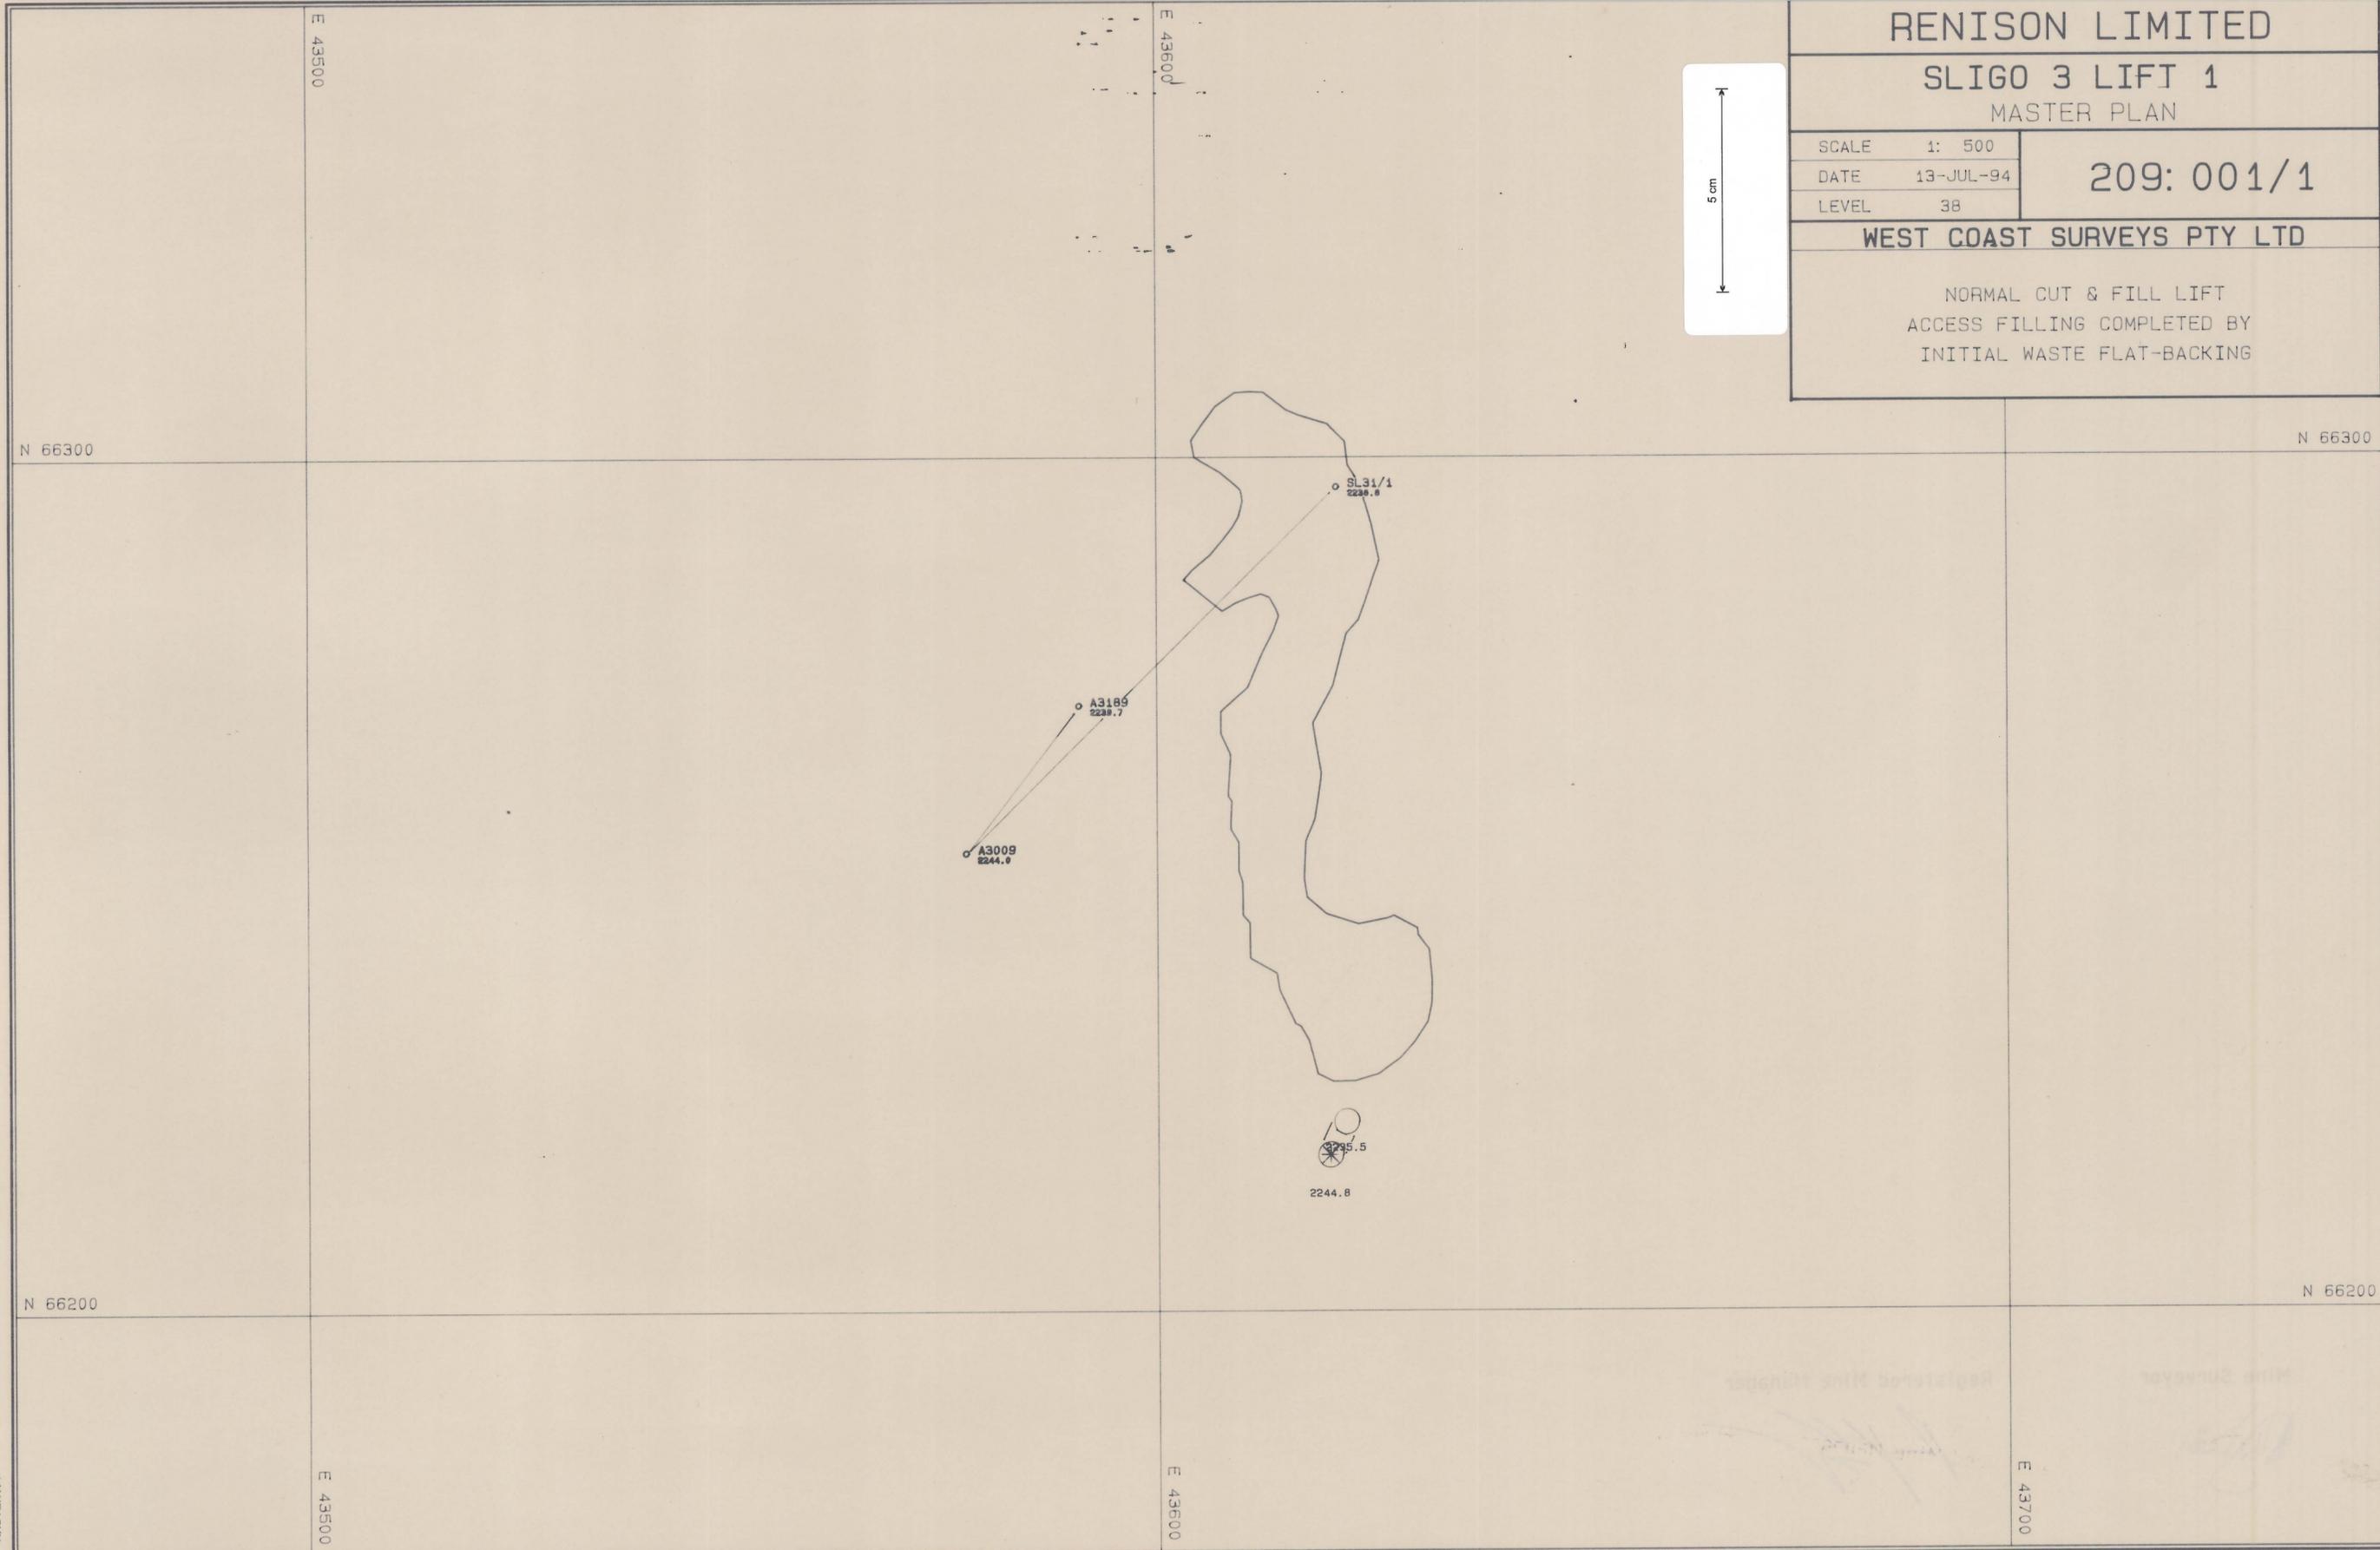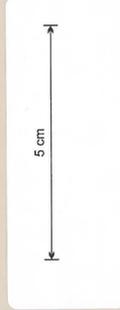

MASTEIA.PF