

0376 - 193



RENISON LIMITED
ENVELOPE 1885 SILL
MASTER

SCALE 1: 500
DATE 29-OCT-94
LEVEL 185

212: 000/01

WEST COAST SURVEYS PTY LTD

The sill lay dormant for awhile before re-working. The south end was then benched & filled before normal filling was completed.

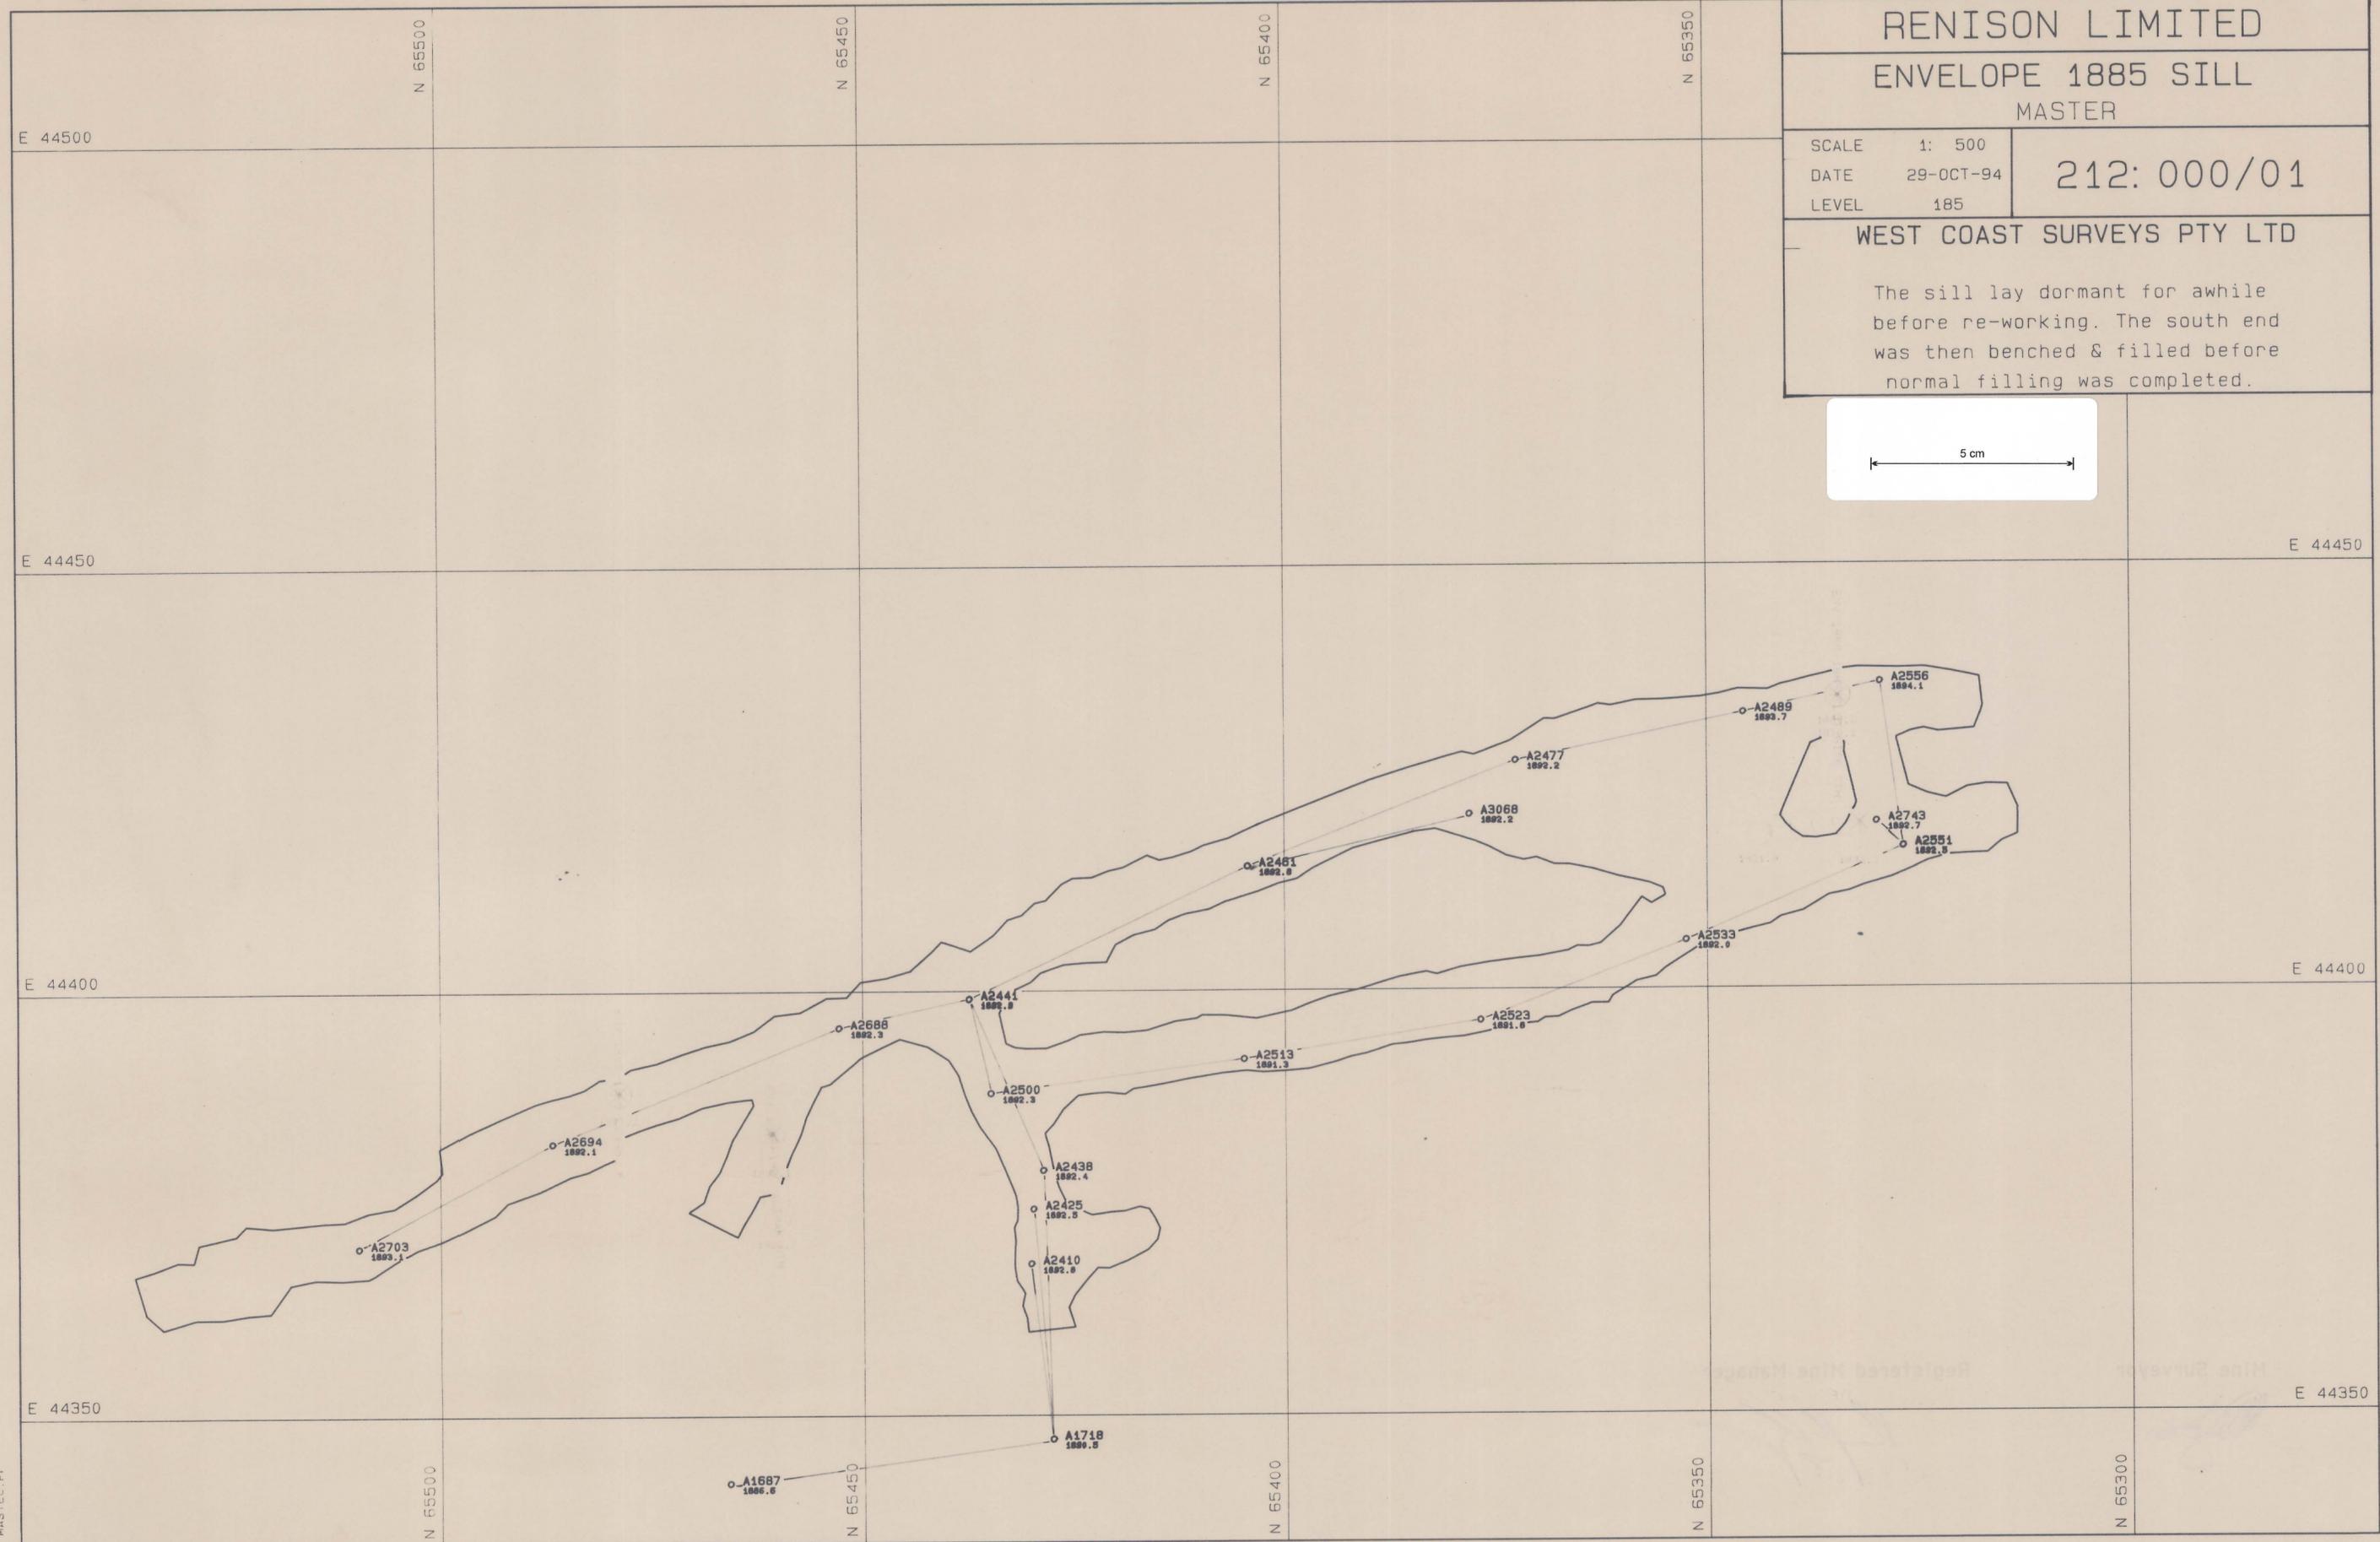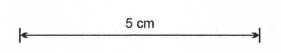

MASTEC.PF