

0376-194

RENISON LIMITED


Federal 2060 Sill
MASTER PLAN

SCALE 1: 500
DATE 6-NOV-94
LEVEL 206

213: 000/01

WEST COAST SURVEYS PTY LTD

5 cm

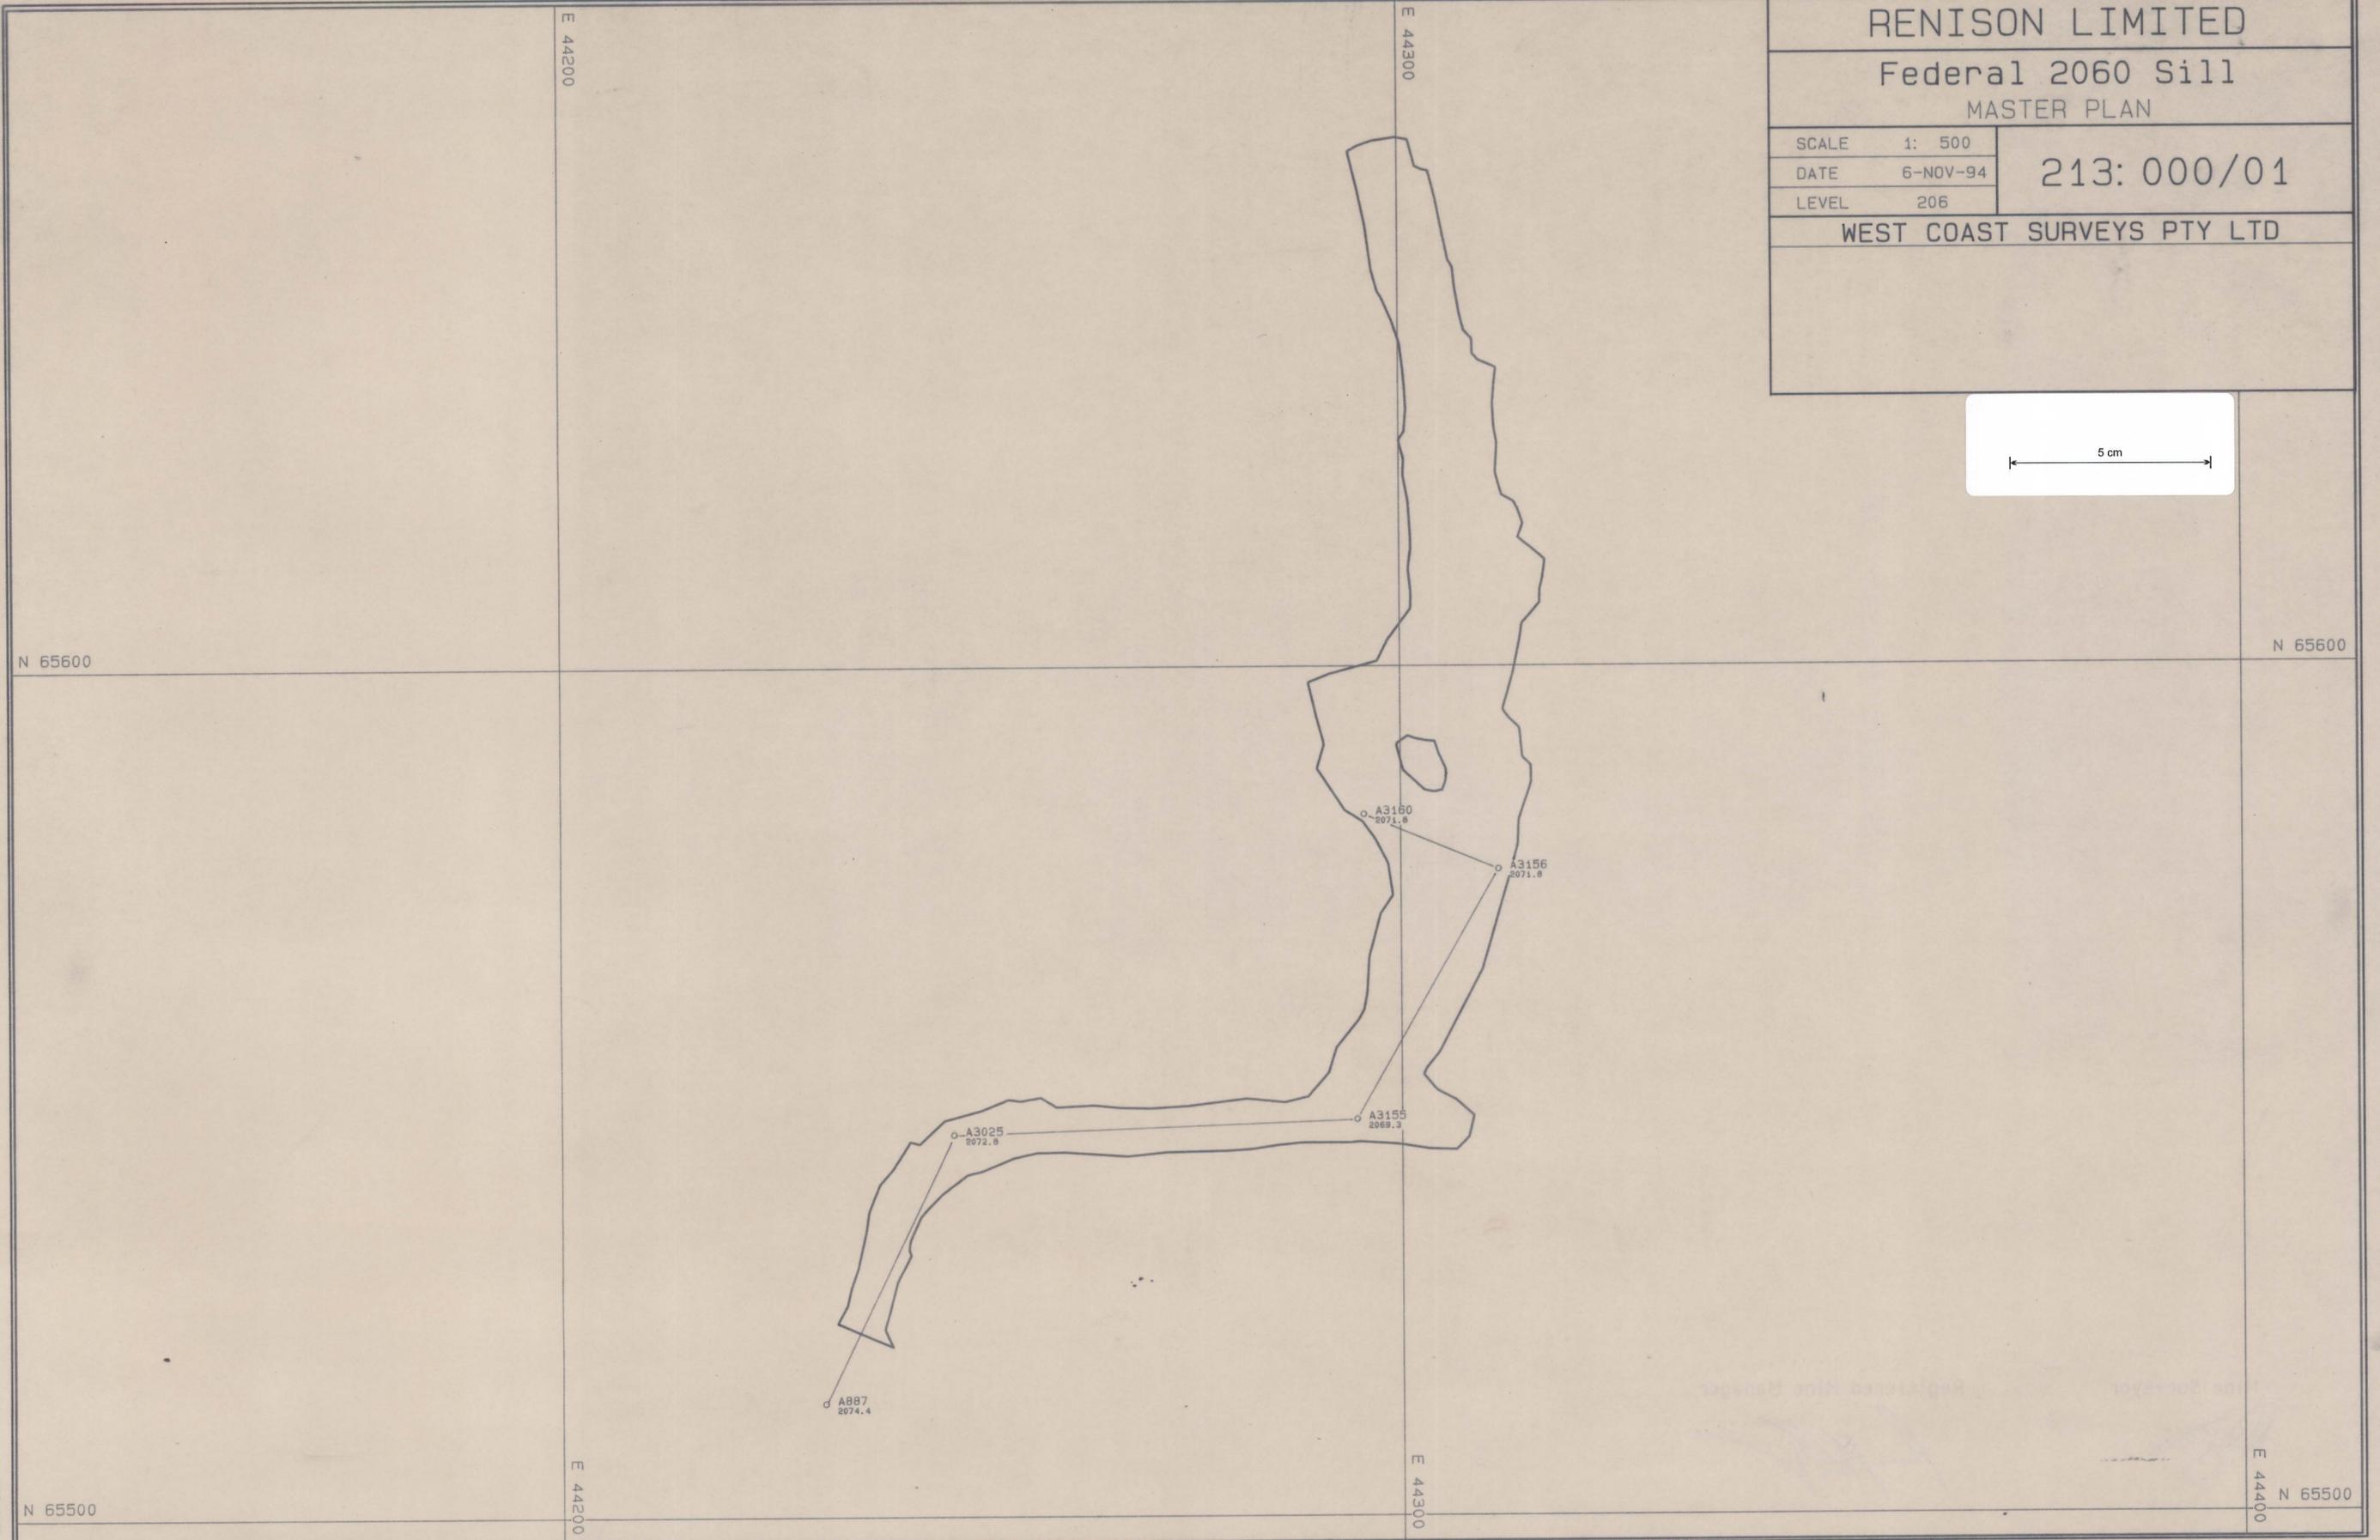

MASTEAF.PF

N 65500

E 44200

E 44300

E 44400

N 65500