

0376 - 198

RENISON LIMITED

ROMULUS 1900 LIFT 2
MASTER PLAN

SCALE 1: 500

DATE 12-APR-94


LEVEL

206: 002/01

WEST COAST SURVEYS PTY LTD

5 cm

0376-198

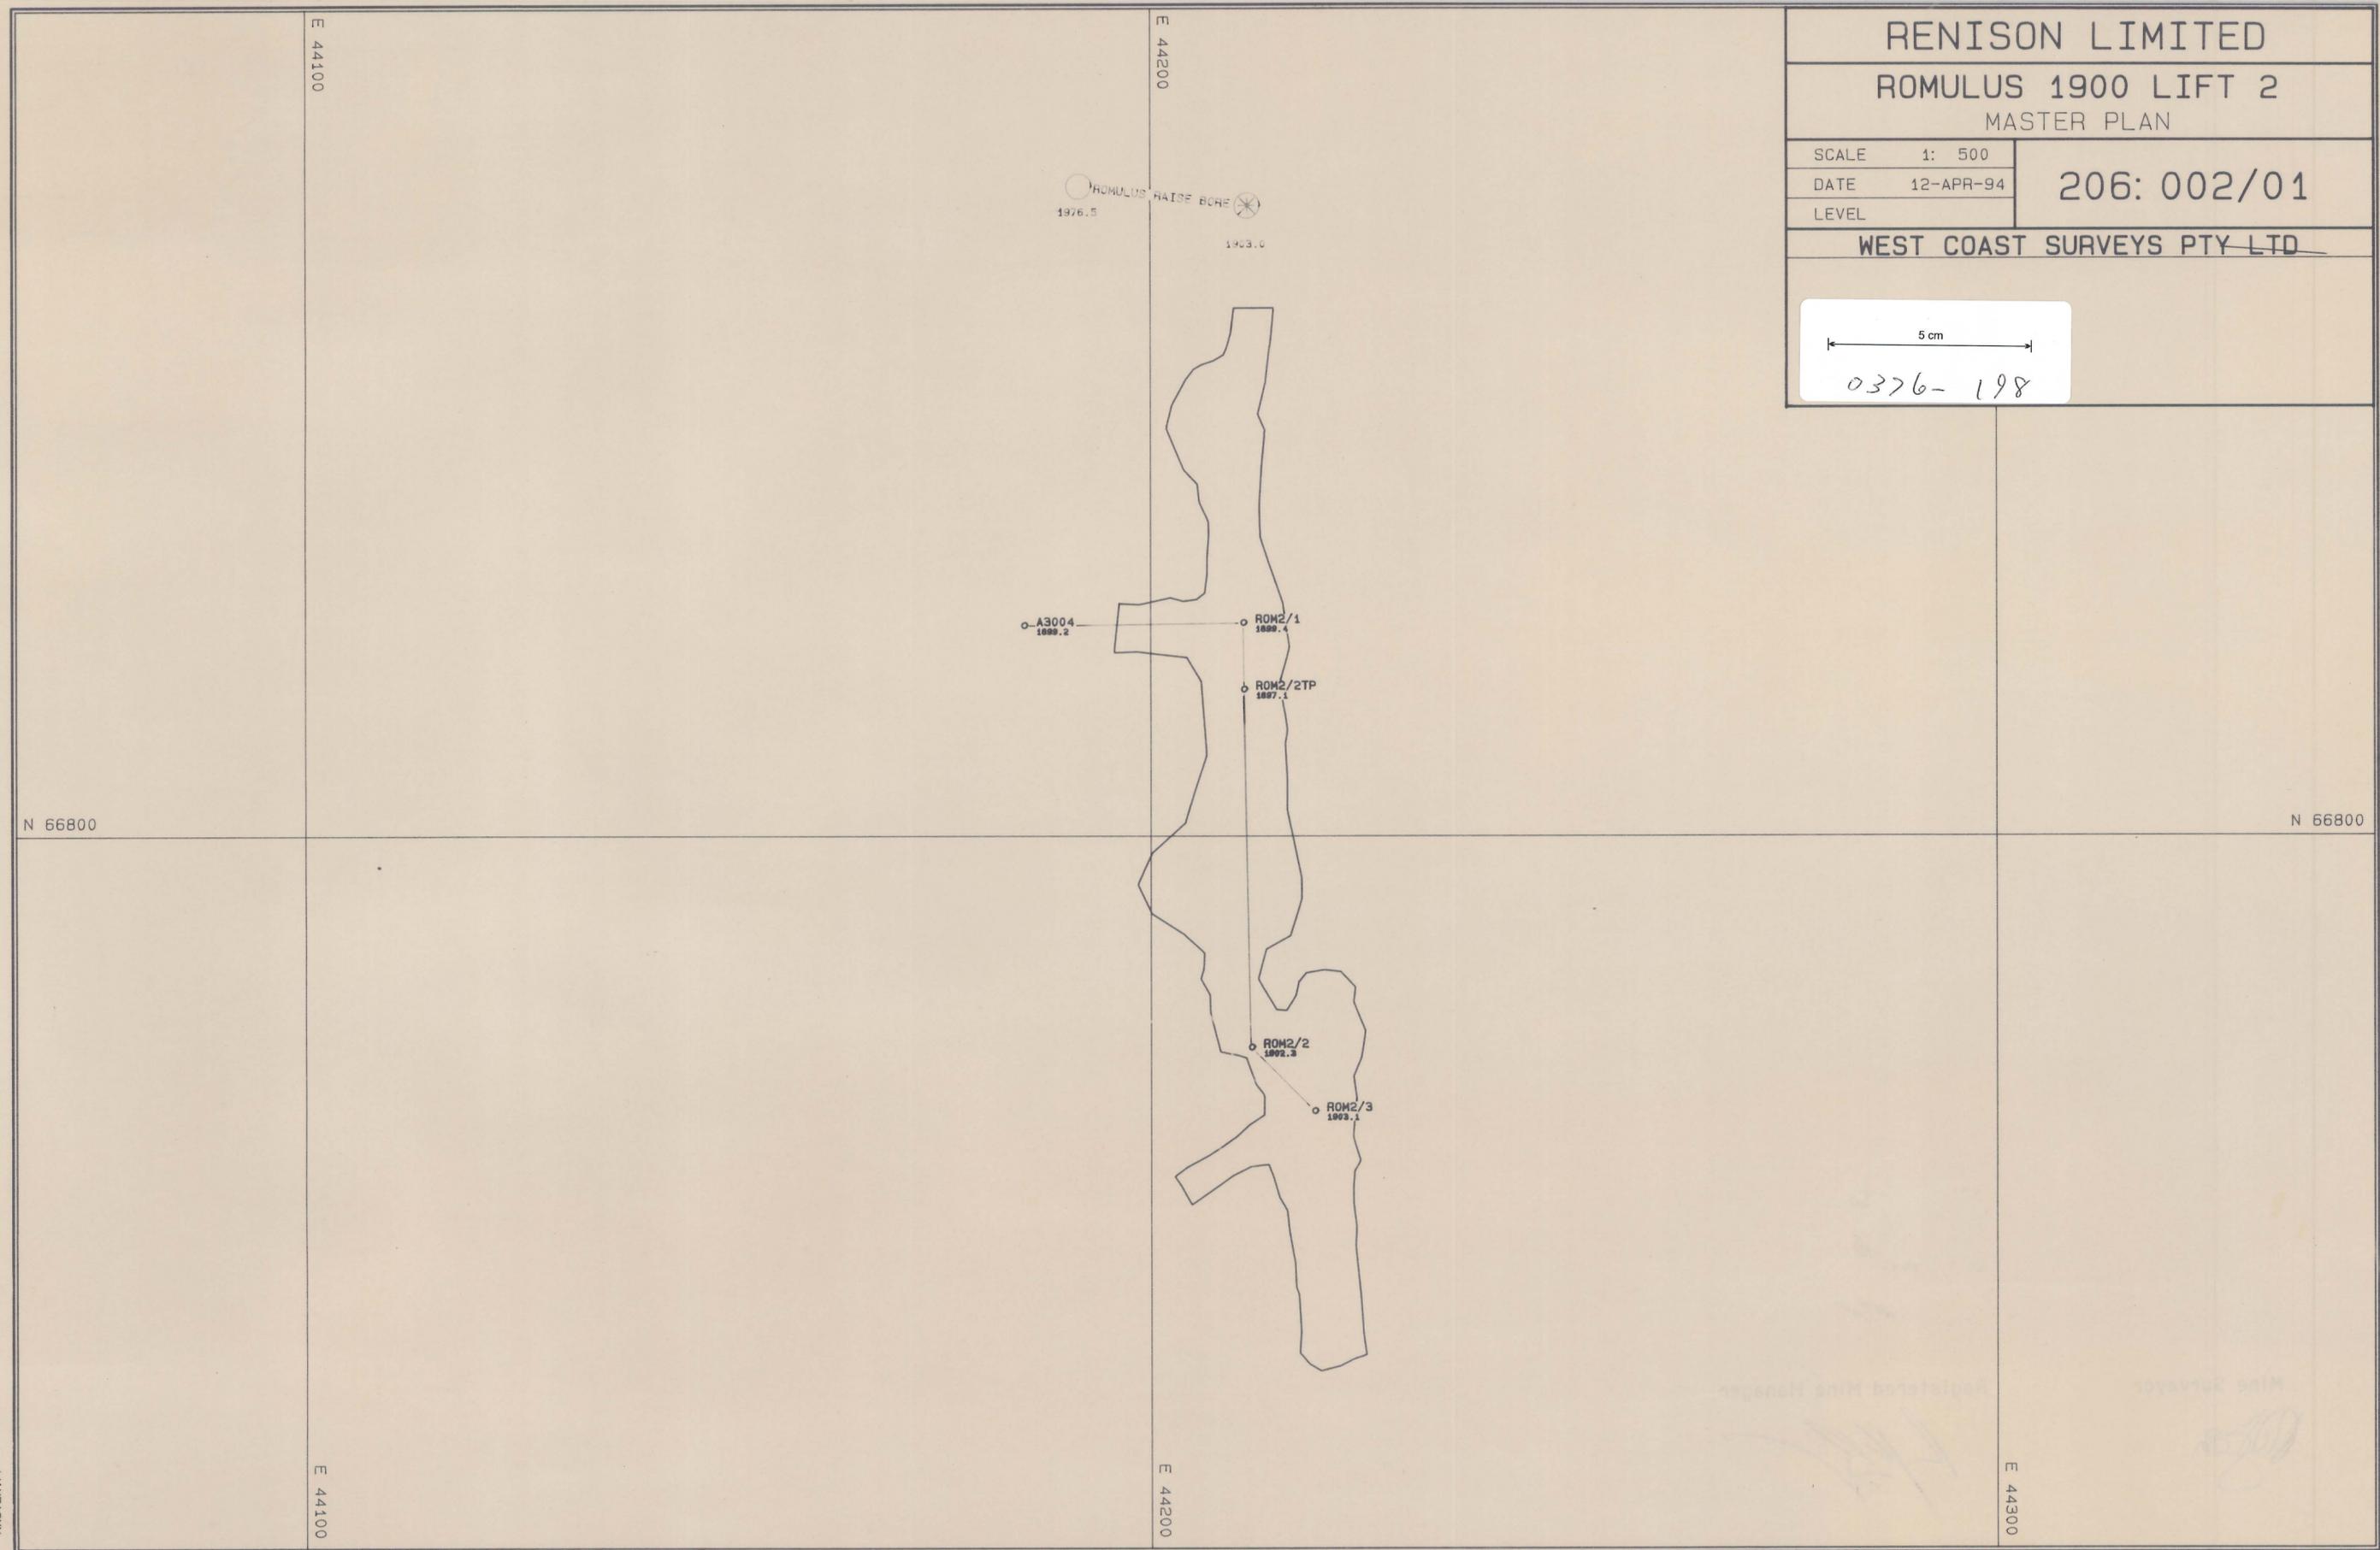

MASTEIA.PF