


0376-200

N

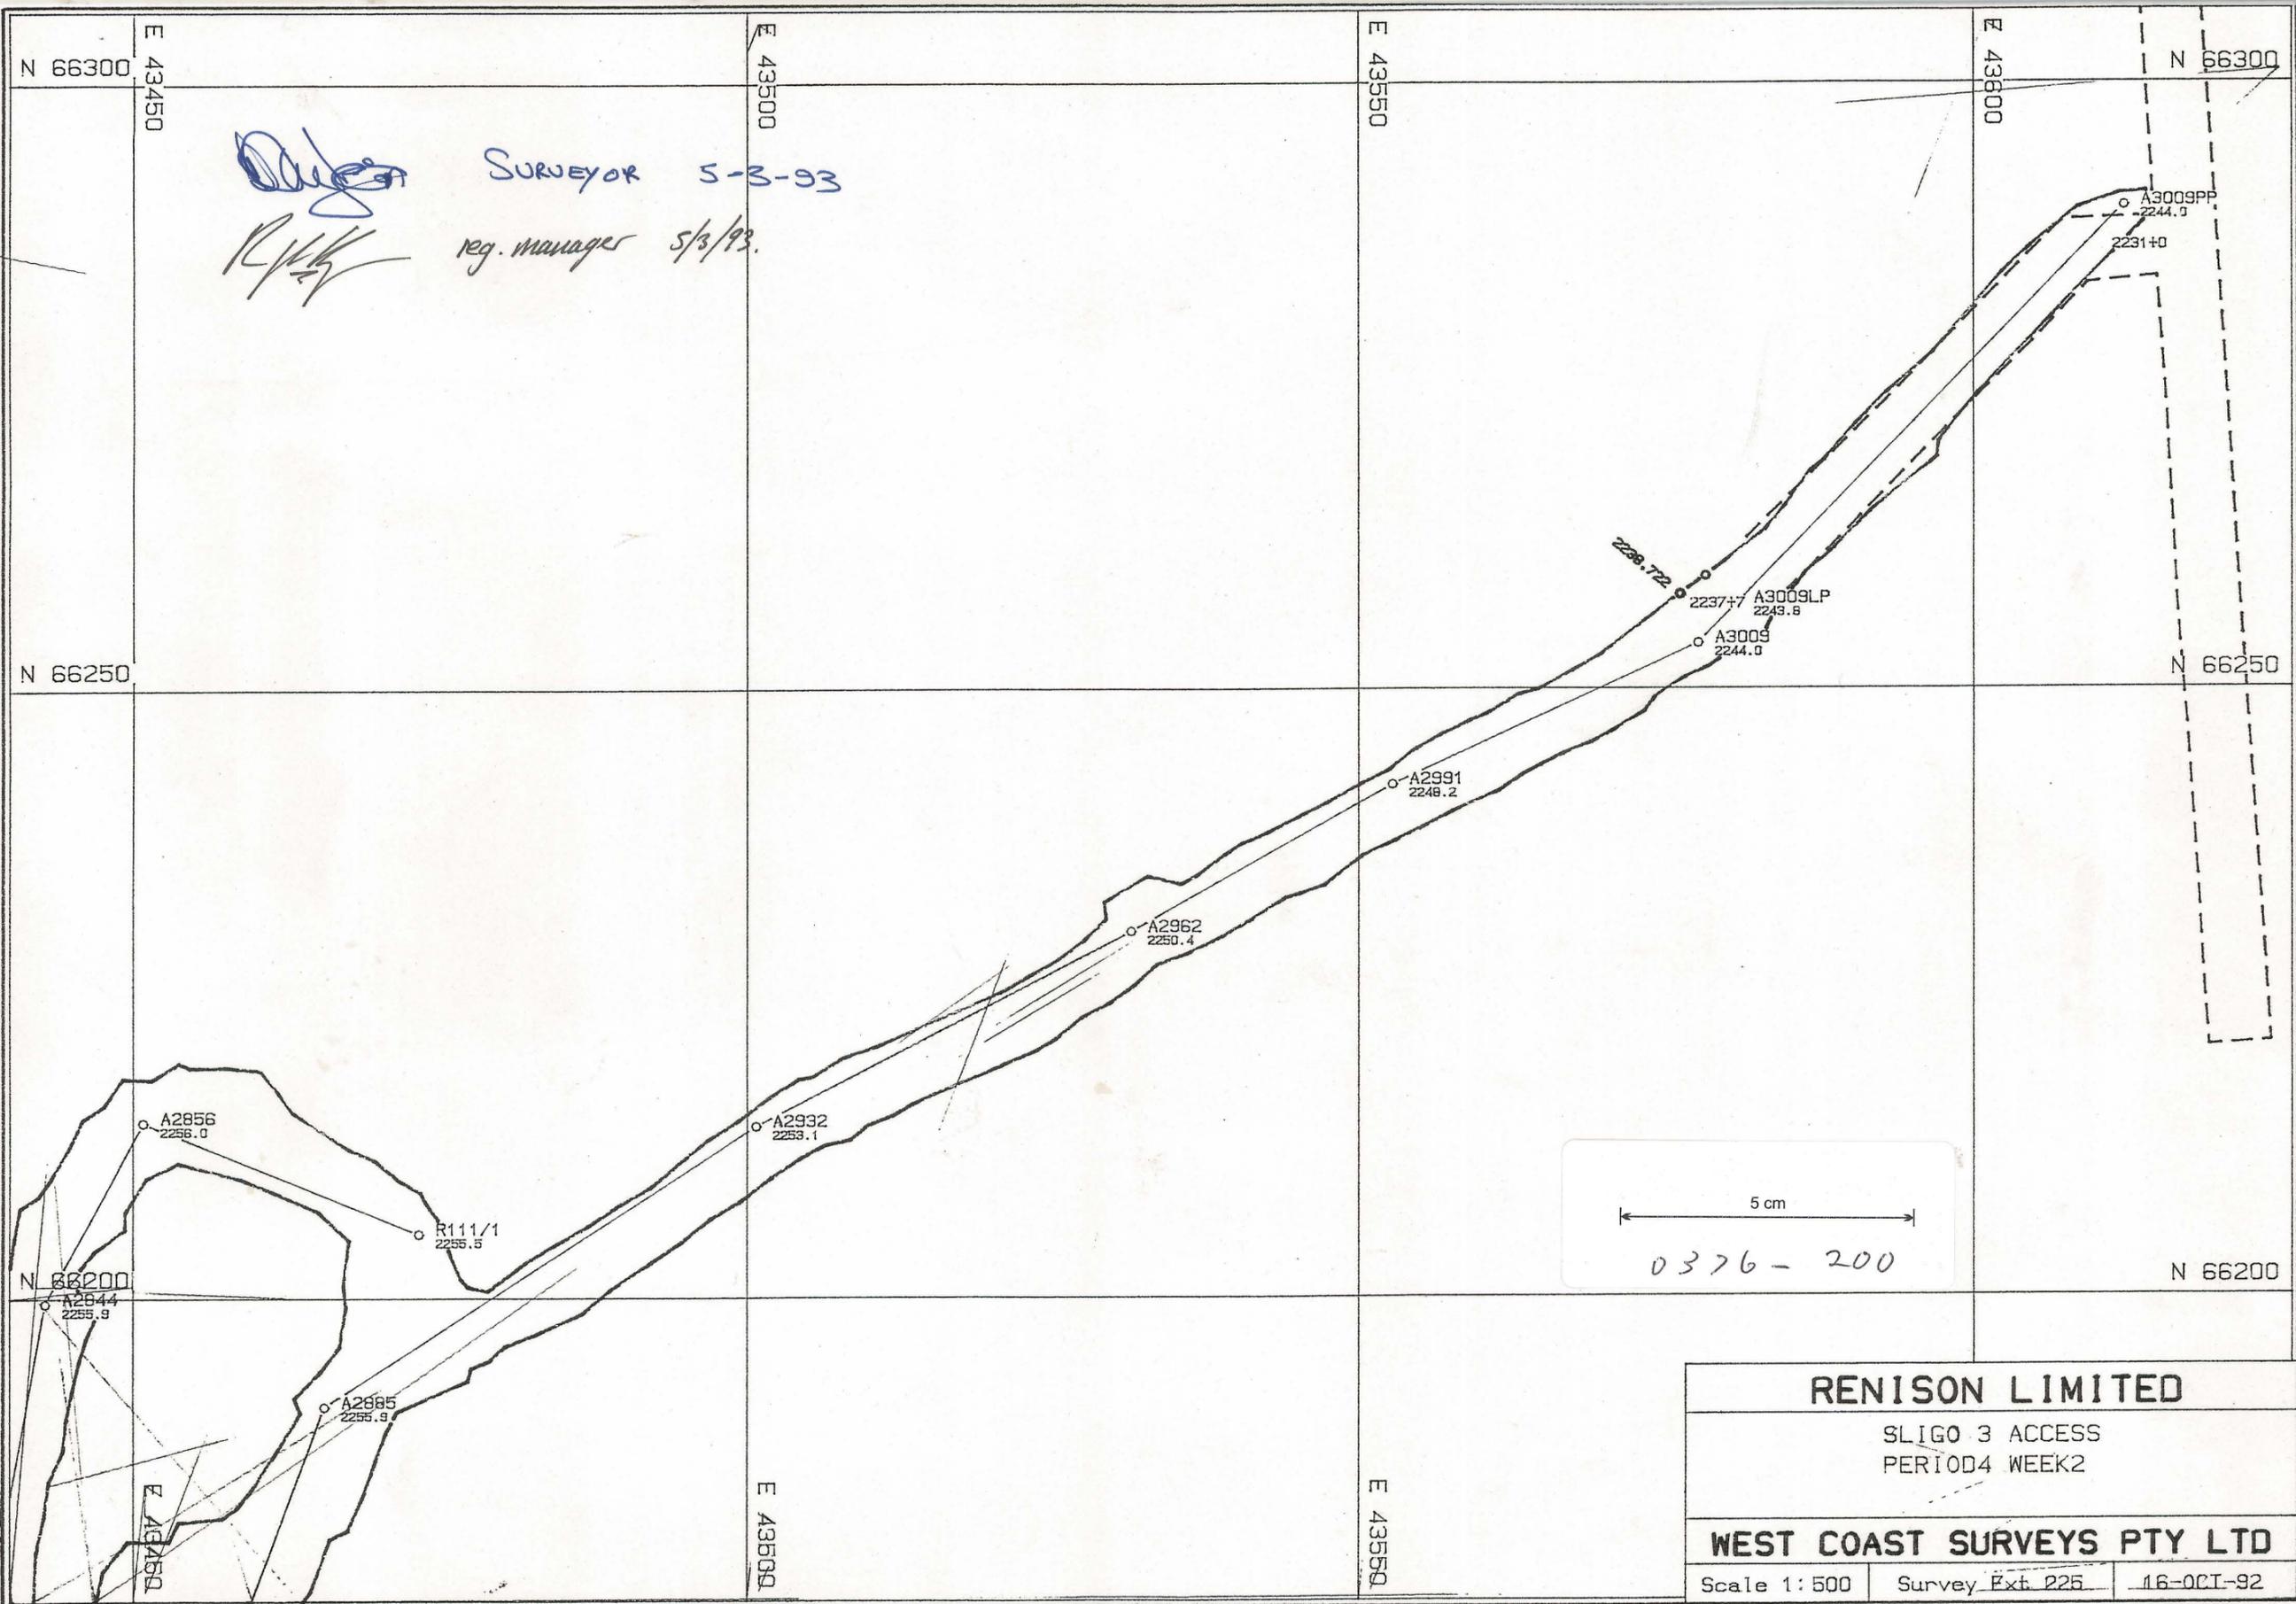

[Signature] SURVEYOR 5-3-93
[Signature] reg. manager 5/3/93.

RENISON LIMITED		
SLIGO 3 ACCESS PERIOD 4 WEEK 2		
WEST COAST SURVEYS PTY LTD		
Scale 1:500	Survey Ext. 225	16-OCT-92