

0376-201

RENISON LIMITED


STH ARGENT 1 LIFT 7 MASTER PLAN

SCALE	1: 500
DATE	10-DEC-92
LEVEL	36


112: 007/01

WEST COAST SURVEYS PTY LTD

This plan combines two stopes
SA1 & SA2 because uppers were
fired in both. Uppers were also
fired between them.

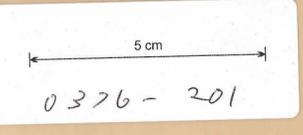

Dyson *Subsaya* 5-3-93
RJK - reg. manager 5/3/93

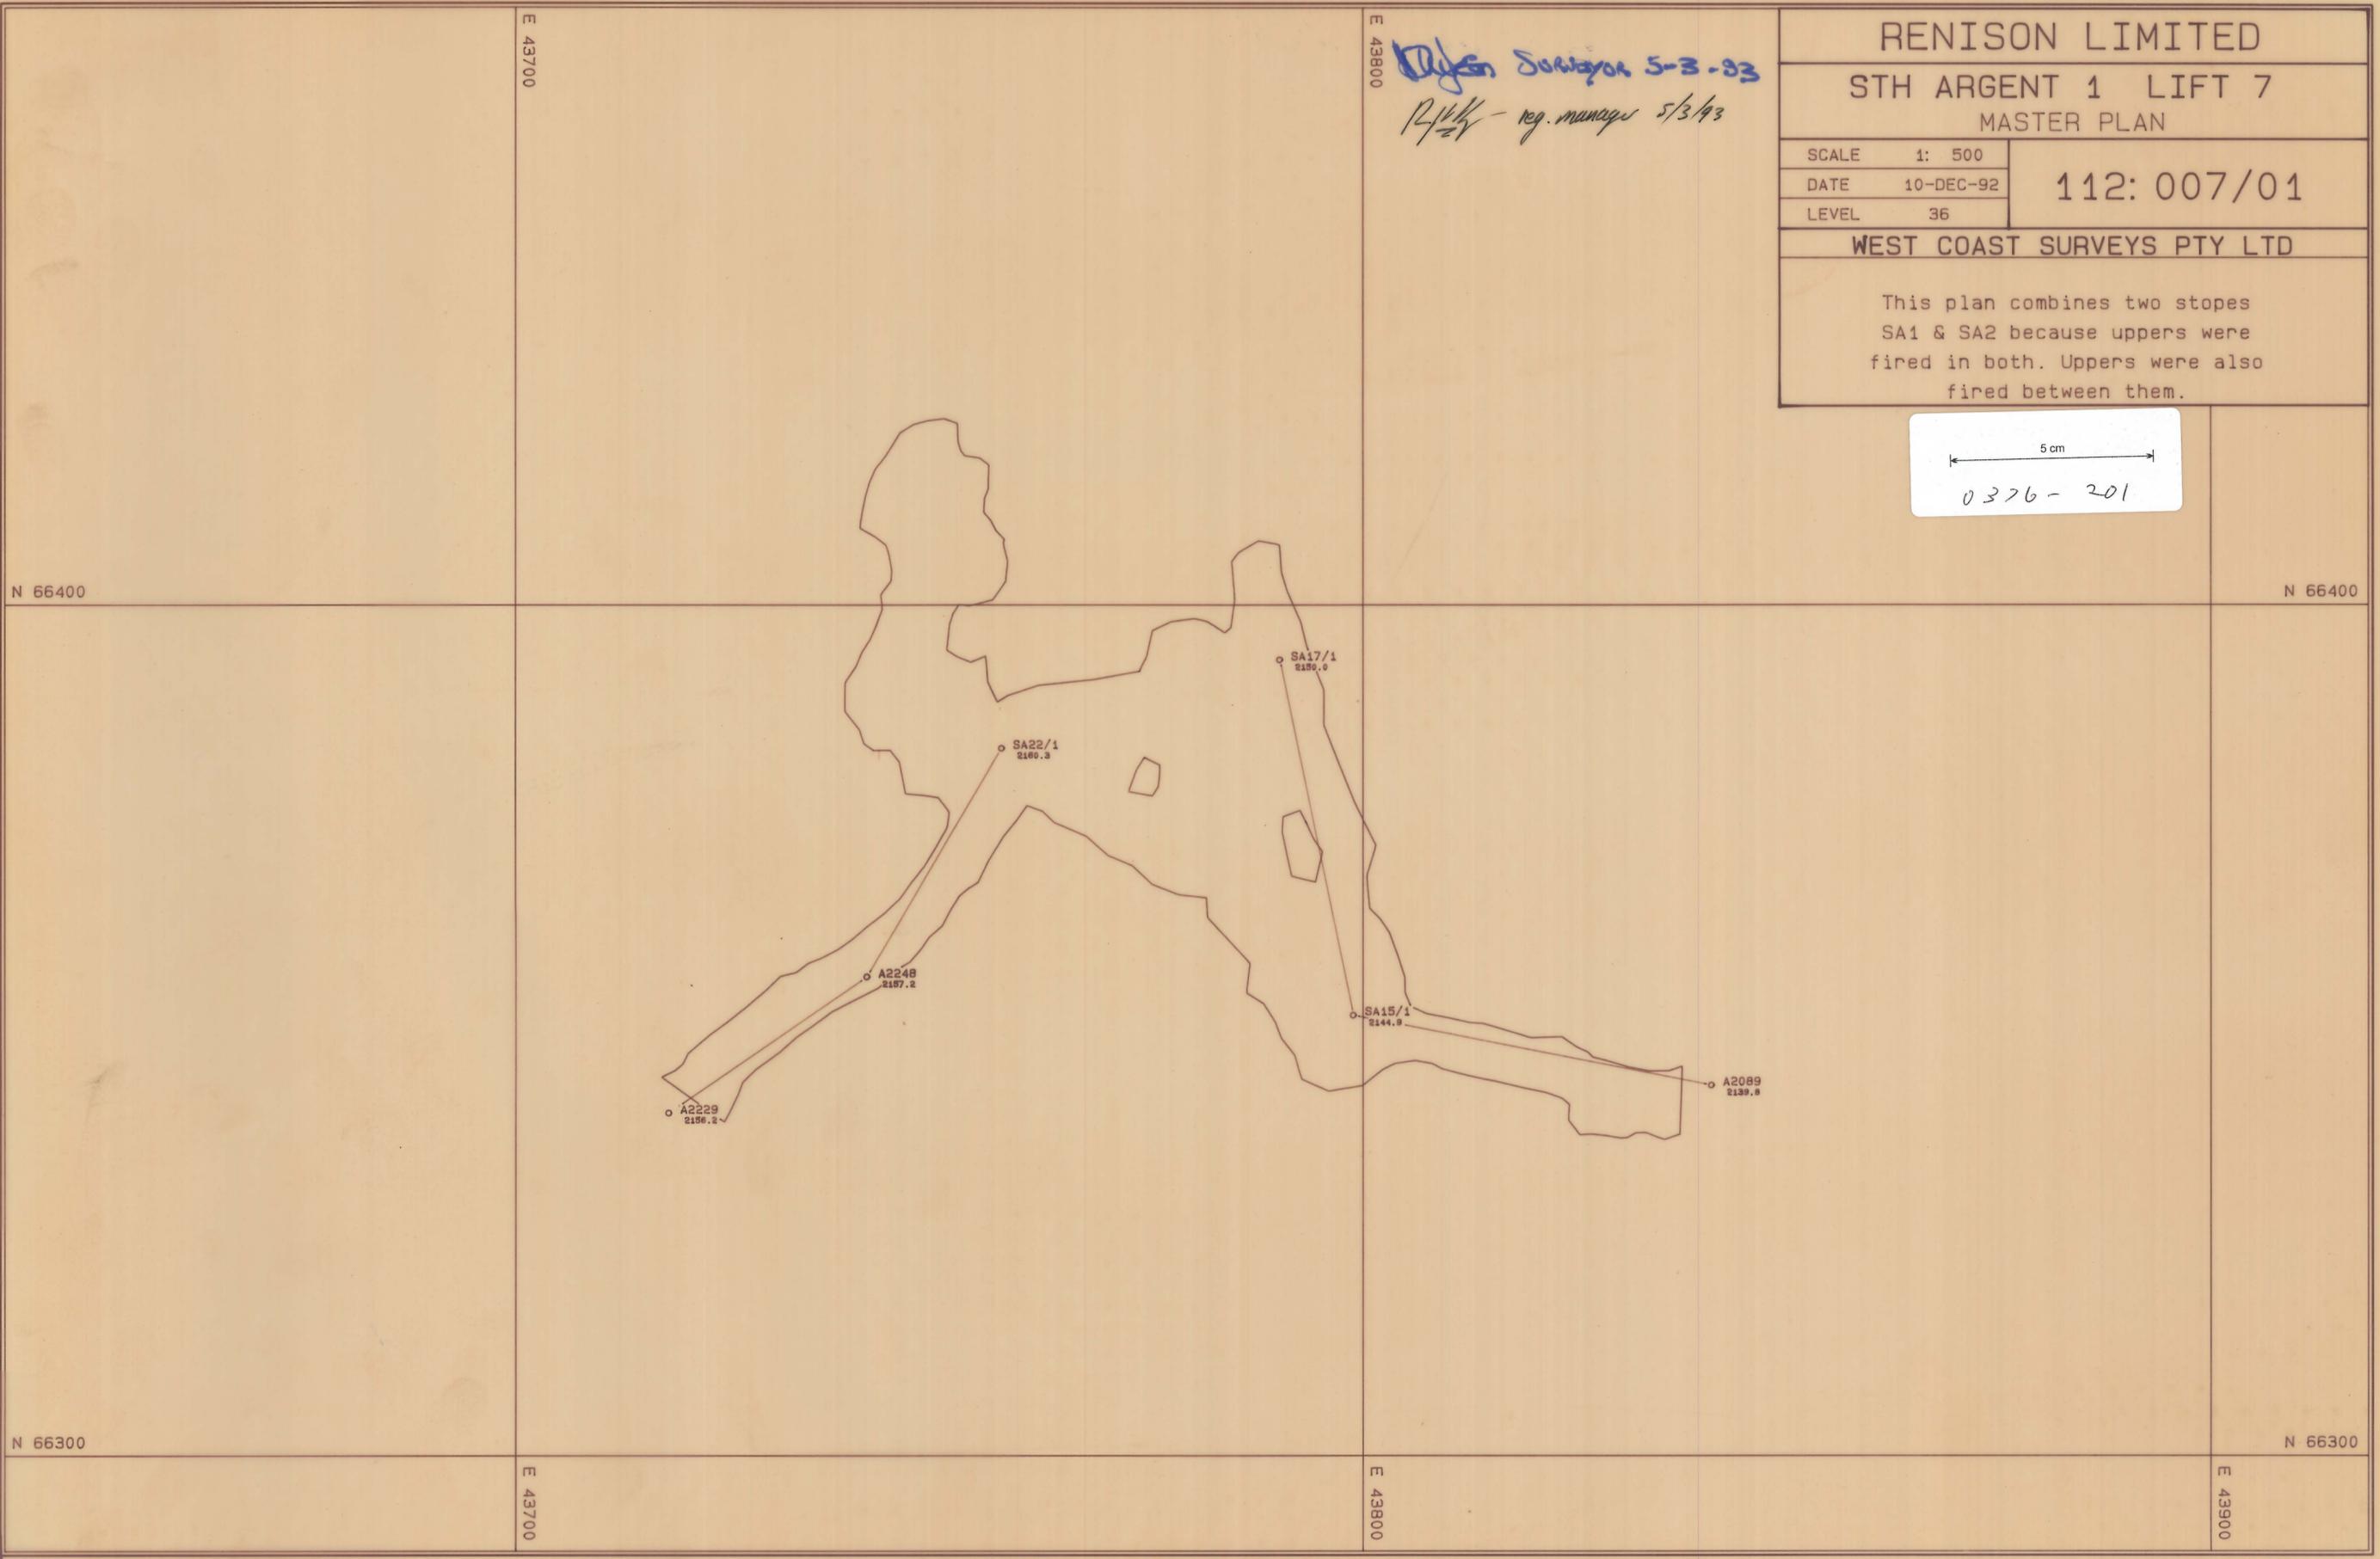

MASTE.A.PP