

0376-202

LIFT 06

RENISON LIMITED

STH ARGENT 1 LIFT 6
MASTER PLAN

SCALE 1: 500
DATE 18-JUN-92
LEVEL 36

112: 006/01

WEST COAST SURVEYS PTY LTD

Lift 6 was a normal cut & fill lift. Note b'thru to SA1 above and West.

5 cm
0376-202

E 43700

E 43800

N 66400

N 66400


N 66300

N 66300

E 43700

E 43800

E 43900

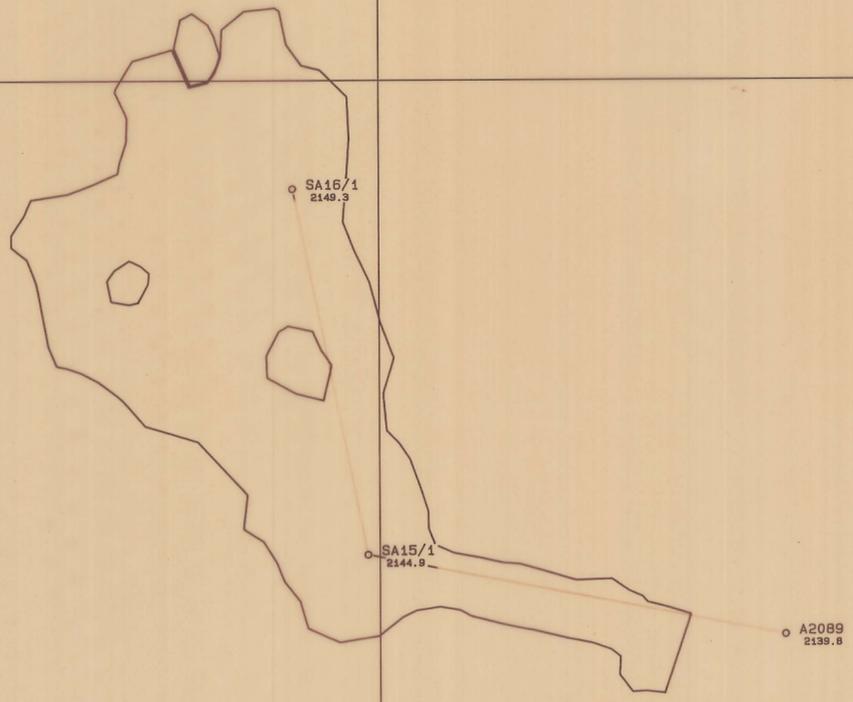

Dubey Surveyor 5-3-93
R. J. G. G. reg. manager 5/3/93