

0376 - 204

Adrian Sawley 5-3-93

R.H.K. reg. manager 5/3/93.

RENISON LIMITED

STH ARGENT 2 BLK2 SILL
MASTER PLAN

SCALE	1: 500
DATE	23-JUL-92
LEVEL	36


141: 000/01

WEST COAST SURVEYS PTY LTD

This sill was mined from an acc.
off the West Argent Incline. The
RHS was flatbacked over the
older Sth Argent 2 Blk1 (SA2).

5 cm

0376 - 204

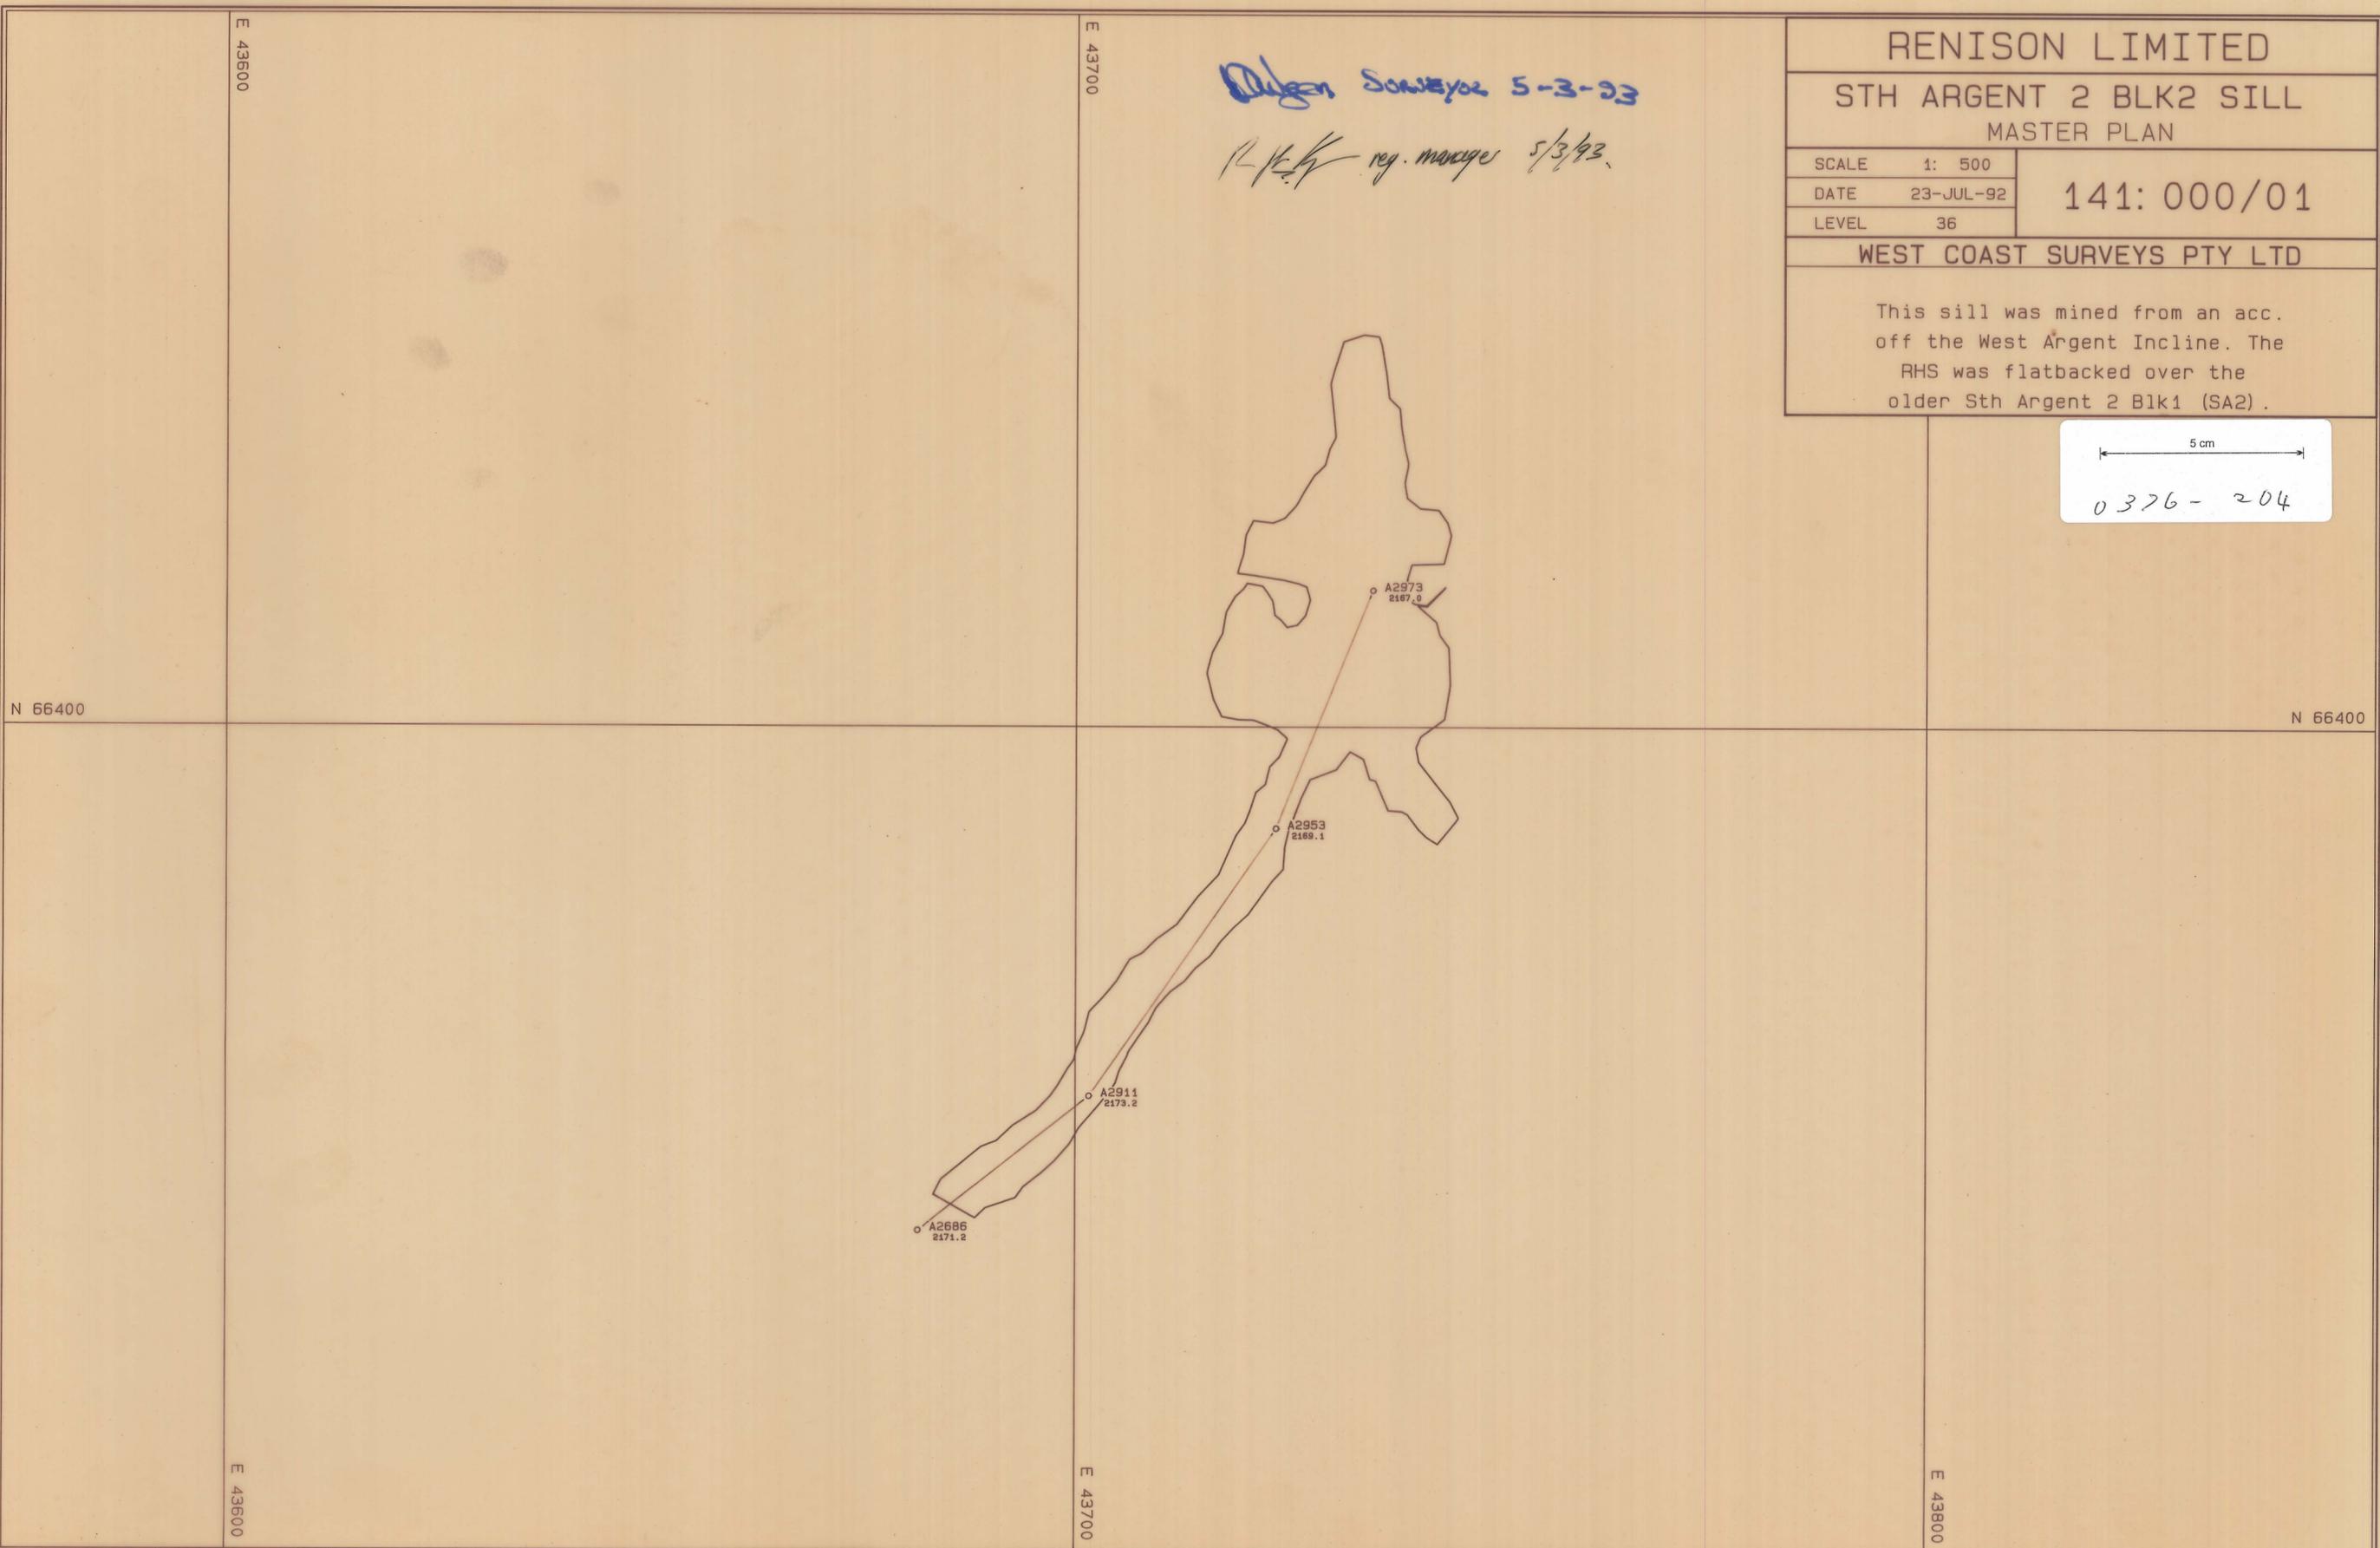

MASTE.A.PF