

0376-206

RENISON LIMITED

PIEMAN 3 UPPERS

MASTER PLAN



SCALE	1: 500
DATE	15-SEP-92
LEVEL	38

149: 001/01

WEST COAST SURVEYS PTY LTD

This was a small block mined by boring uppers from the Pieman access drive.

Oliver Surveyor 5-3-93
R/K Harper reg. manager 5/3/93.

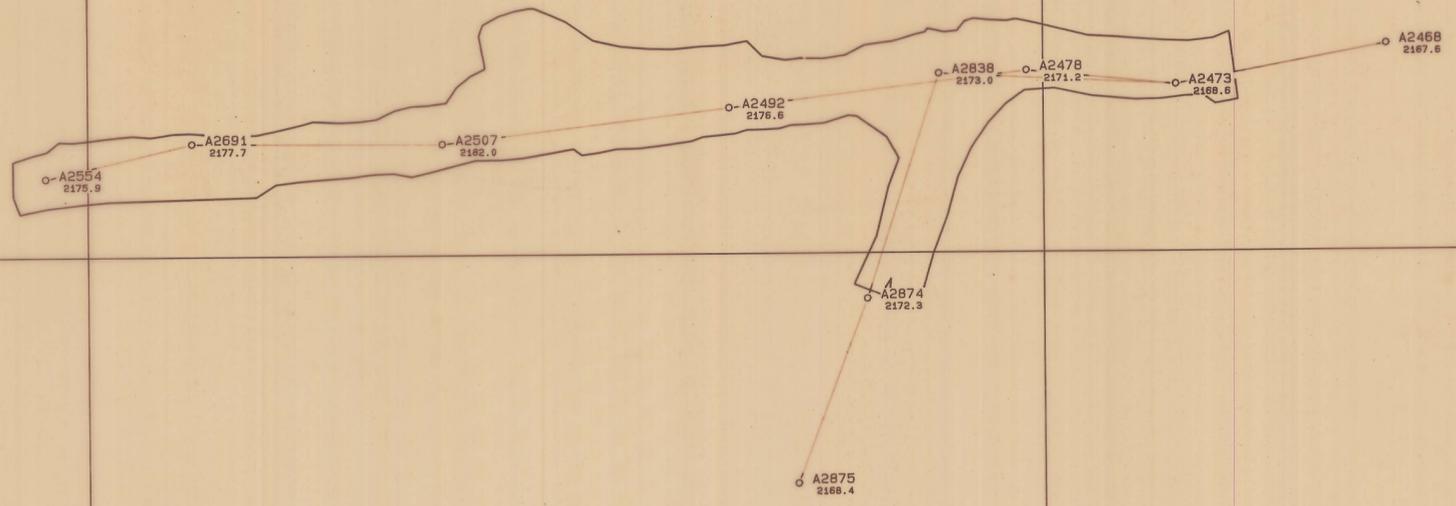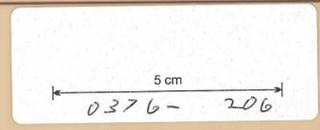

N 65700

N 65700

E 43800

E 43900

E 43800

E 43900

E 44000

MASTEA.PF