

0376-208

# RENISON LIMITED

## PIEMAN 7 SILL


### MASTER PLAN

SCALE	1: 500
DATE	26-MAR-92
LEVEL	38


149: 000/01

WEST COAST SURVEYS PTY LTD

Pieman 7 was mined out fully while silling. No flatbacking or uppers were fired. Mining was done on forced ventilation.

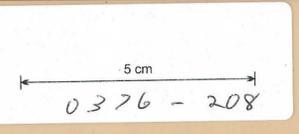

*Dalgon Surveyor 5-3-93*  
*ref. manning 5/2/93*

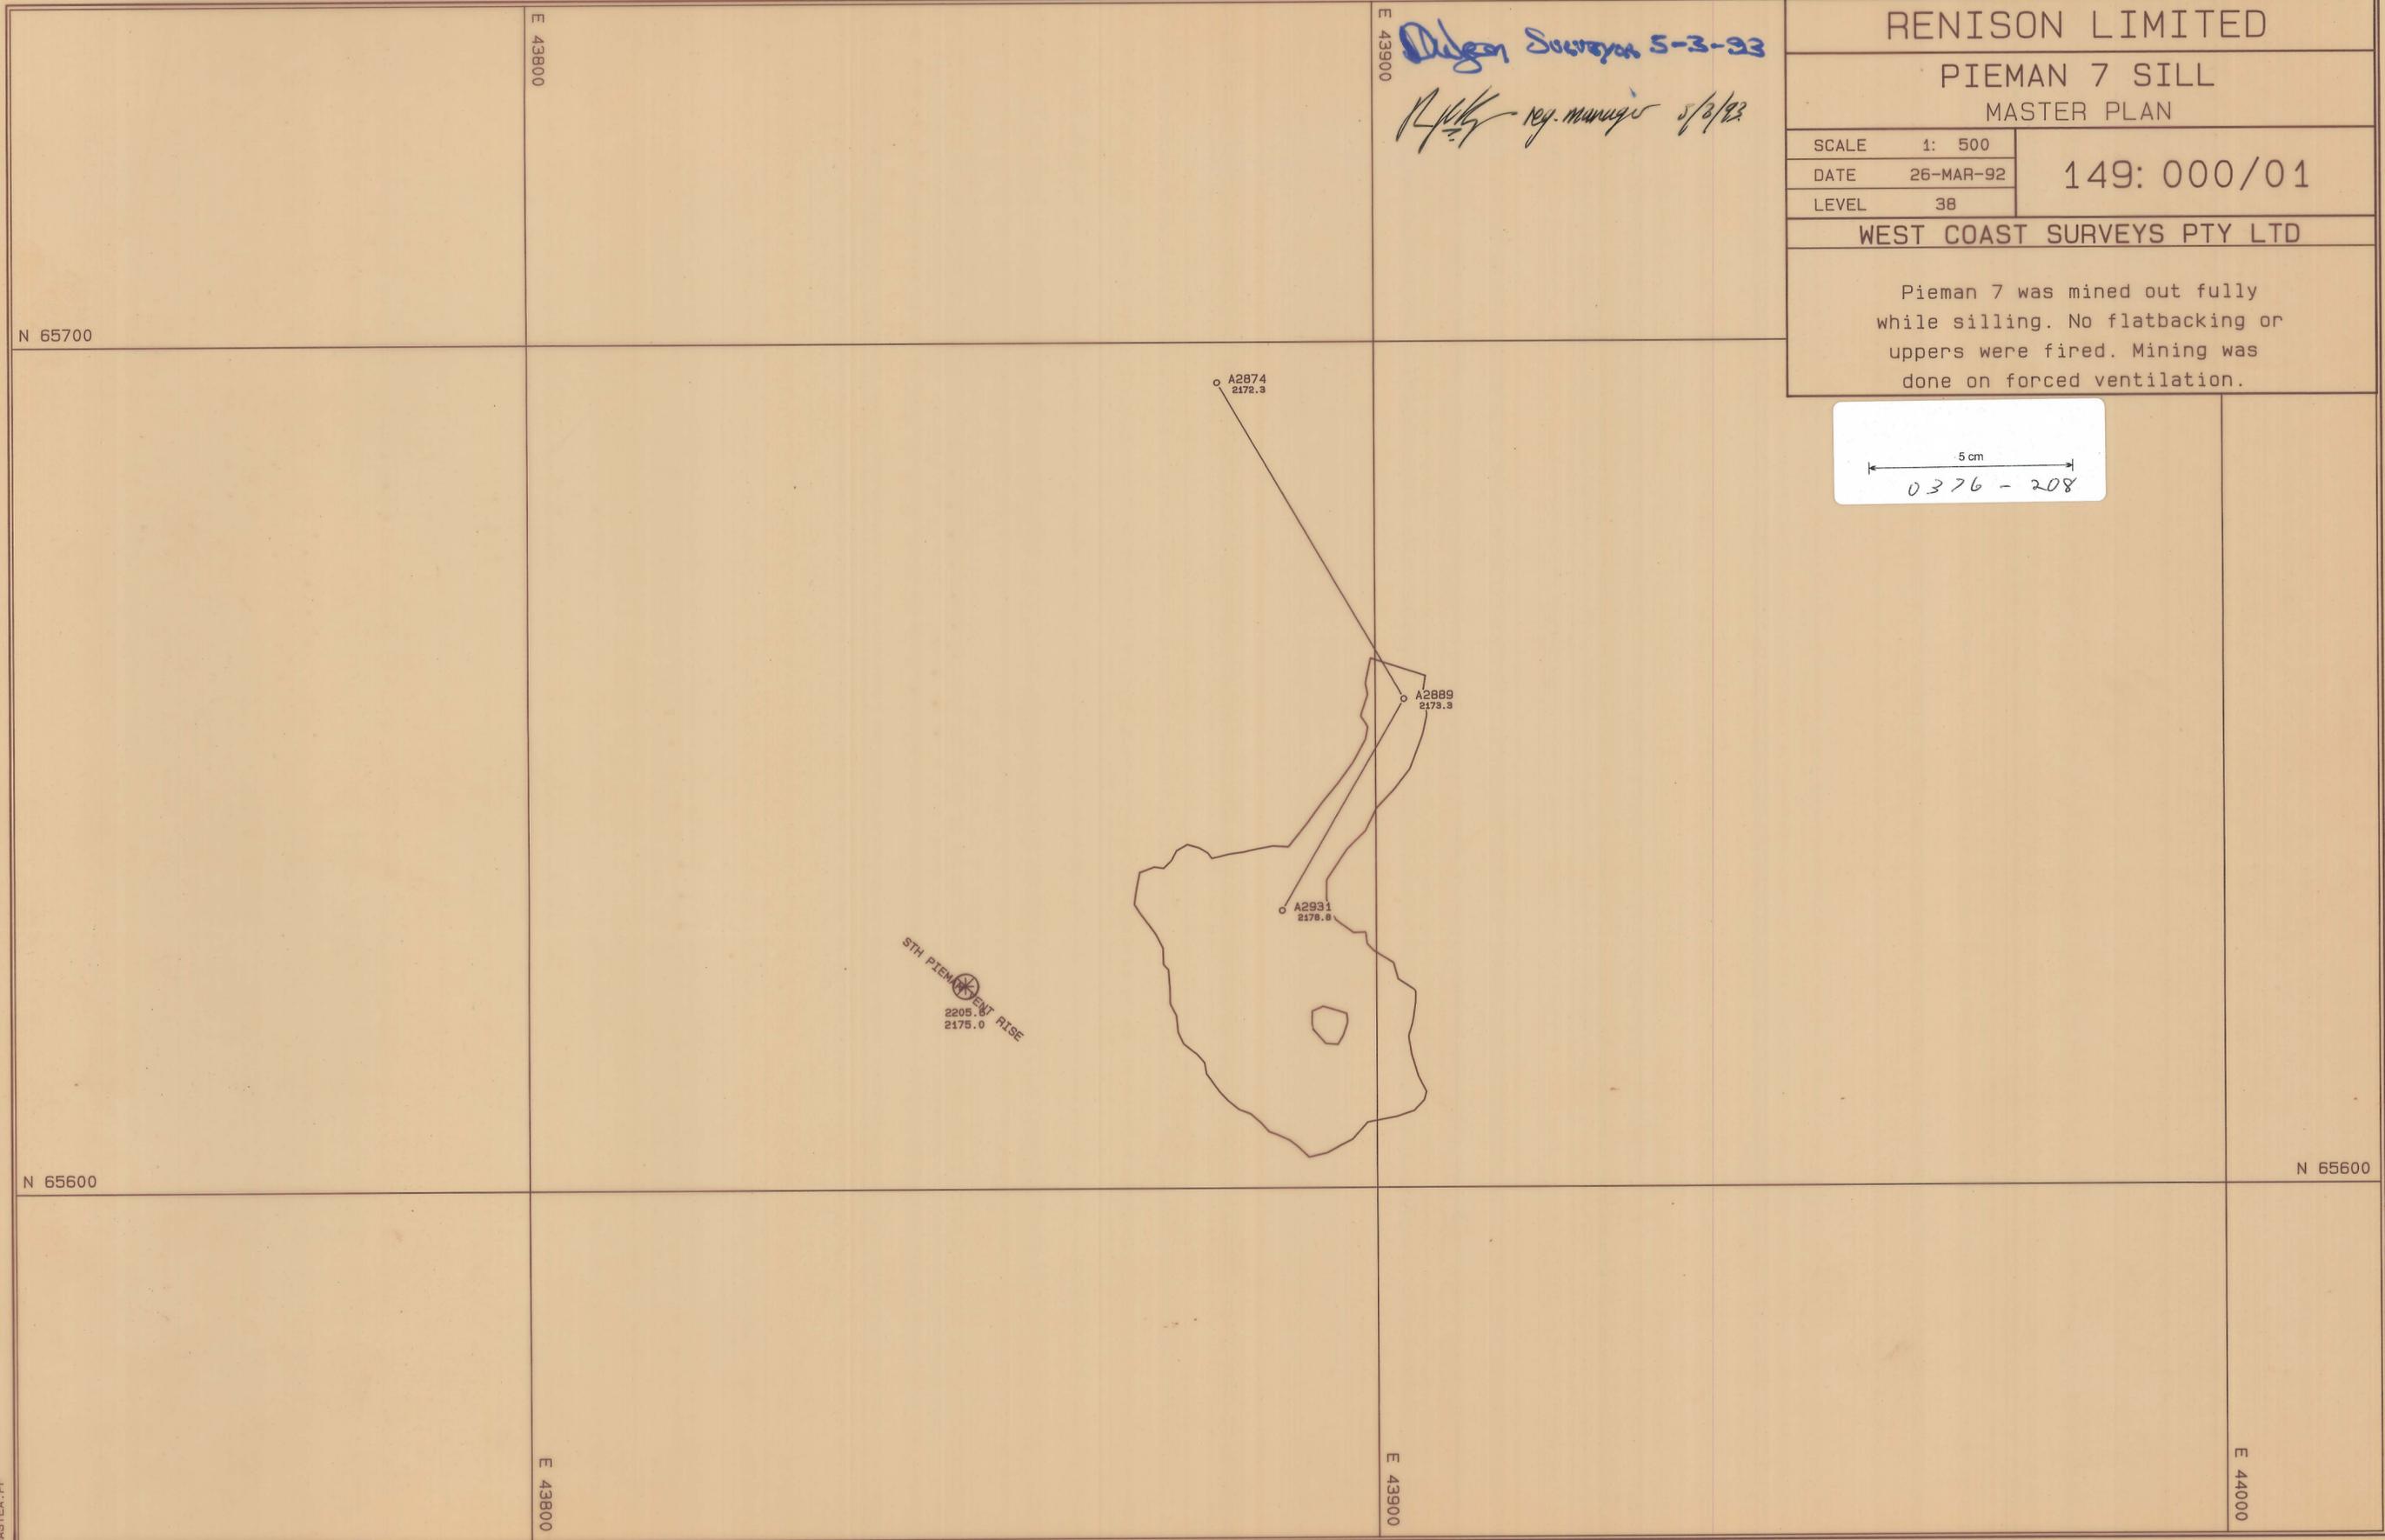

MASTEIA.PF