

0376-209

RENISON LIMITED

ELDON 1 LIFT 4
MASTER PLAN

SCALE 1: 500
DATE 24-APR-92
LEVEL 35

124: 004/01


WEST COAST SURVEYS PTY LTD

This is a small flatbacking lift
with some stripping on the left
hand side.

Dalton Swain 5-3-92
R/V/H reg. manager 5/3/93.

5 cm
0376-209

ELDON 1  RISE
2195.2
2203.3

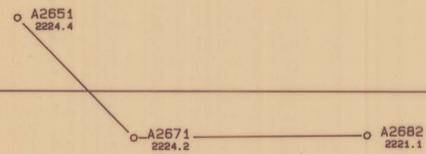

N 65800

E 43700

E 43800

N 65700

N 65700

E 43700

E 43800

E 43900