

0376-213

Wilson Survey 5-3-93
R.W.K. reg. manager 5/3/93.

RENISON LIMITED


FEDERAL 2080 LIFT 31
MASTER PLAN

SCALE 1: 500
DATE 25-AUG-92
LEVEL 52

4: 031/01

WEST COAST SURVEYS PTY LTD

This was a normal f'backing lift with some driving & stripping on the RHS near the access. This is the final lift pre open stoping.

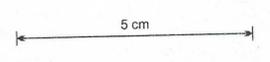

0376-213

E 44200

E 44300

N 65700


N 65700

N 65600

N 65600

E 44200

E 44300

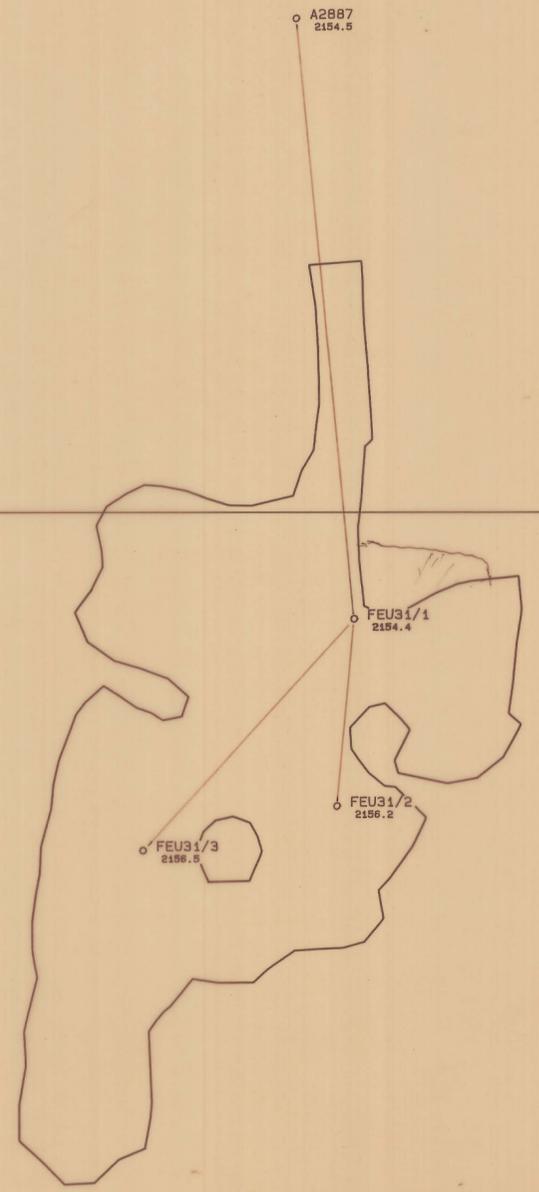

MASTEAF.PF