

0376-214



*Dilgen Surveyor 5-3-93*  
*R. J. King reg. manager 5/3/93.*

RENISON LIMITED  
RING 1 " LIFT 1 "  
MASTER PLAN

SCALE	1: 500	148: 001/01
DATE	15-SEP-92	
LEVEL	34	

WEST COAST SURVEYS PTY LTD

"Lift 1" is the second stage of contract airleg mining.

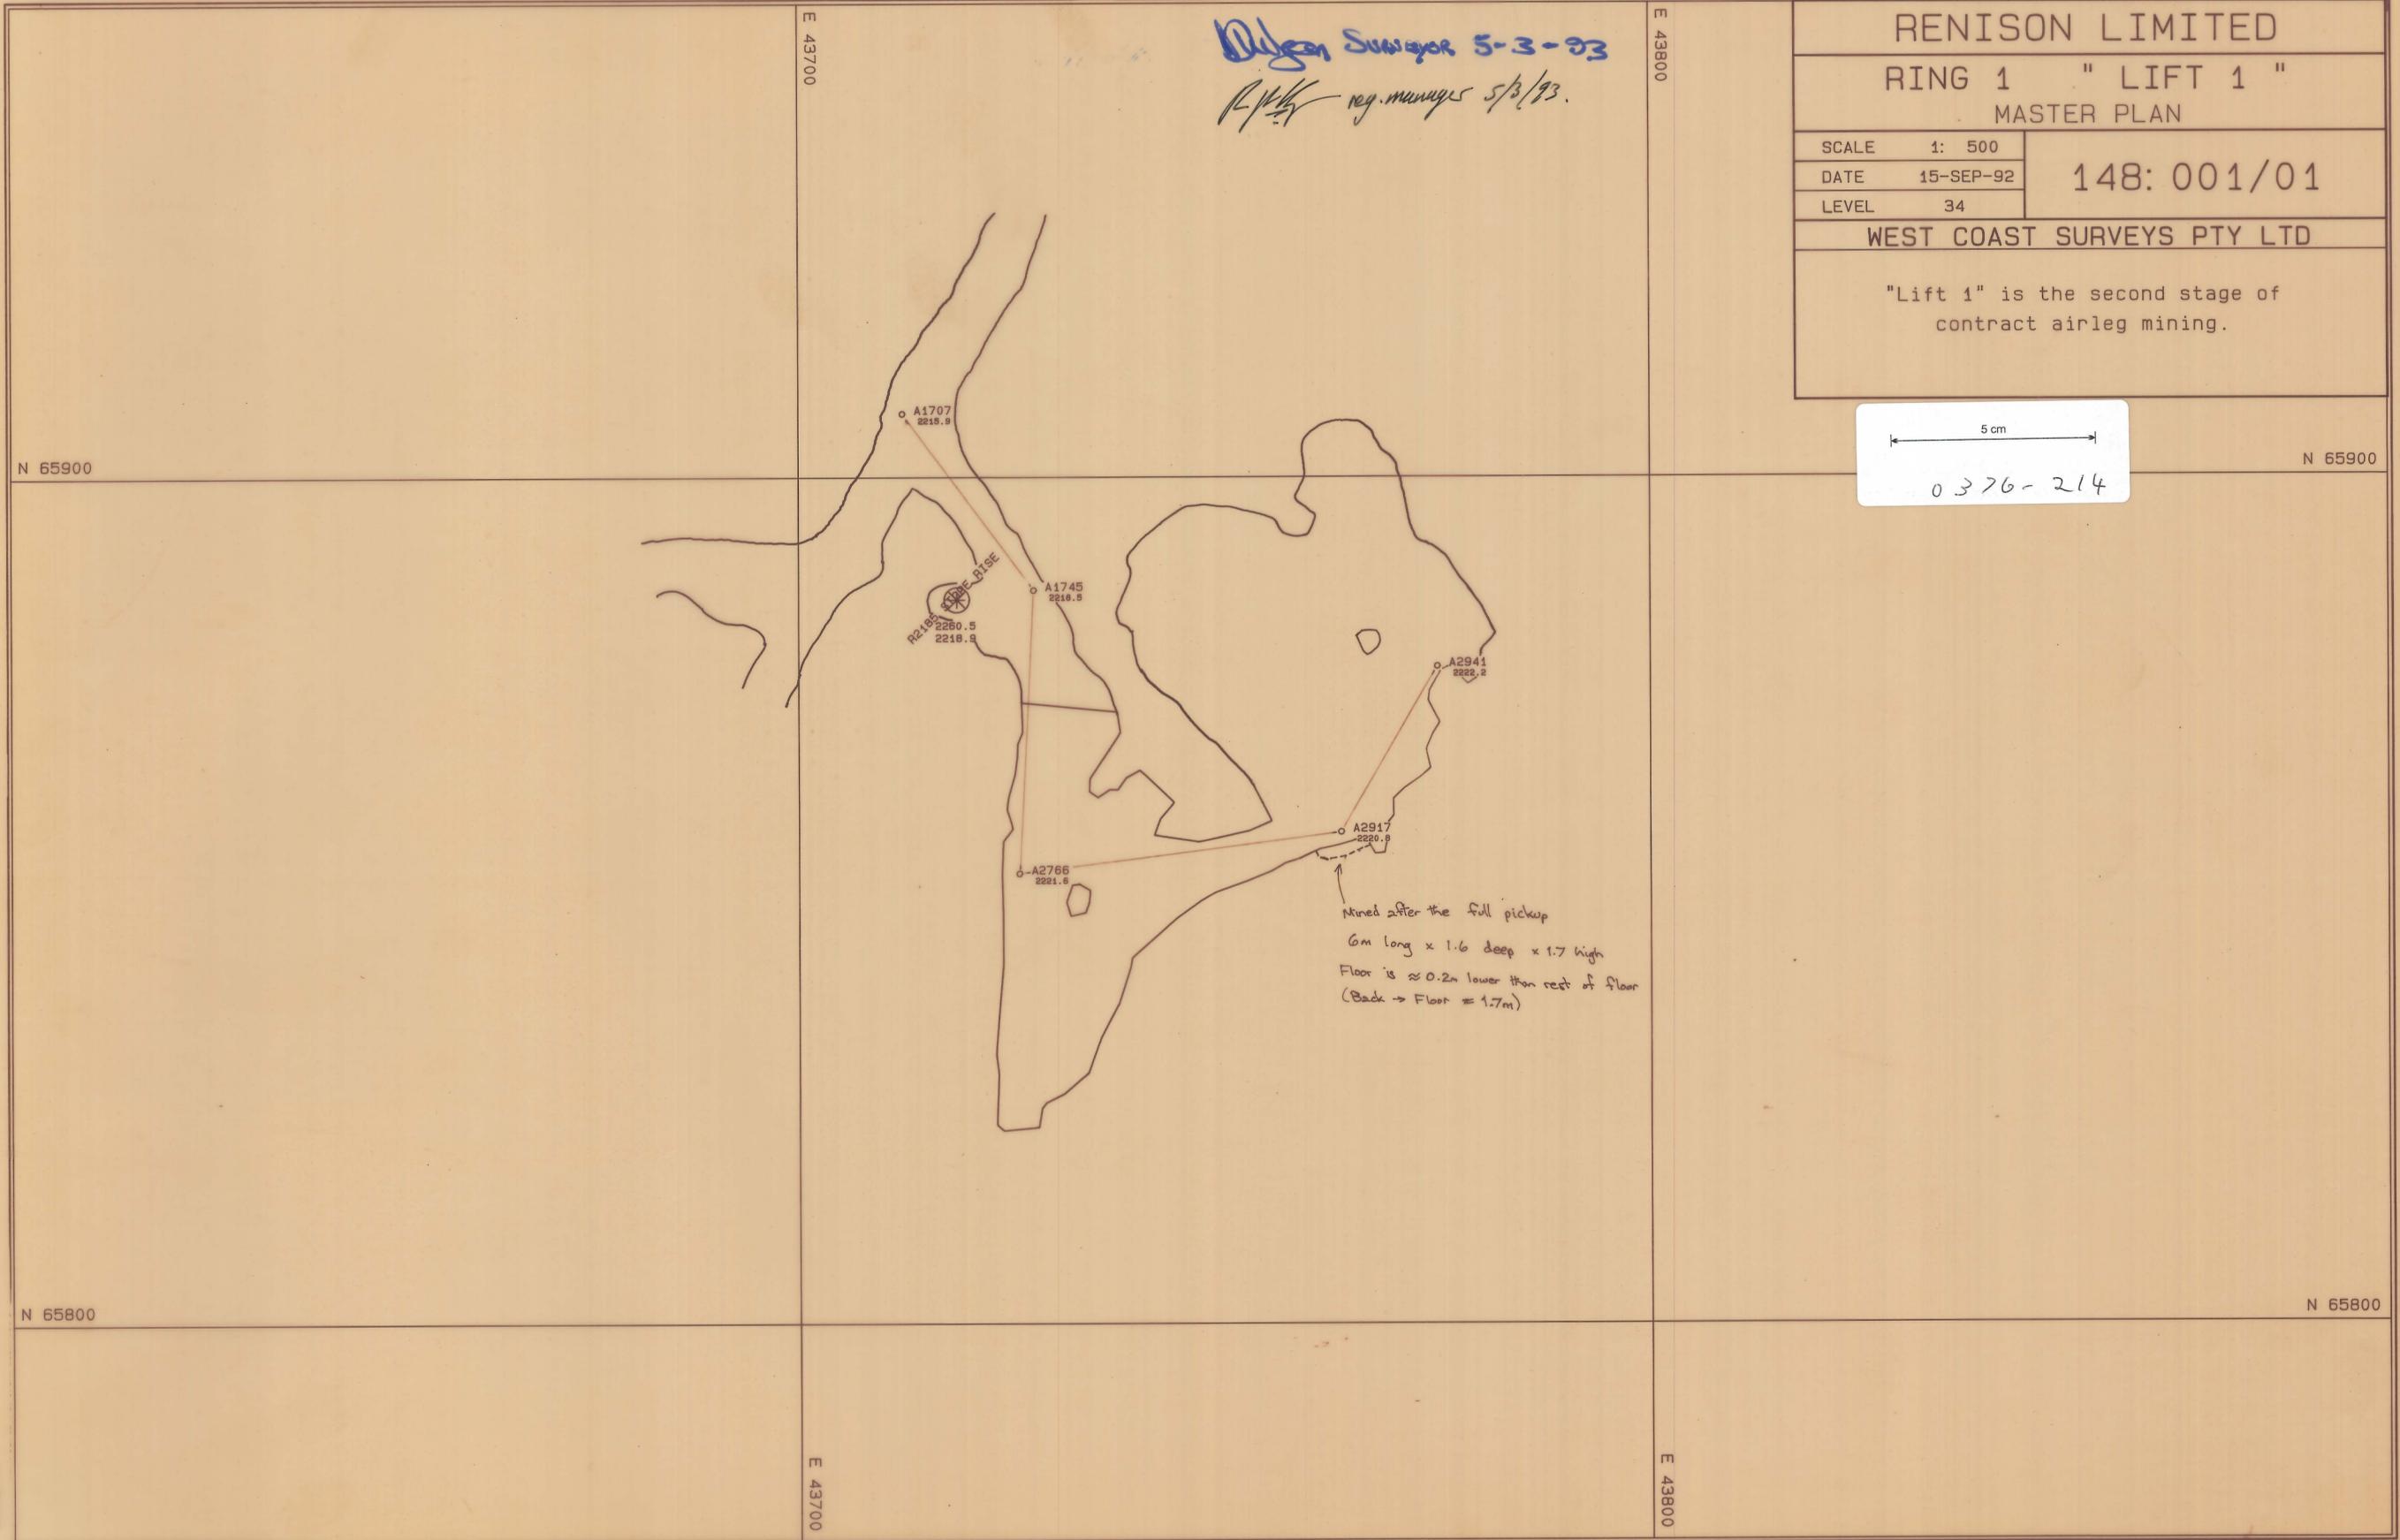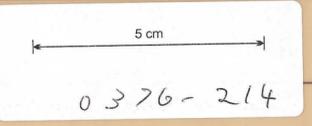

N 65900

N 65900

N 65800

N 65800

E 43700

E 43800

E 43700

E 43800

MASTEIA.PF