


0376-220

Dalton Surveyor 5-3-93
R.V.G. reg. manager 5/3/93

| | |
|---|-------------|
| RENISON LIMITED | |
| NORTH STEBBINS 2180 LIFT | |
| MASTER PLAN | |
| SCALE 1: 500 | 136: 004/01 |
| DATE 29-SEP-92 | |
| LEVEL 40 | |
| WEST COAST SURVEYS PTY LTD | |
| Final lift of Nth Stebbins 2180. Note FLOOR heights on LH side opposite pillar. Back heights are approx only (uppers taken). | |

5 cm
0376-220

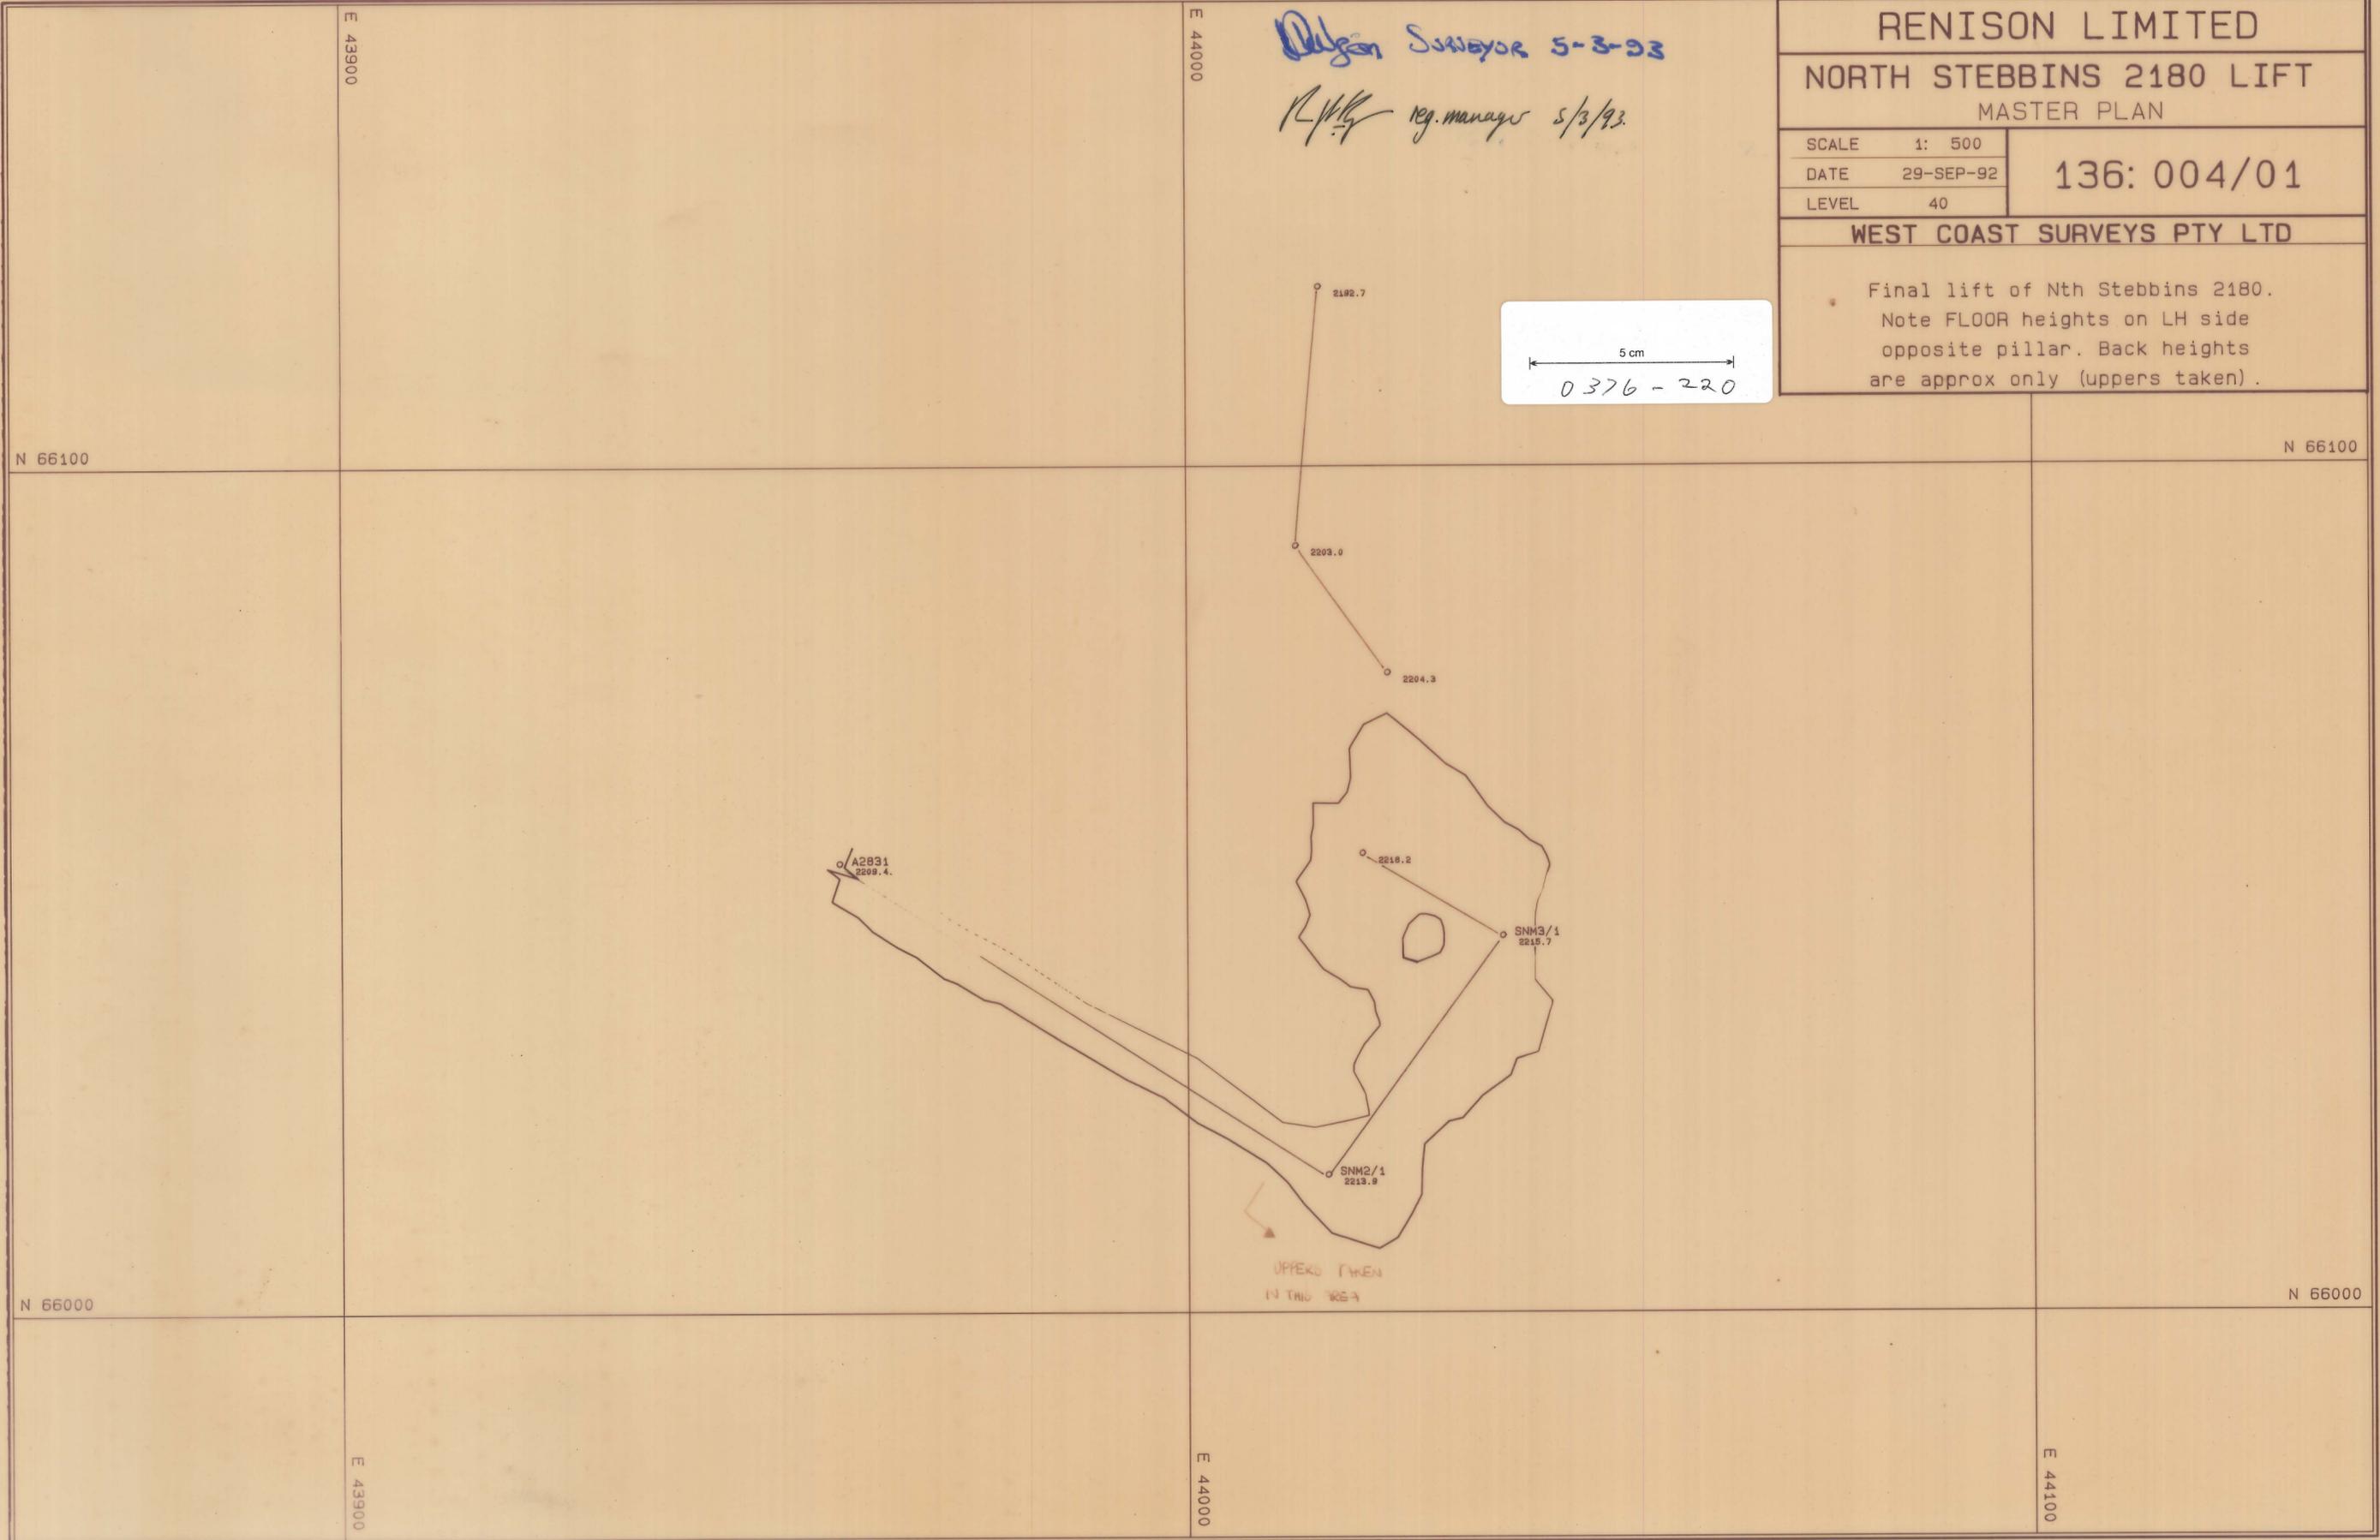

MASTEIA.PF