
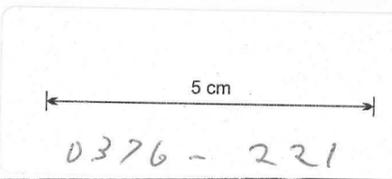


[Signature]
SURVEYOR S-33
[Signature]
reg. manager 5/3/93

* SLIGO 3 RAW IS GOING WELL;
ON LINE AND ON GRADE *

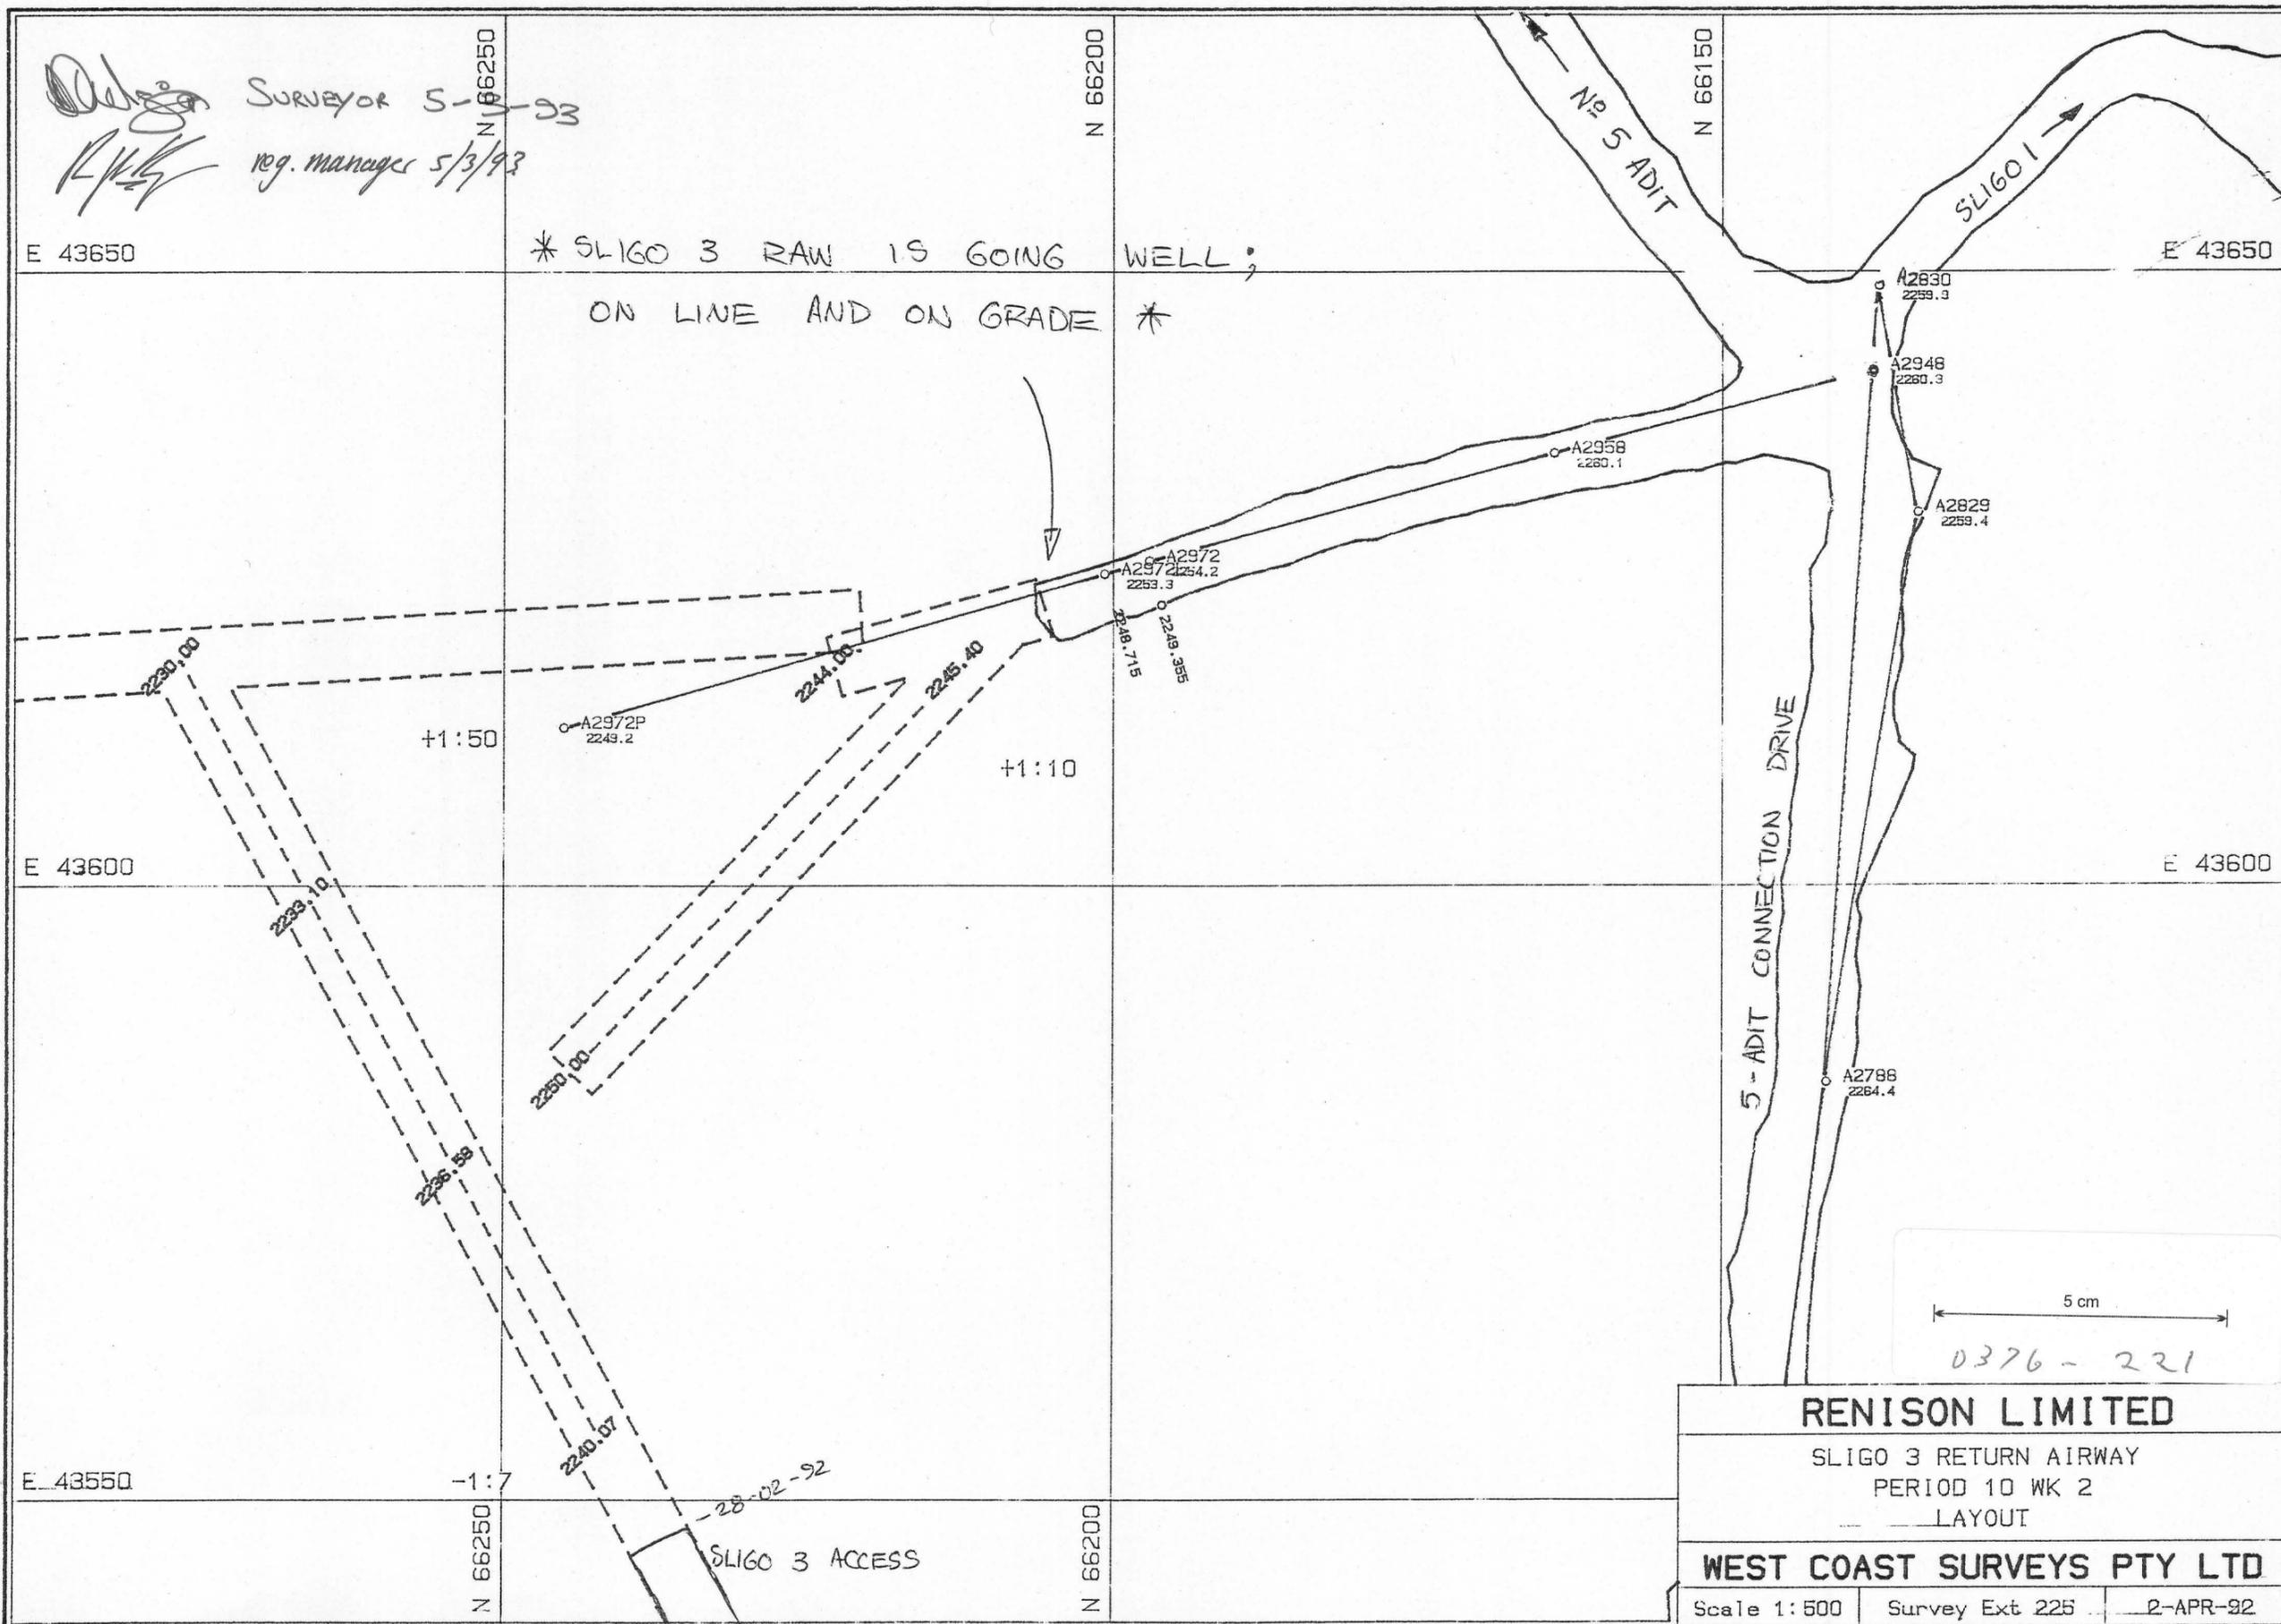

RENISON LIMITED		
SLIGO 3 RETURN AIRWAY PERIOD 10 WK 2 LAYOUT		
WEST COAST SURVEYS PTY LTD		
Scale 1:500	Survey Ext 225	2-APR-92

SLIGOA.PF