


0376-222

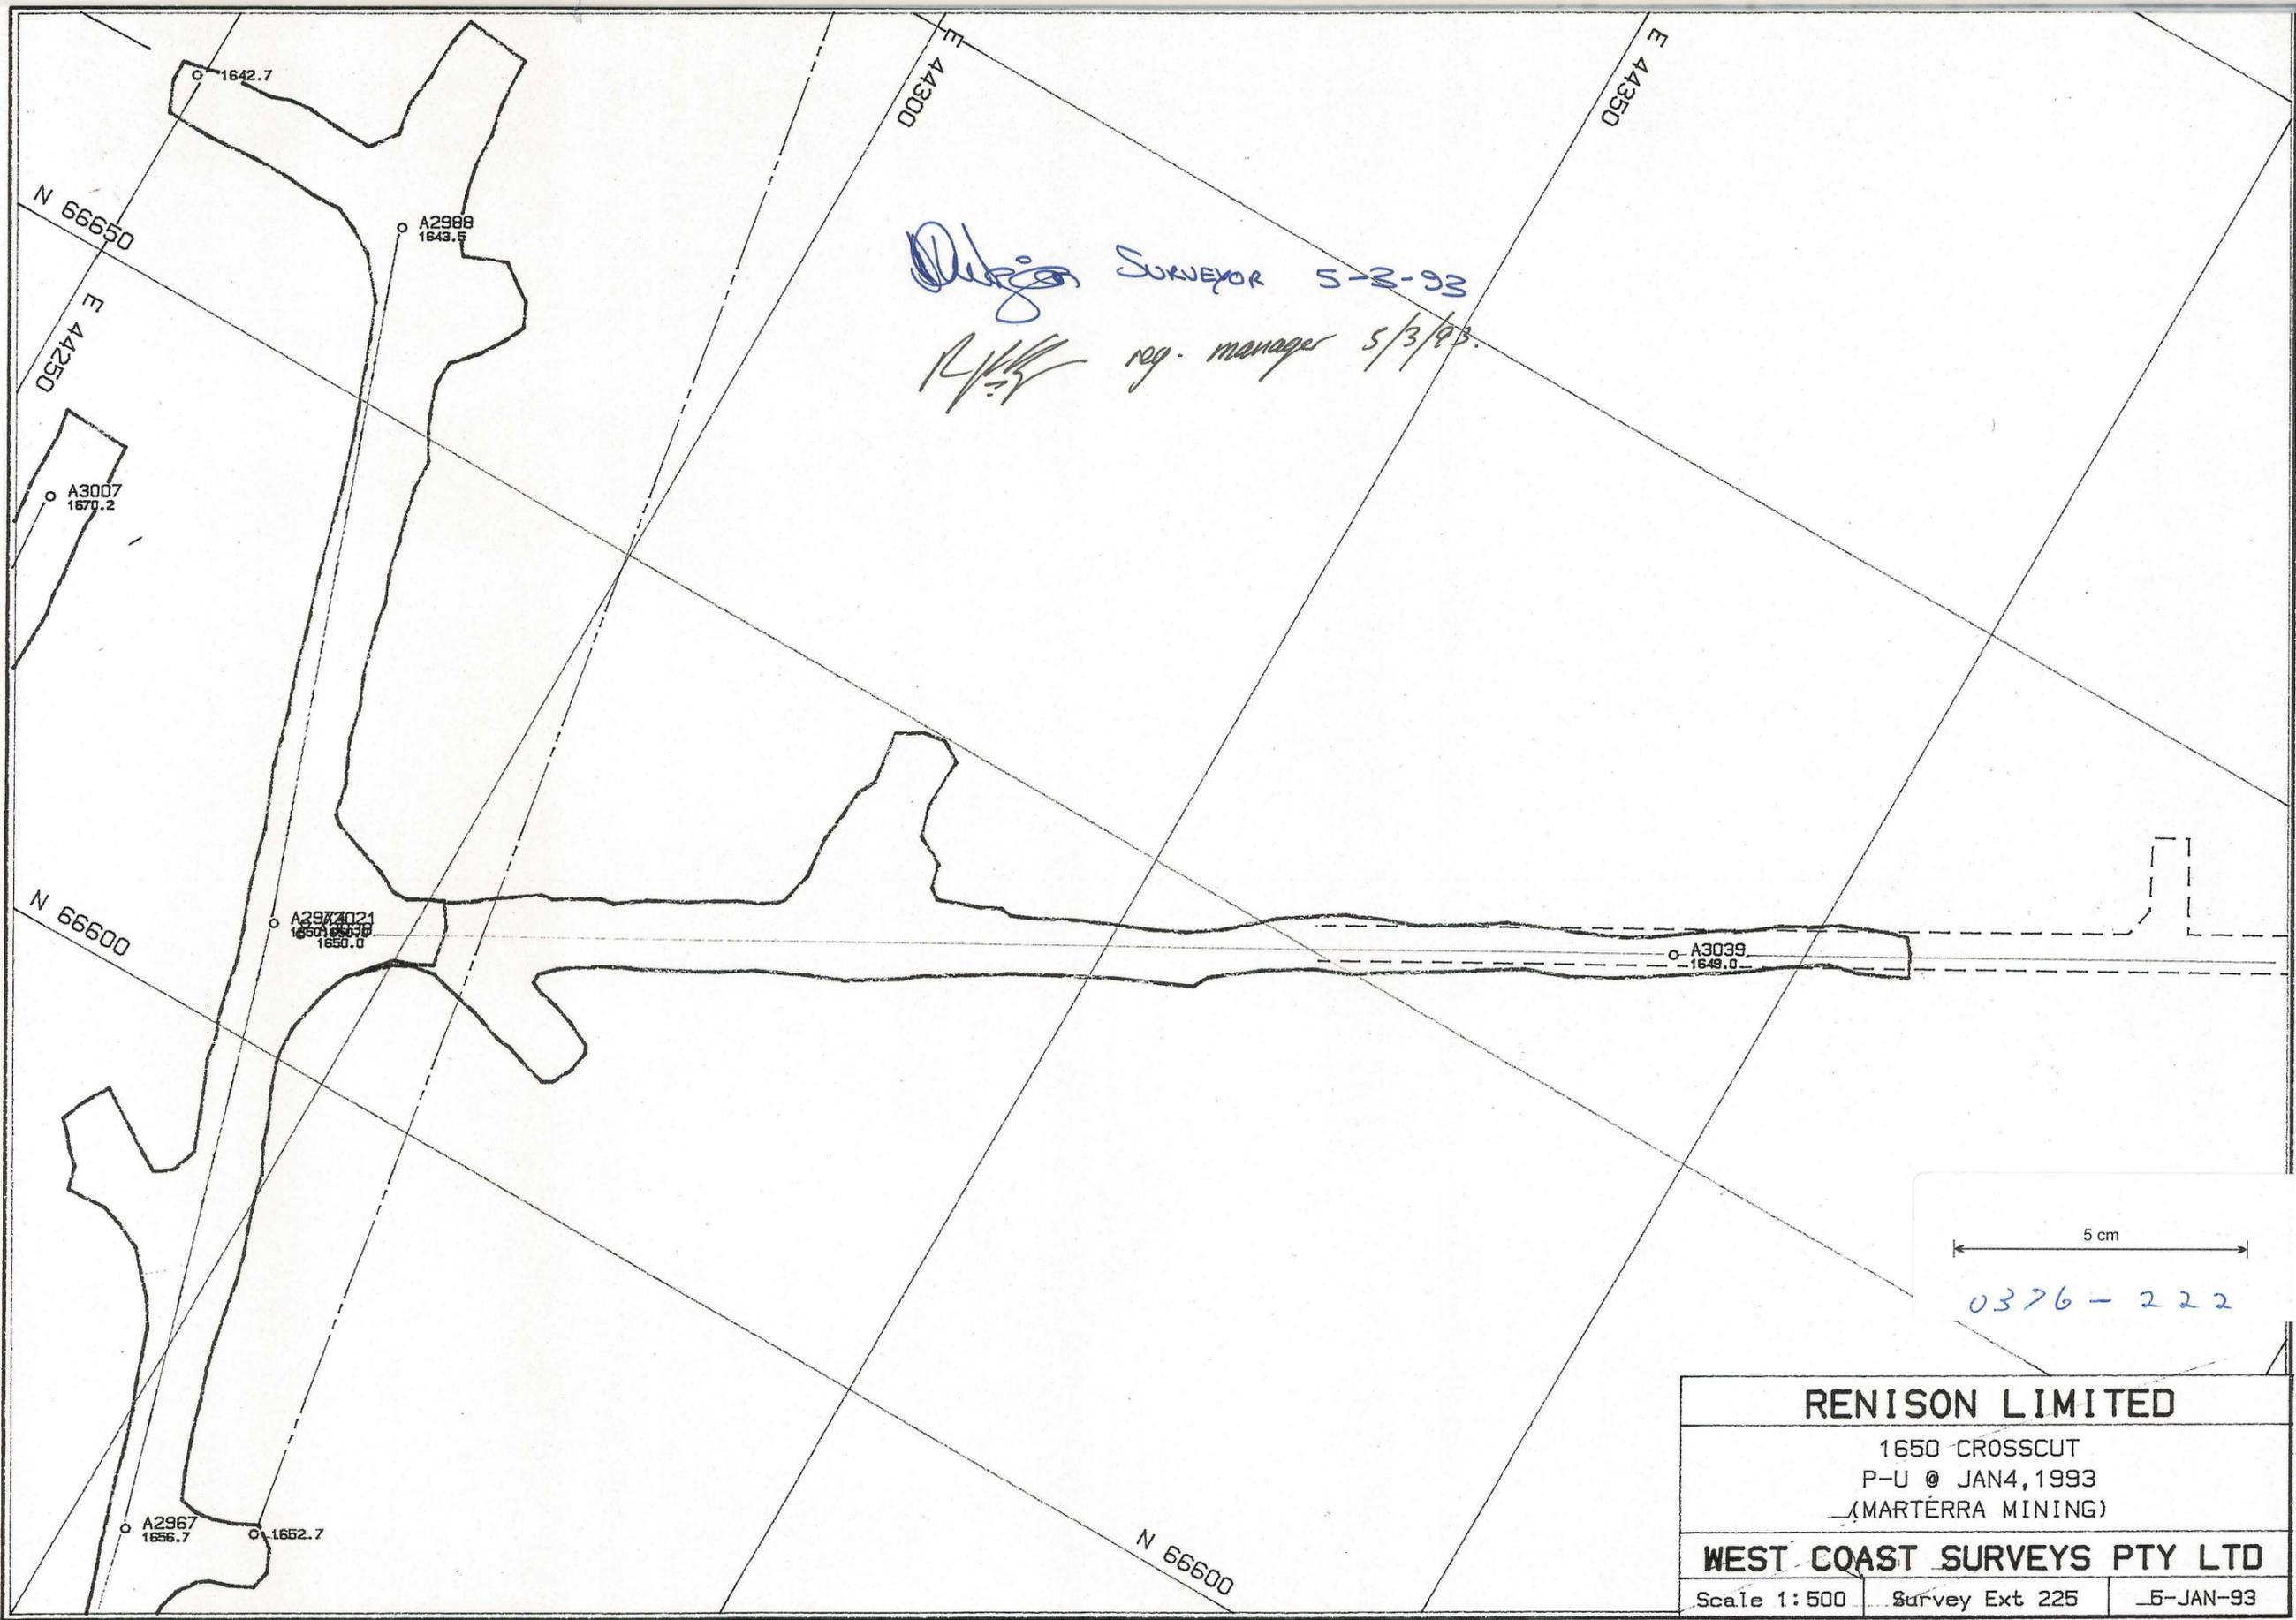

D. J. G. SURVEYOR 5-3-93
R. J. G. reg. manager 5/3/93.

5 cm
 0376-222

RENISON LIMITED		
1650 CROSSCUT		
P-U @ JAN4, 1993		
(MARTERRA MINING)		
WEST COAST SURVEYS PTY LTD		
Scale 1:500	Survey Ext 225	5-JAN-93

1650X1.PF