


0376-223

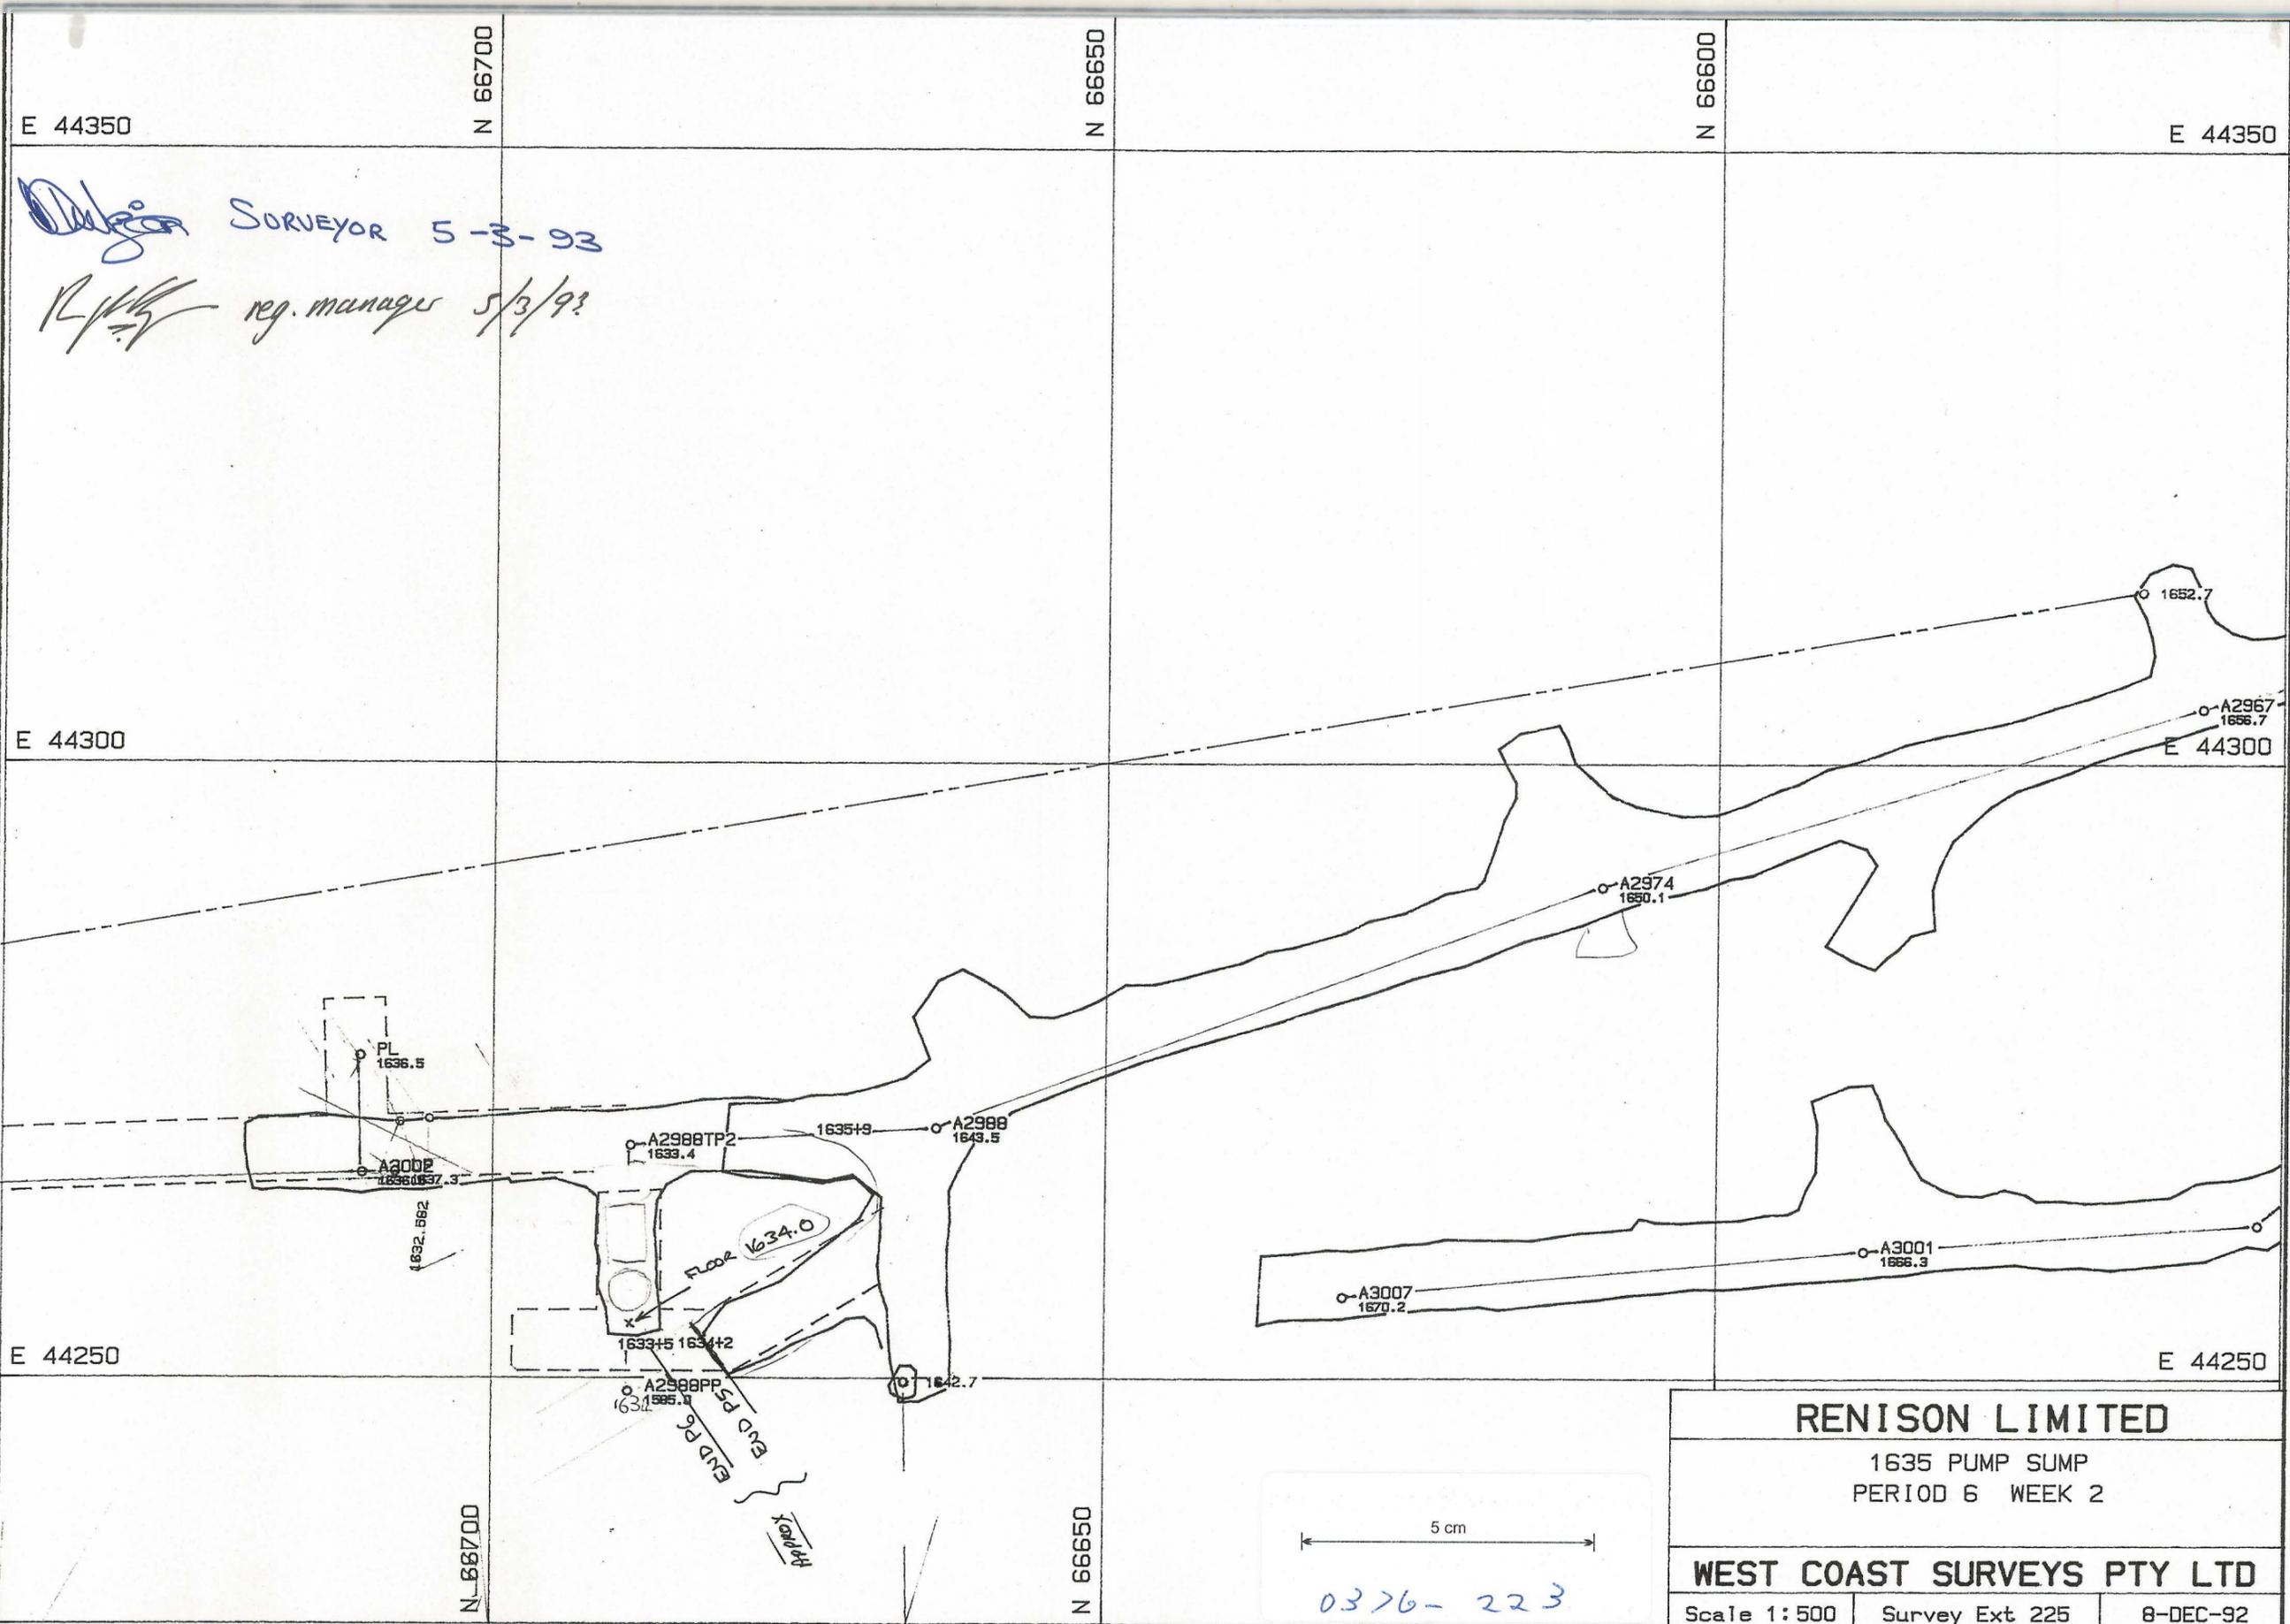

[Signature] SURVEYOR 5-3-93
[Signature] reg. manager 5/3/93

RENISON LIMITED		
1635 PUMP SUMP PERIOD 6 WEEK 2		
WEST COAST SURVEYS PTY LTD		
Scale 1:500	Survey Ext 225	8-DEC-92

5 cm
 0376-223

RENISA.PF