


0376-224

Design SURVEYOR 5-3-93
R.P.L. reg. manager 5/3/93.

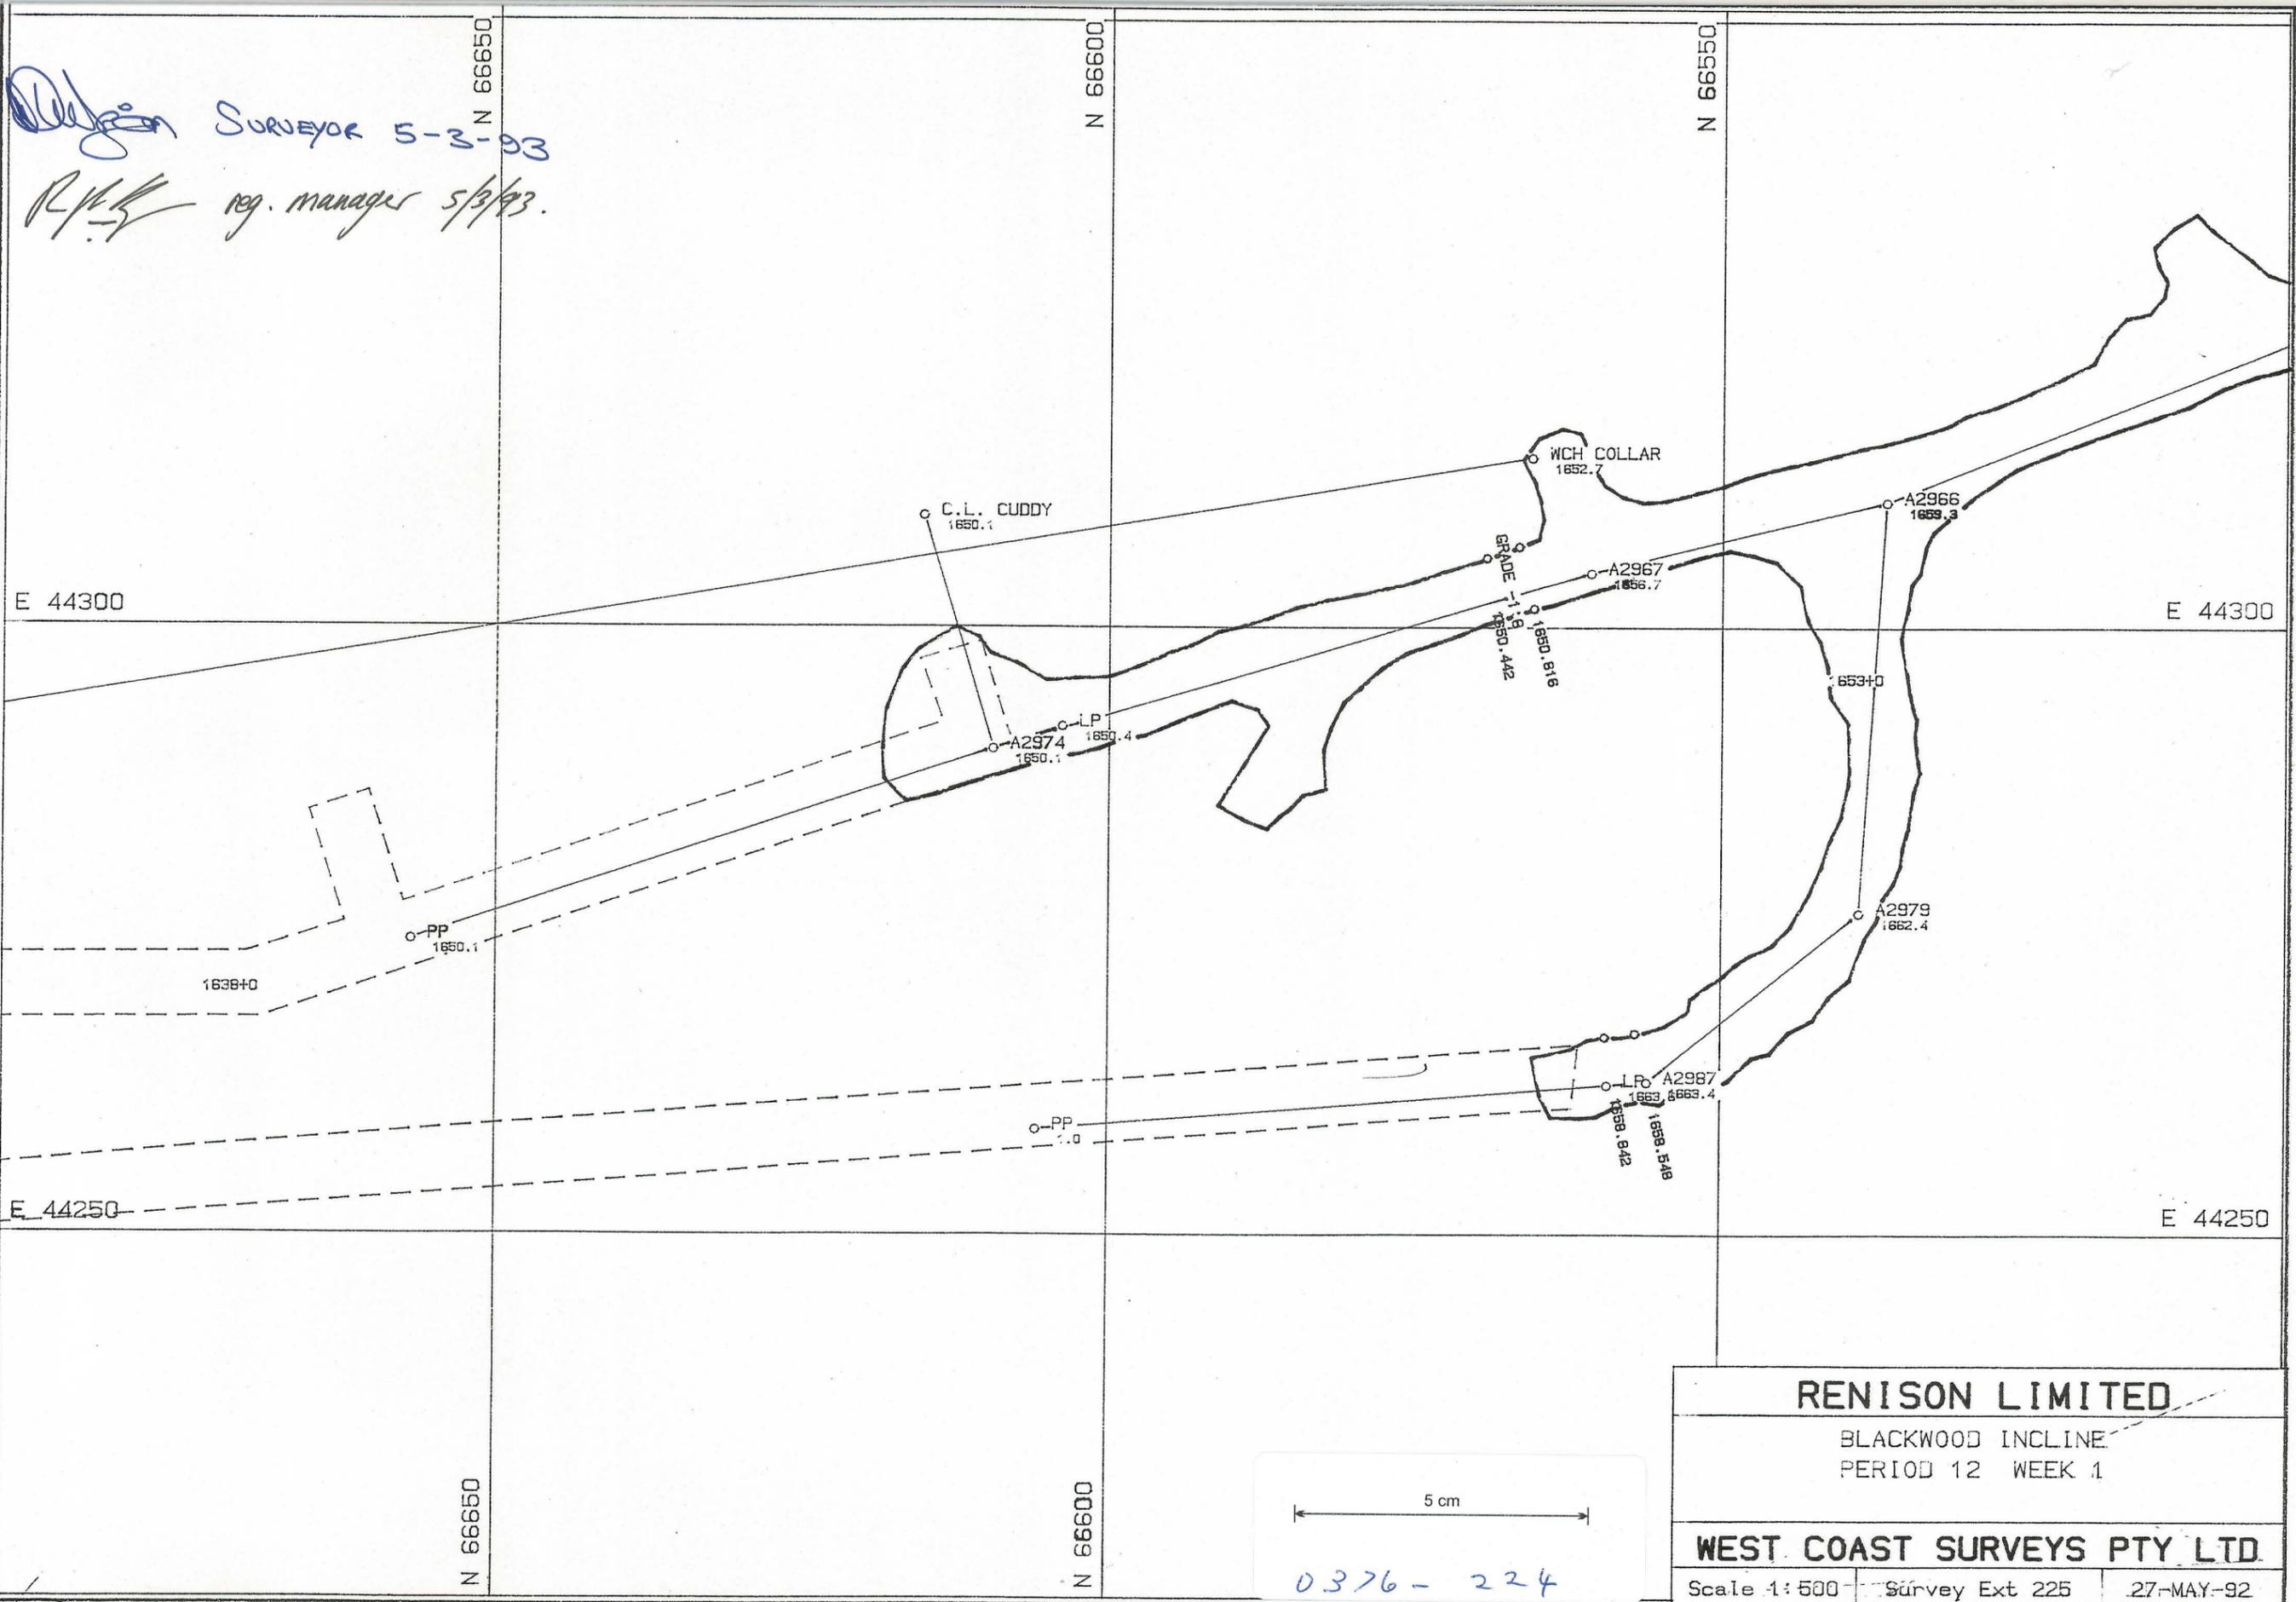

RENISON LIMITED		
BLACKWOOD INCLINE PERIOD 12 WEEK 1		
WEST COAST SURVEYS PTY LTD.		
Scale 1:500	Survey Ext 225	27-MAY-92

5 cm
0376-224