


0376-225

*Debra* SURVEYOR 5-3-93  
R.H.K. reg. manager 5/3/93.

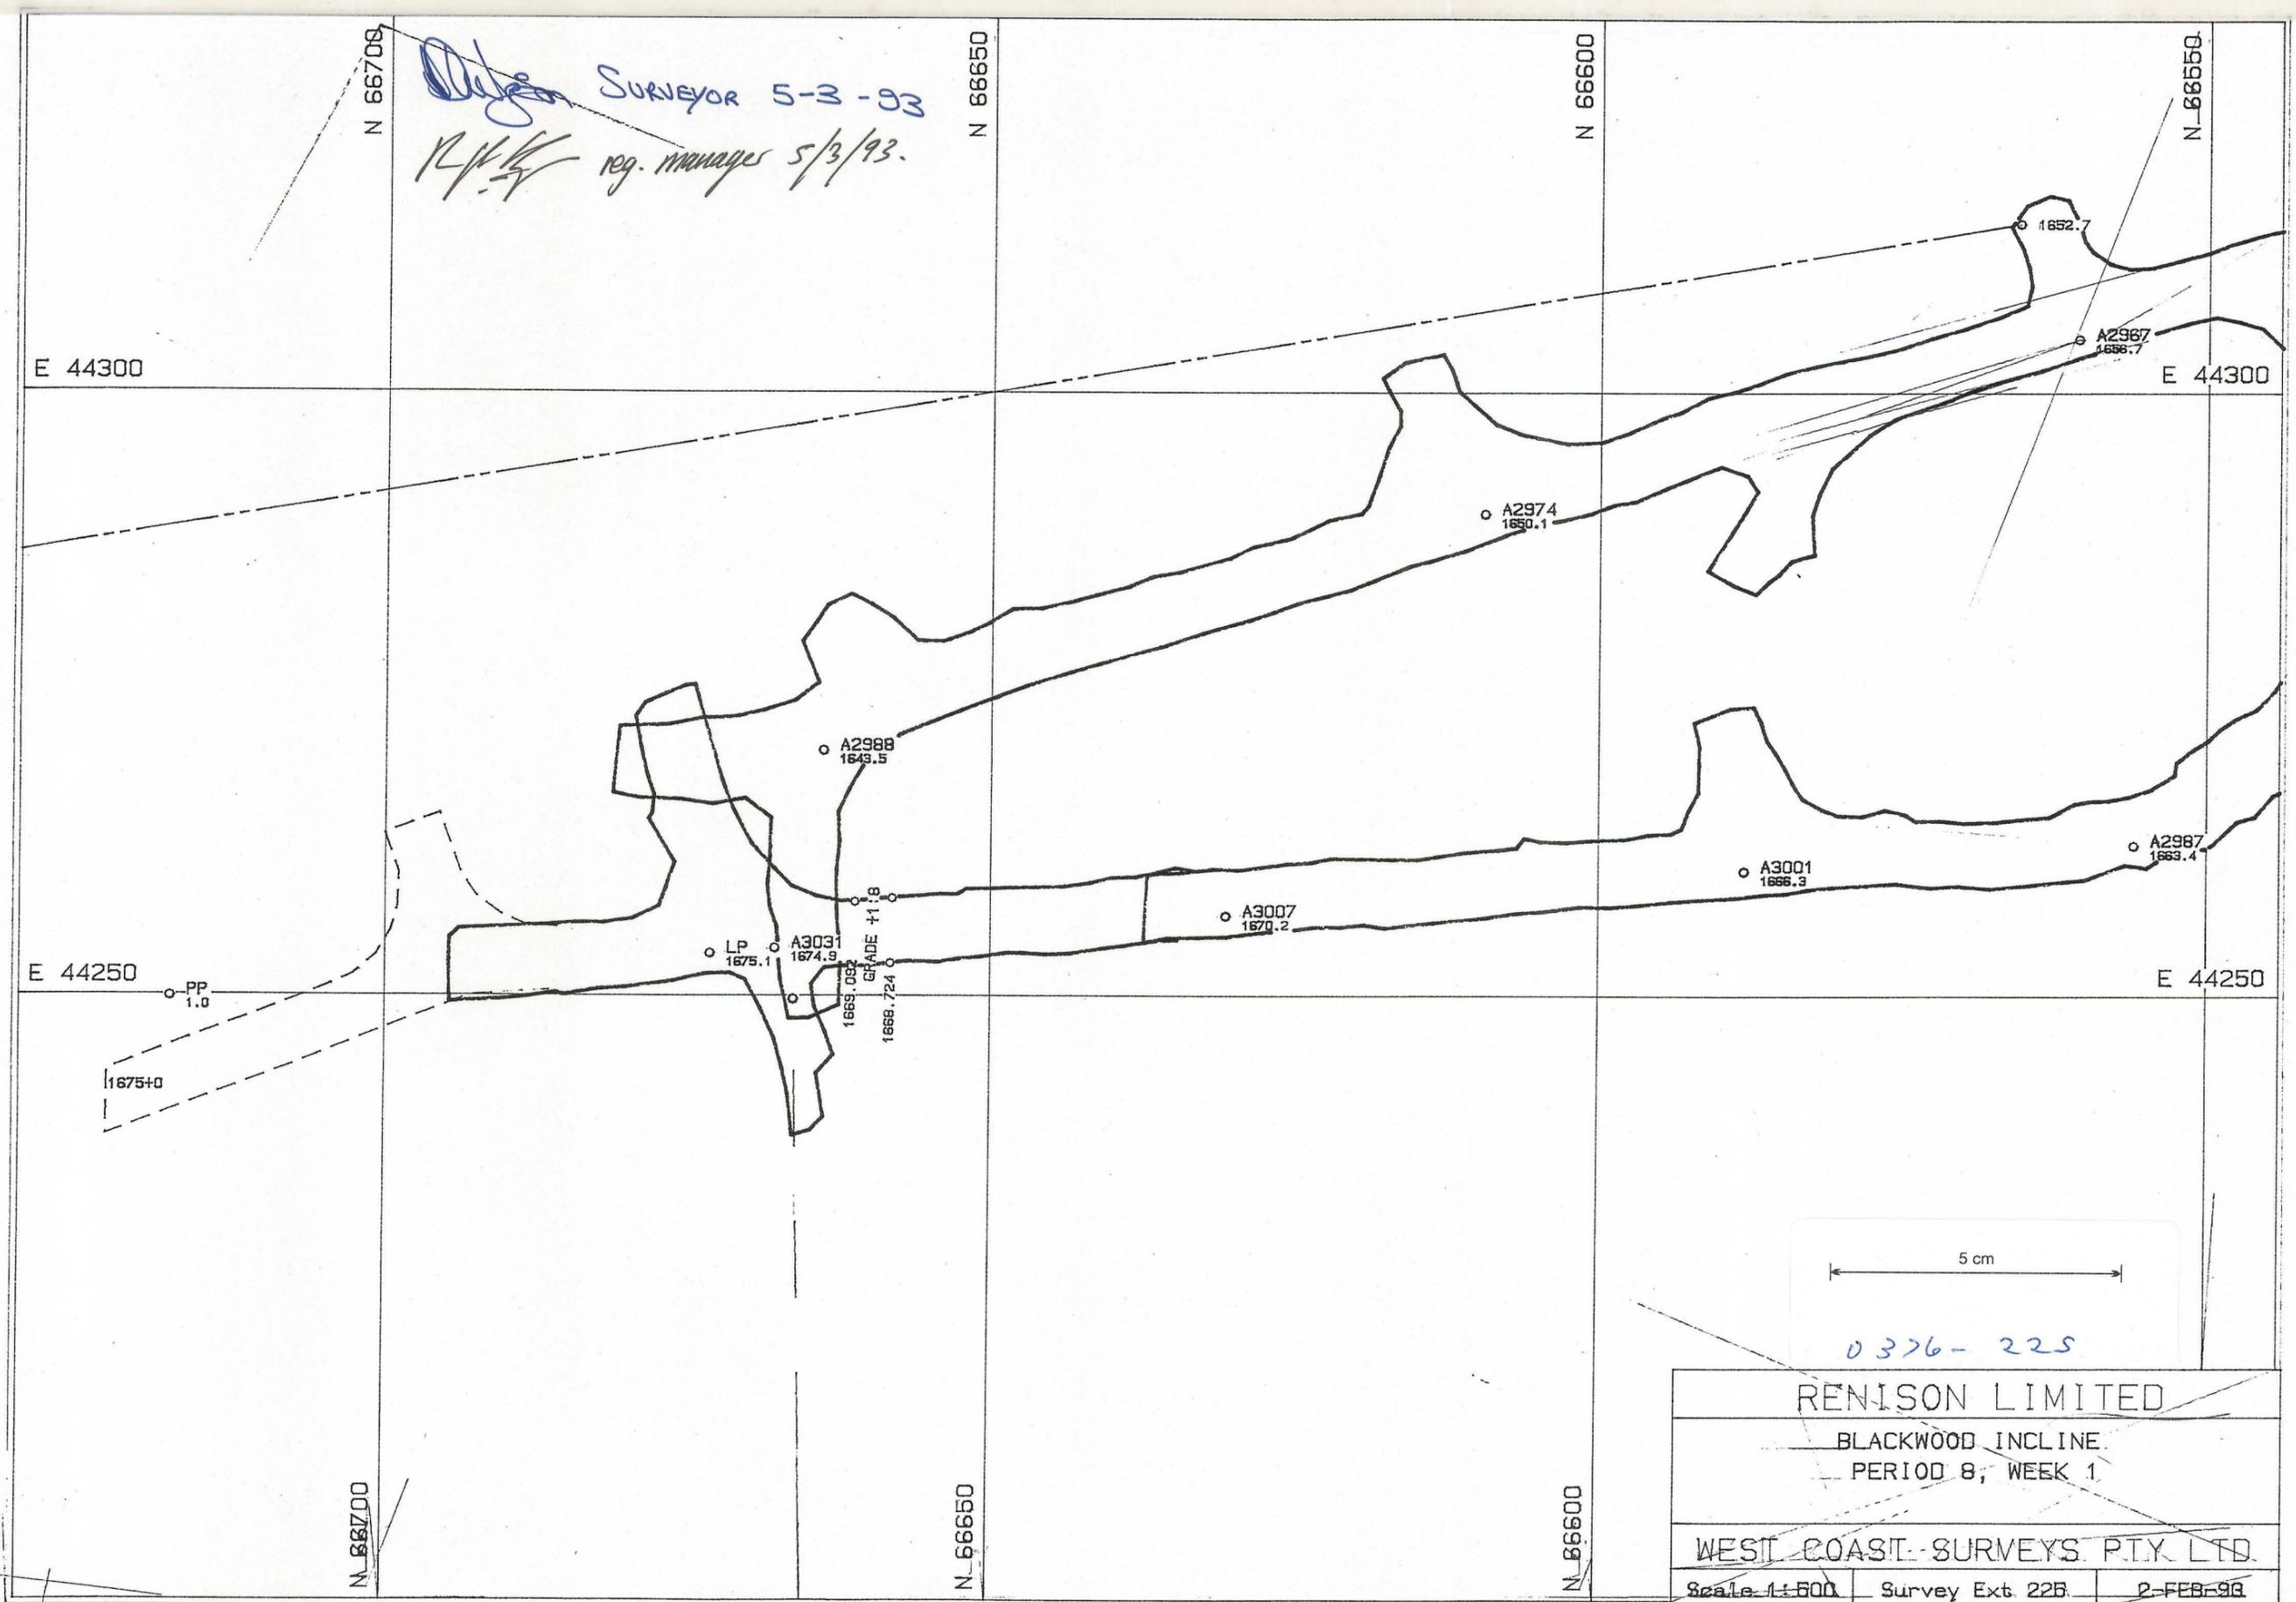

5 cm

0376-225

RENISON LIMITED		
BLACKWOOD INCLINE		
PERIOD 8, WEEK 1		
WEST COAST SURVEYS PTY LTD		
Scale 1:500	Survey Ext 22B	2-FEB-93

BEACON, PF