


0376-226

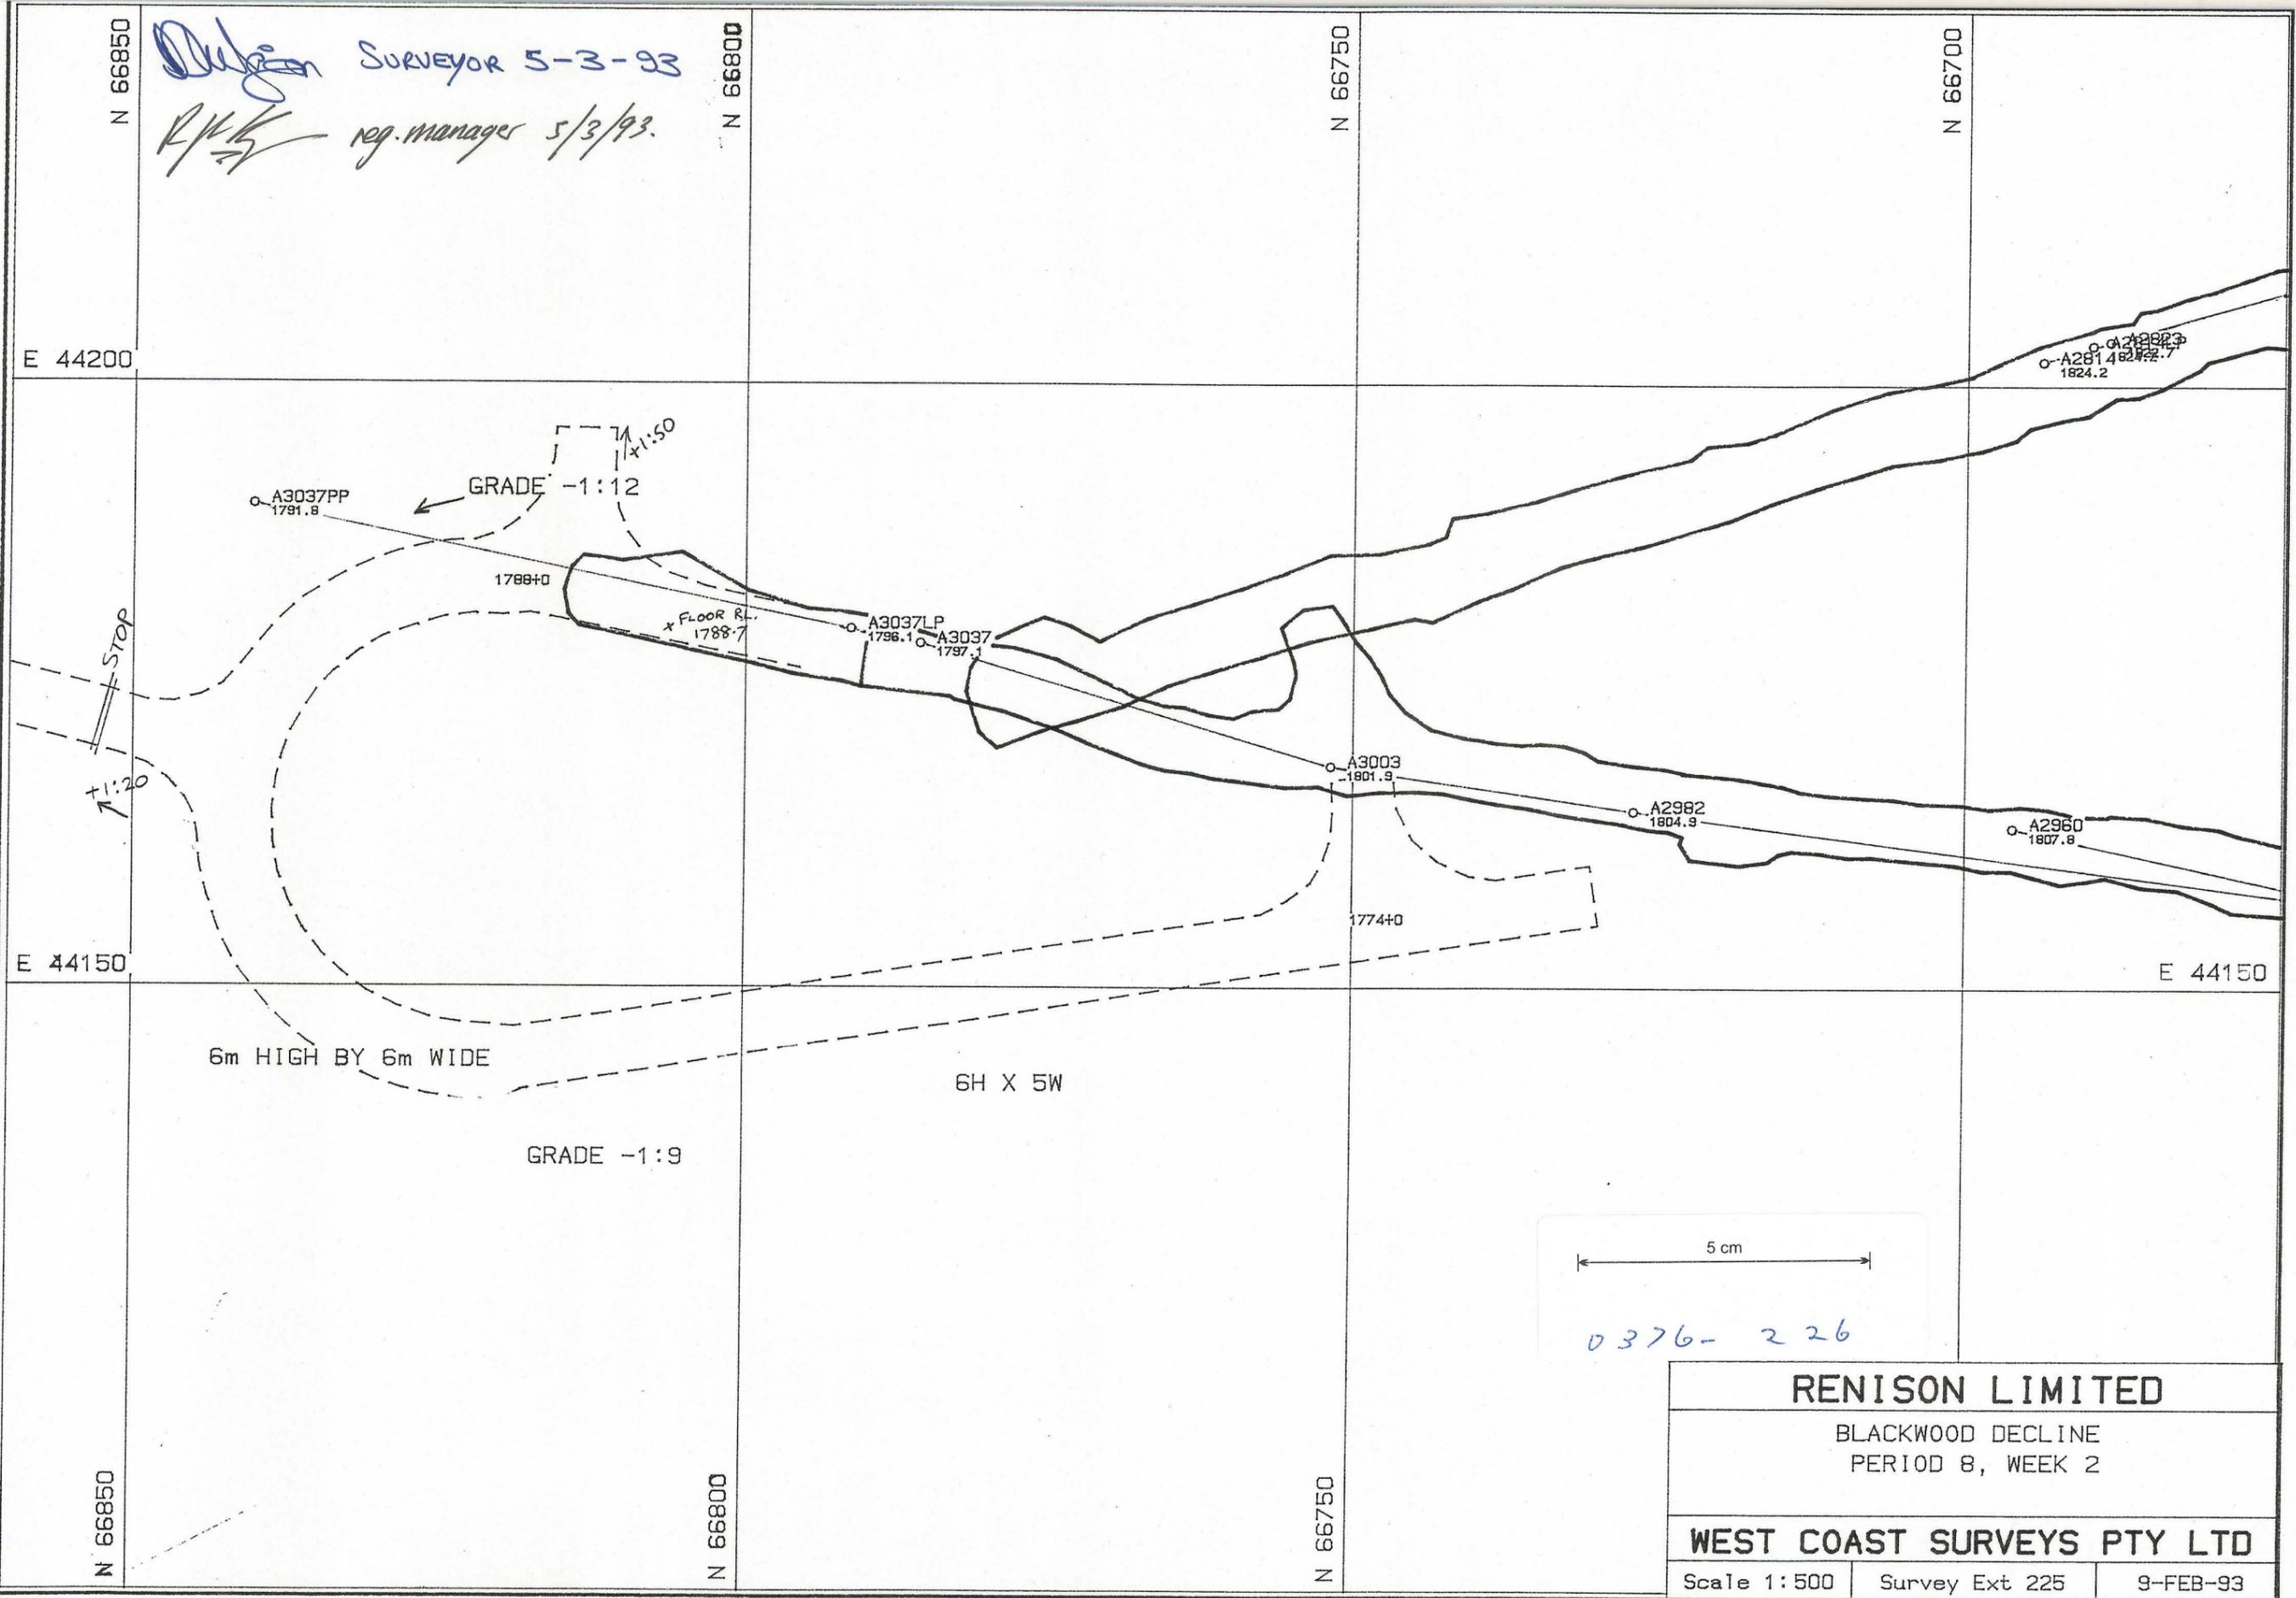

RENISON LIMITED		
BLACKWOOD DECLINE PERIOD 8, WEEK 2		
WEST COAST SURVEYS PTY LTD		
Scale 1:500	Survey Ext 225	9-FEB-93

BLACKA.PF