


0376-227

*D. Wilson* SURVEYOR 5-3-93  
*R. M. G.* reg. manager 5/3/93.

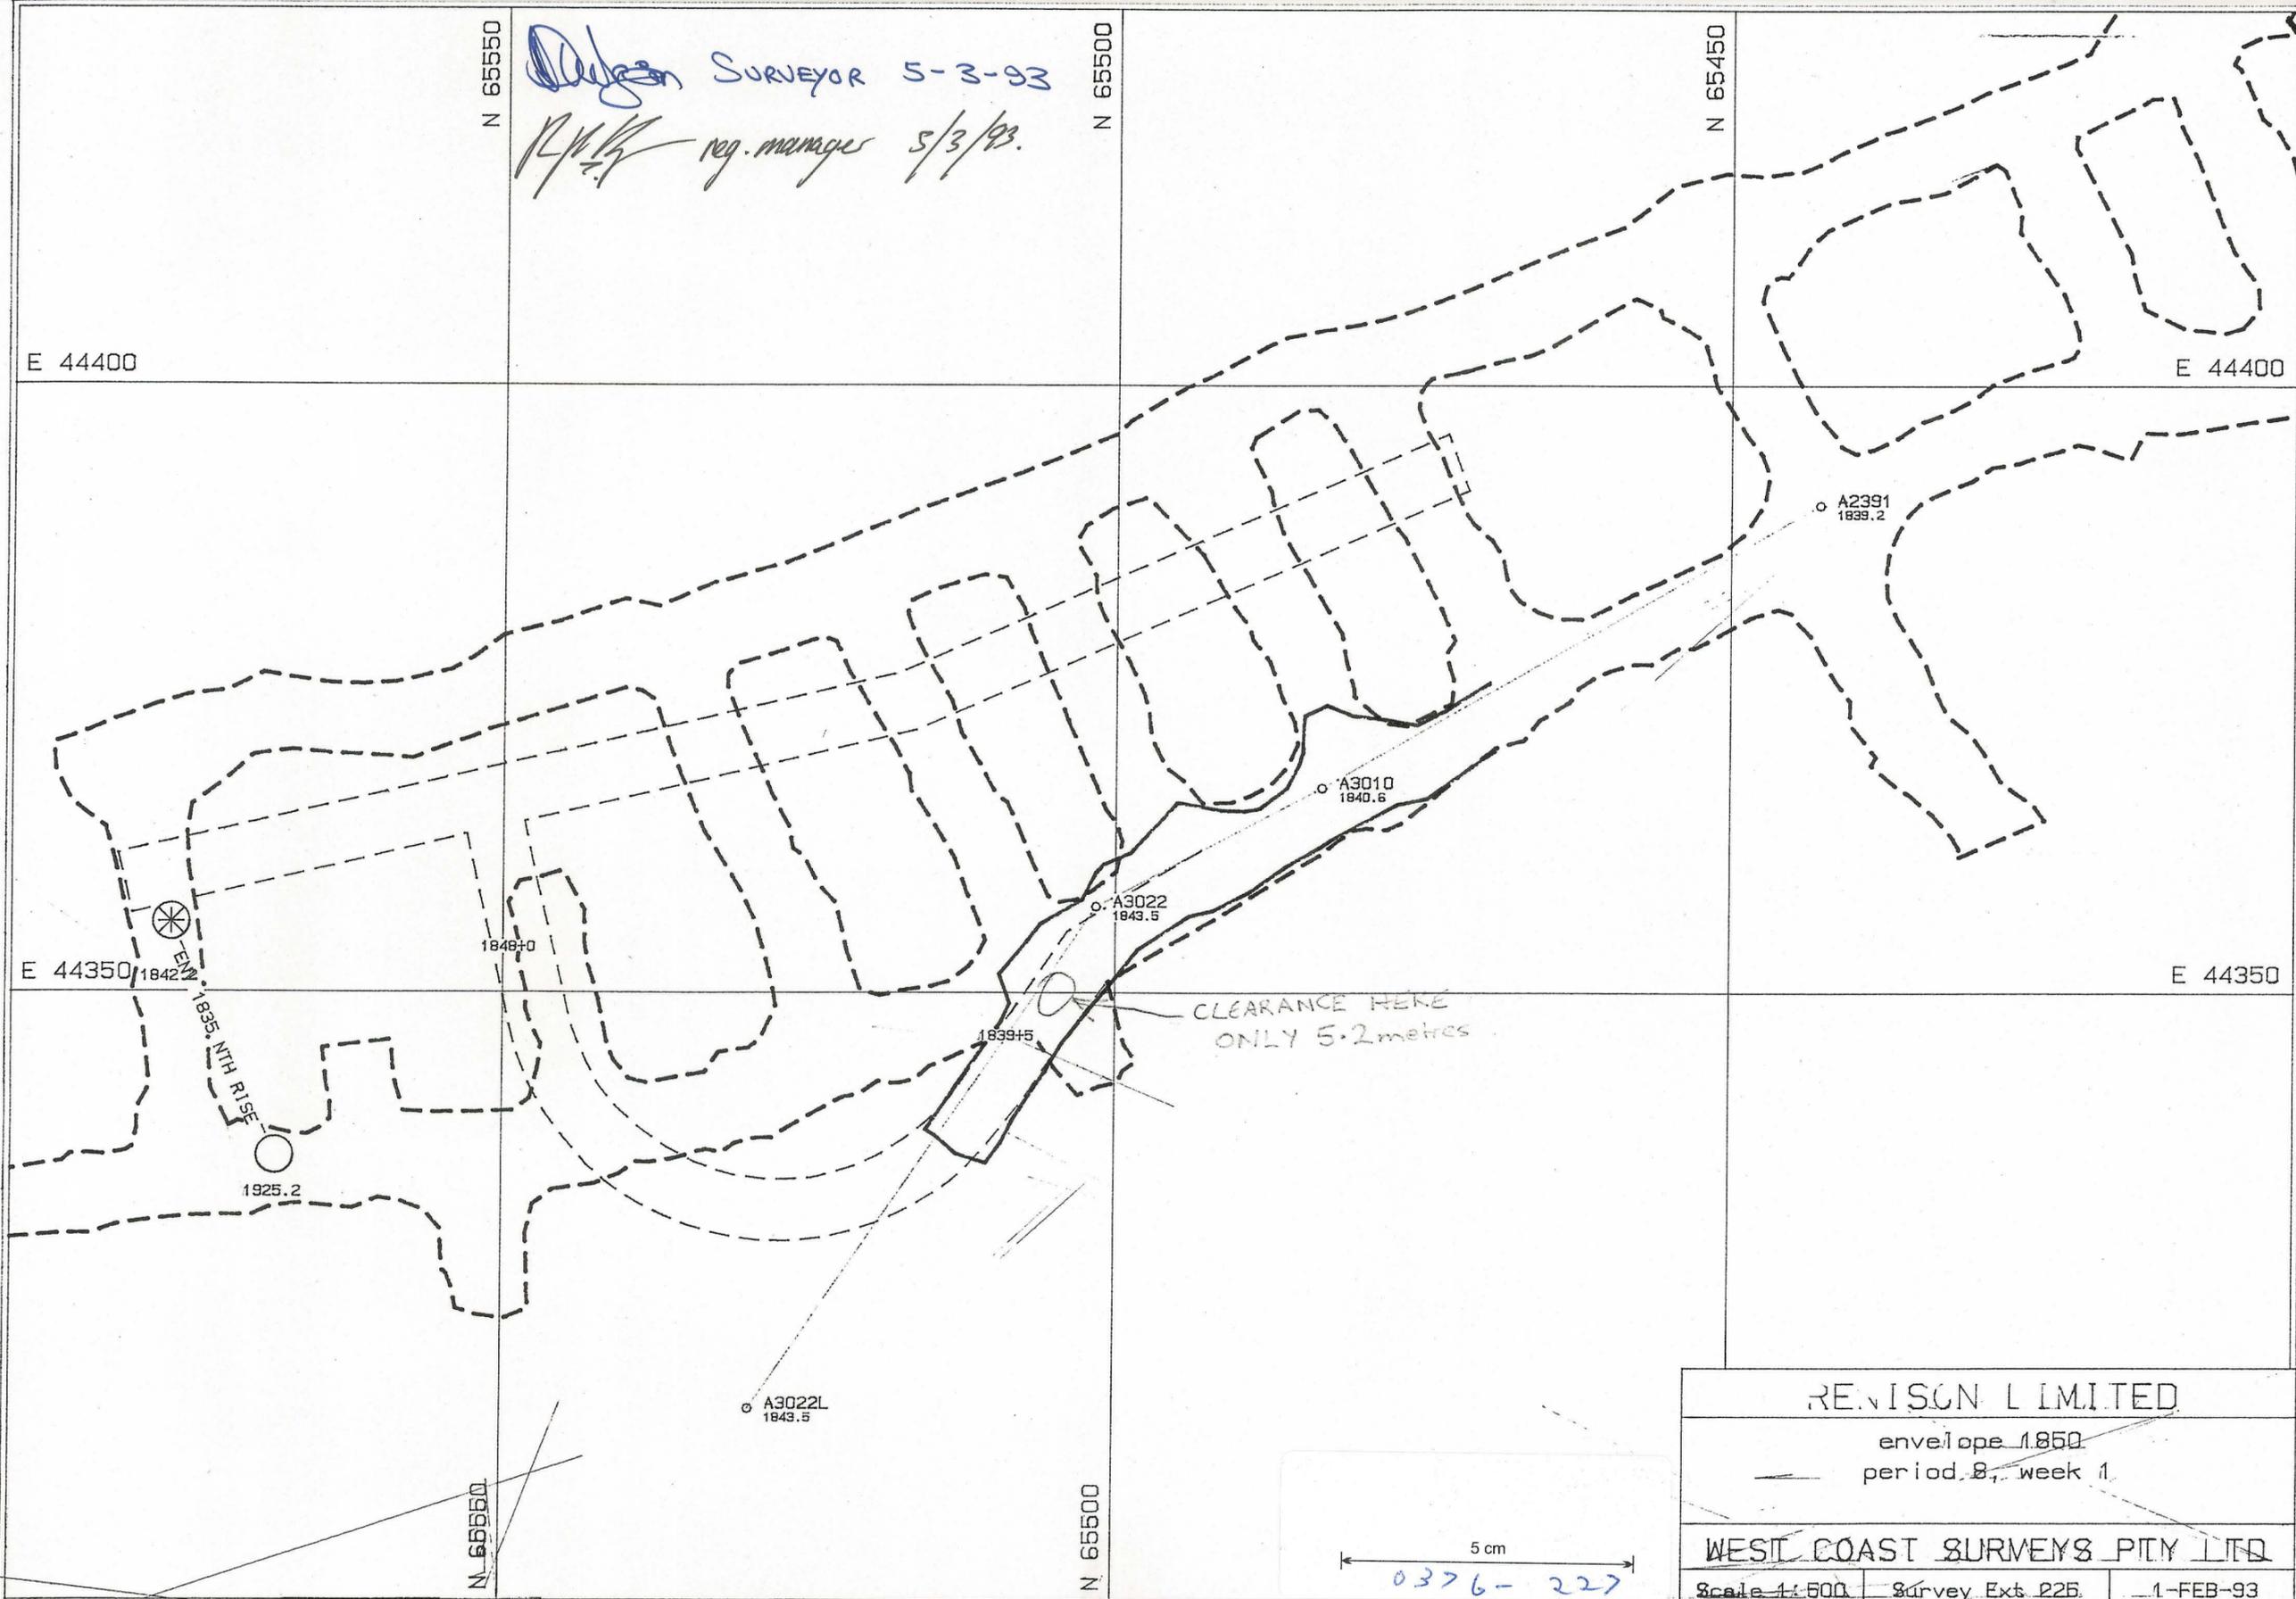

REVISION LIMITED		
envelope 1850		
period 8, week 1		
WEST COAST SURVEYS PTY LTD		
Scale 1:500	Survey Ext 225	1-FEB-93

5 cm  
0376-227

FINWELB.PK