


0376-228

N

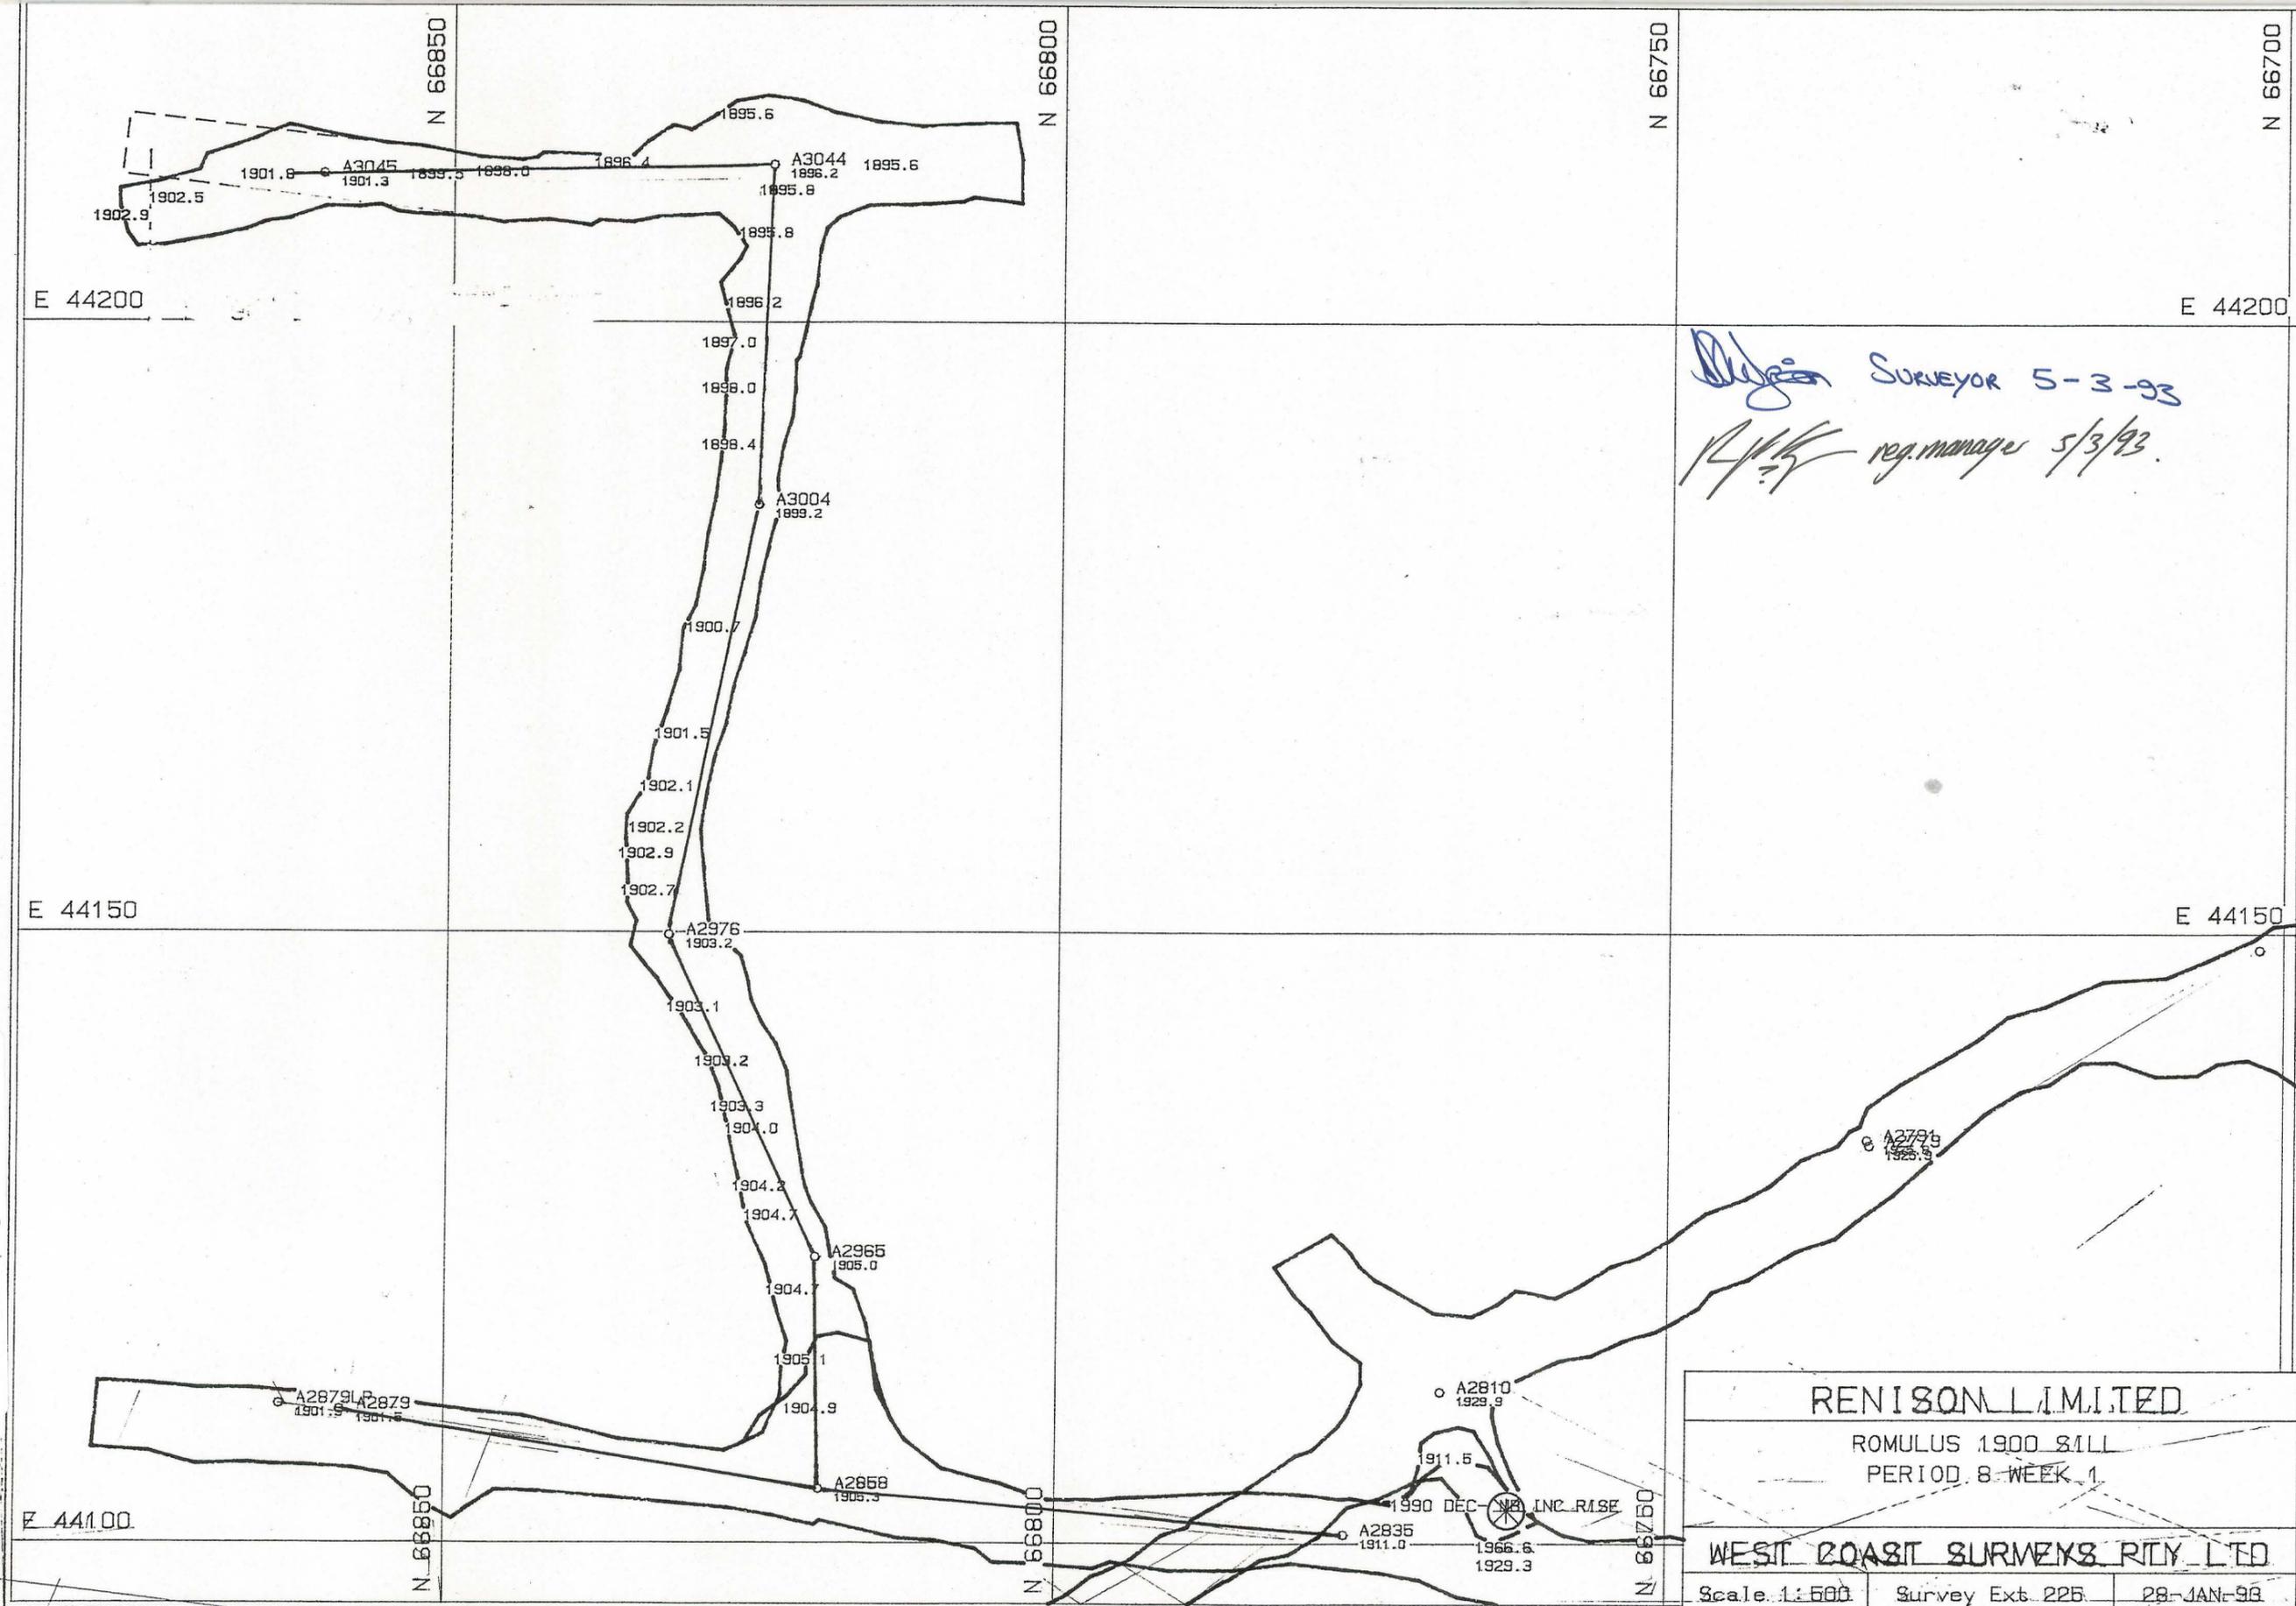

Surveyor SURVEYOR 5-3-93
reg. manager reg. manager 5/3/93.

5 cm
 0376-228

RENISON LIMITED		
ROMULUS 1900 SILL		
PERIOD 8 WEEK 1		
WEST COAST SURVEYS PTY LTD		
Scale 1:500	Survey Ext. 225	28-JAN-98

ROMULA RE