


0376-228

Dalgin SURVEYOR 5-3-93

R/S reg. manager 5/3/93.

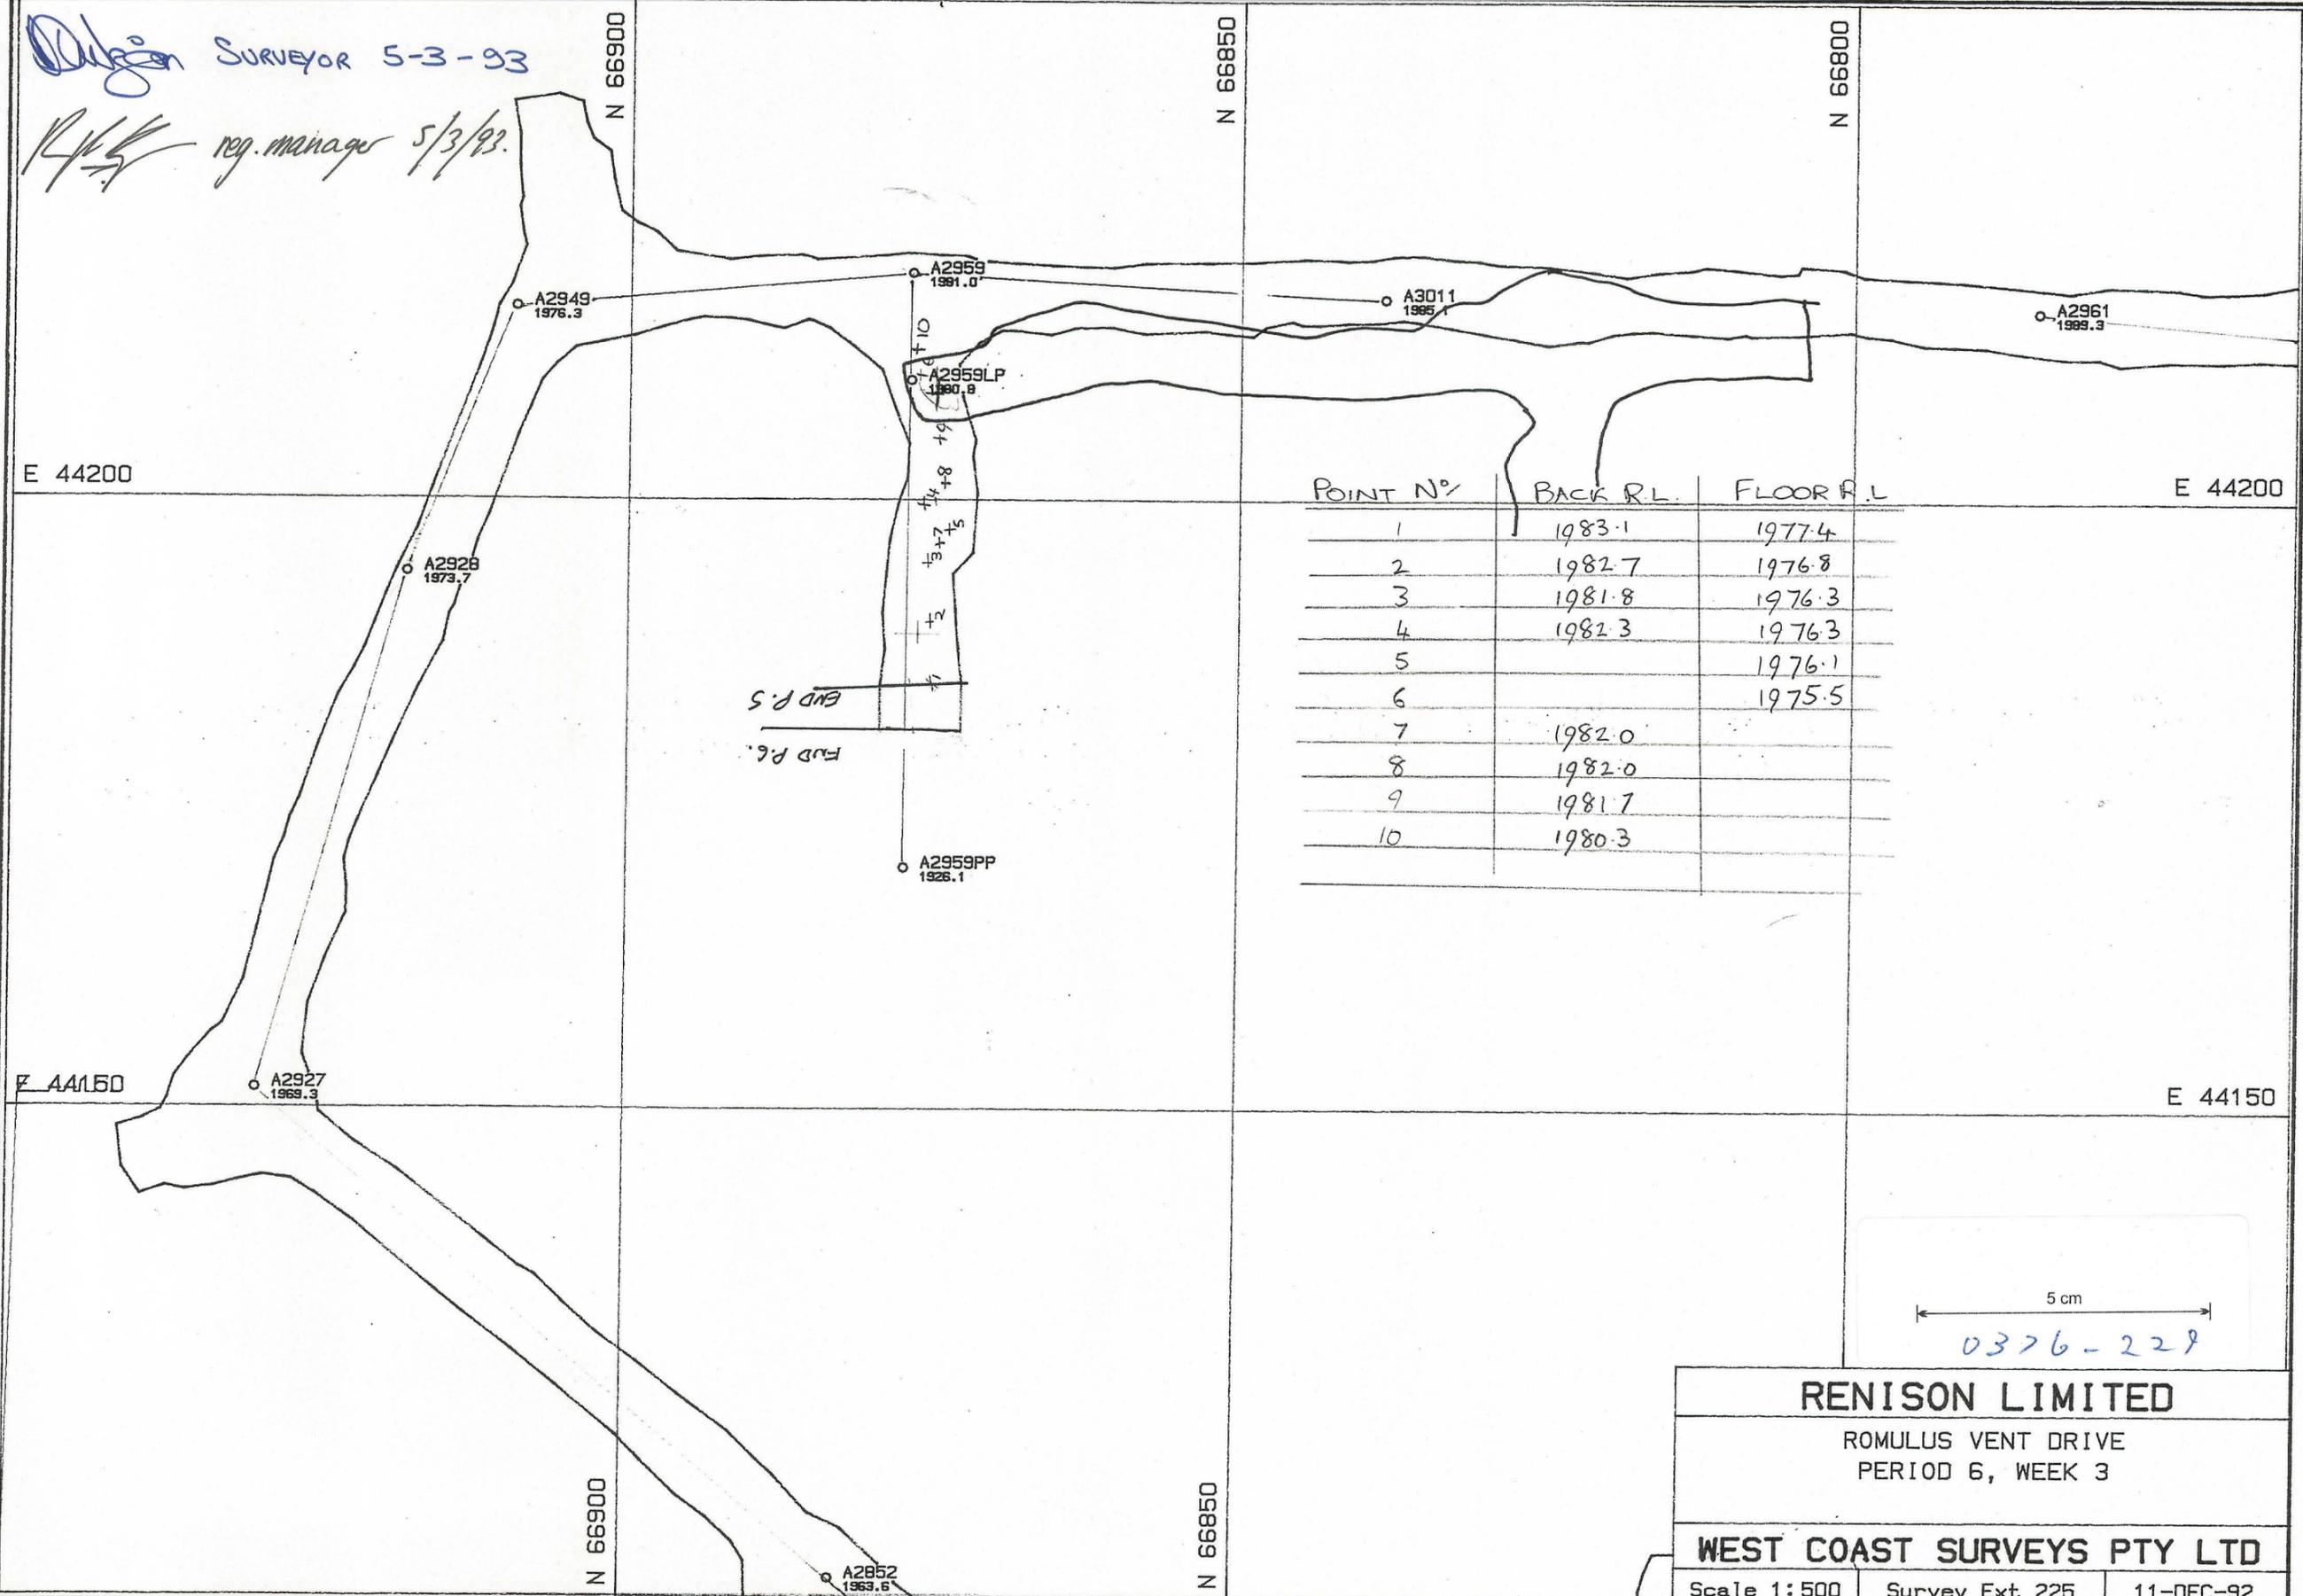

POINT N°	BACK R.L.	FLOOR R.L.
1	1983.1	1977.4
2	1982.7	1976.8
3	1981.8	1976.3
4	1982.3	1976.3
5		1976.1
6		1975.5
7	1982.0	
8	1982.0	
9	1981.7	
10	1980.3	

5 cm
0376-228

RENISON LIMITED
 ROMULUS VENT DRIVE
 PERIOD 6, WEEK 3

WEST COAST SURVEYS PTY LTD
 Scale 1:500 | Survey Ext 225 | 11-DEC-92