


0376-232

Dalgin Surveyor 5-3-93
R. J. K. reg. manager 5/3/93.

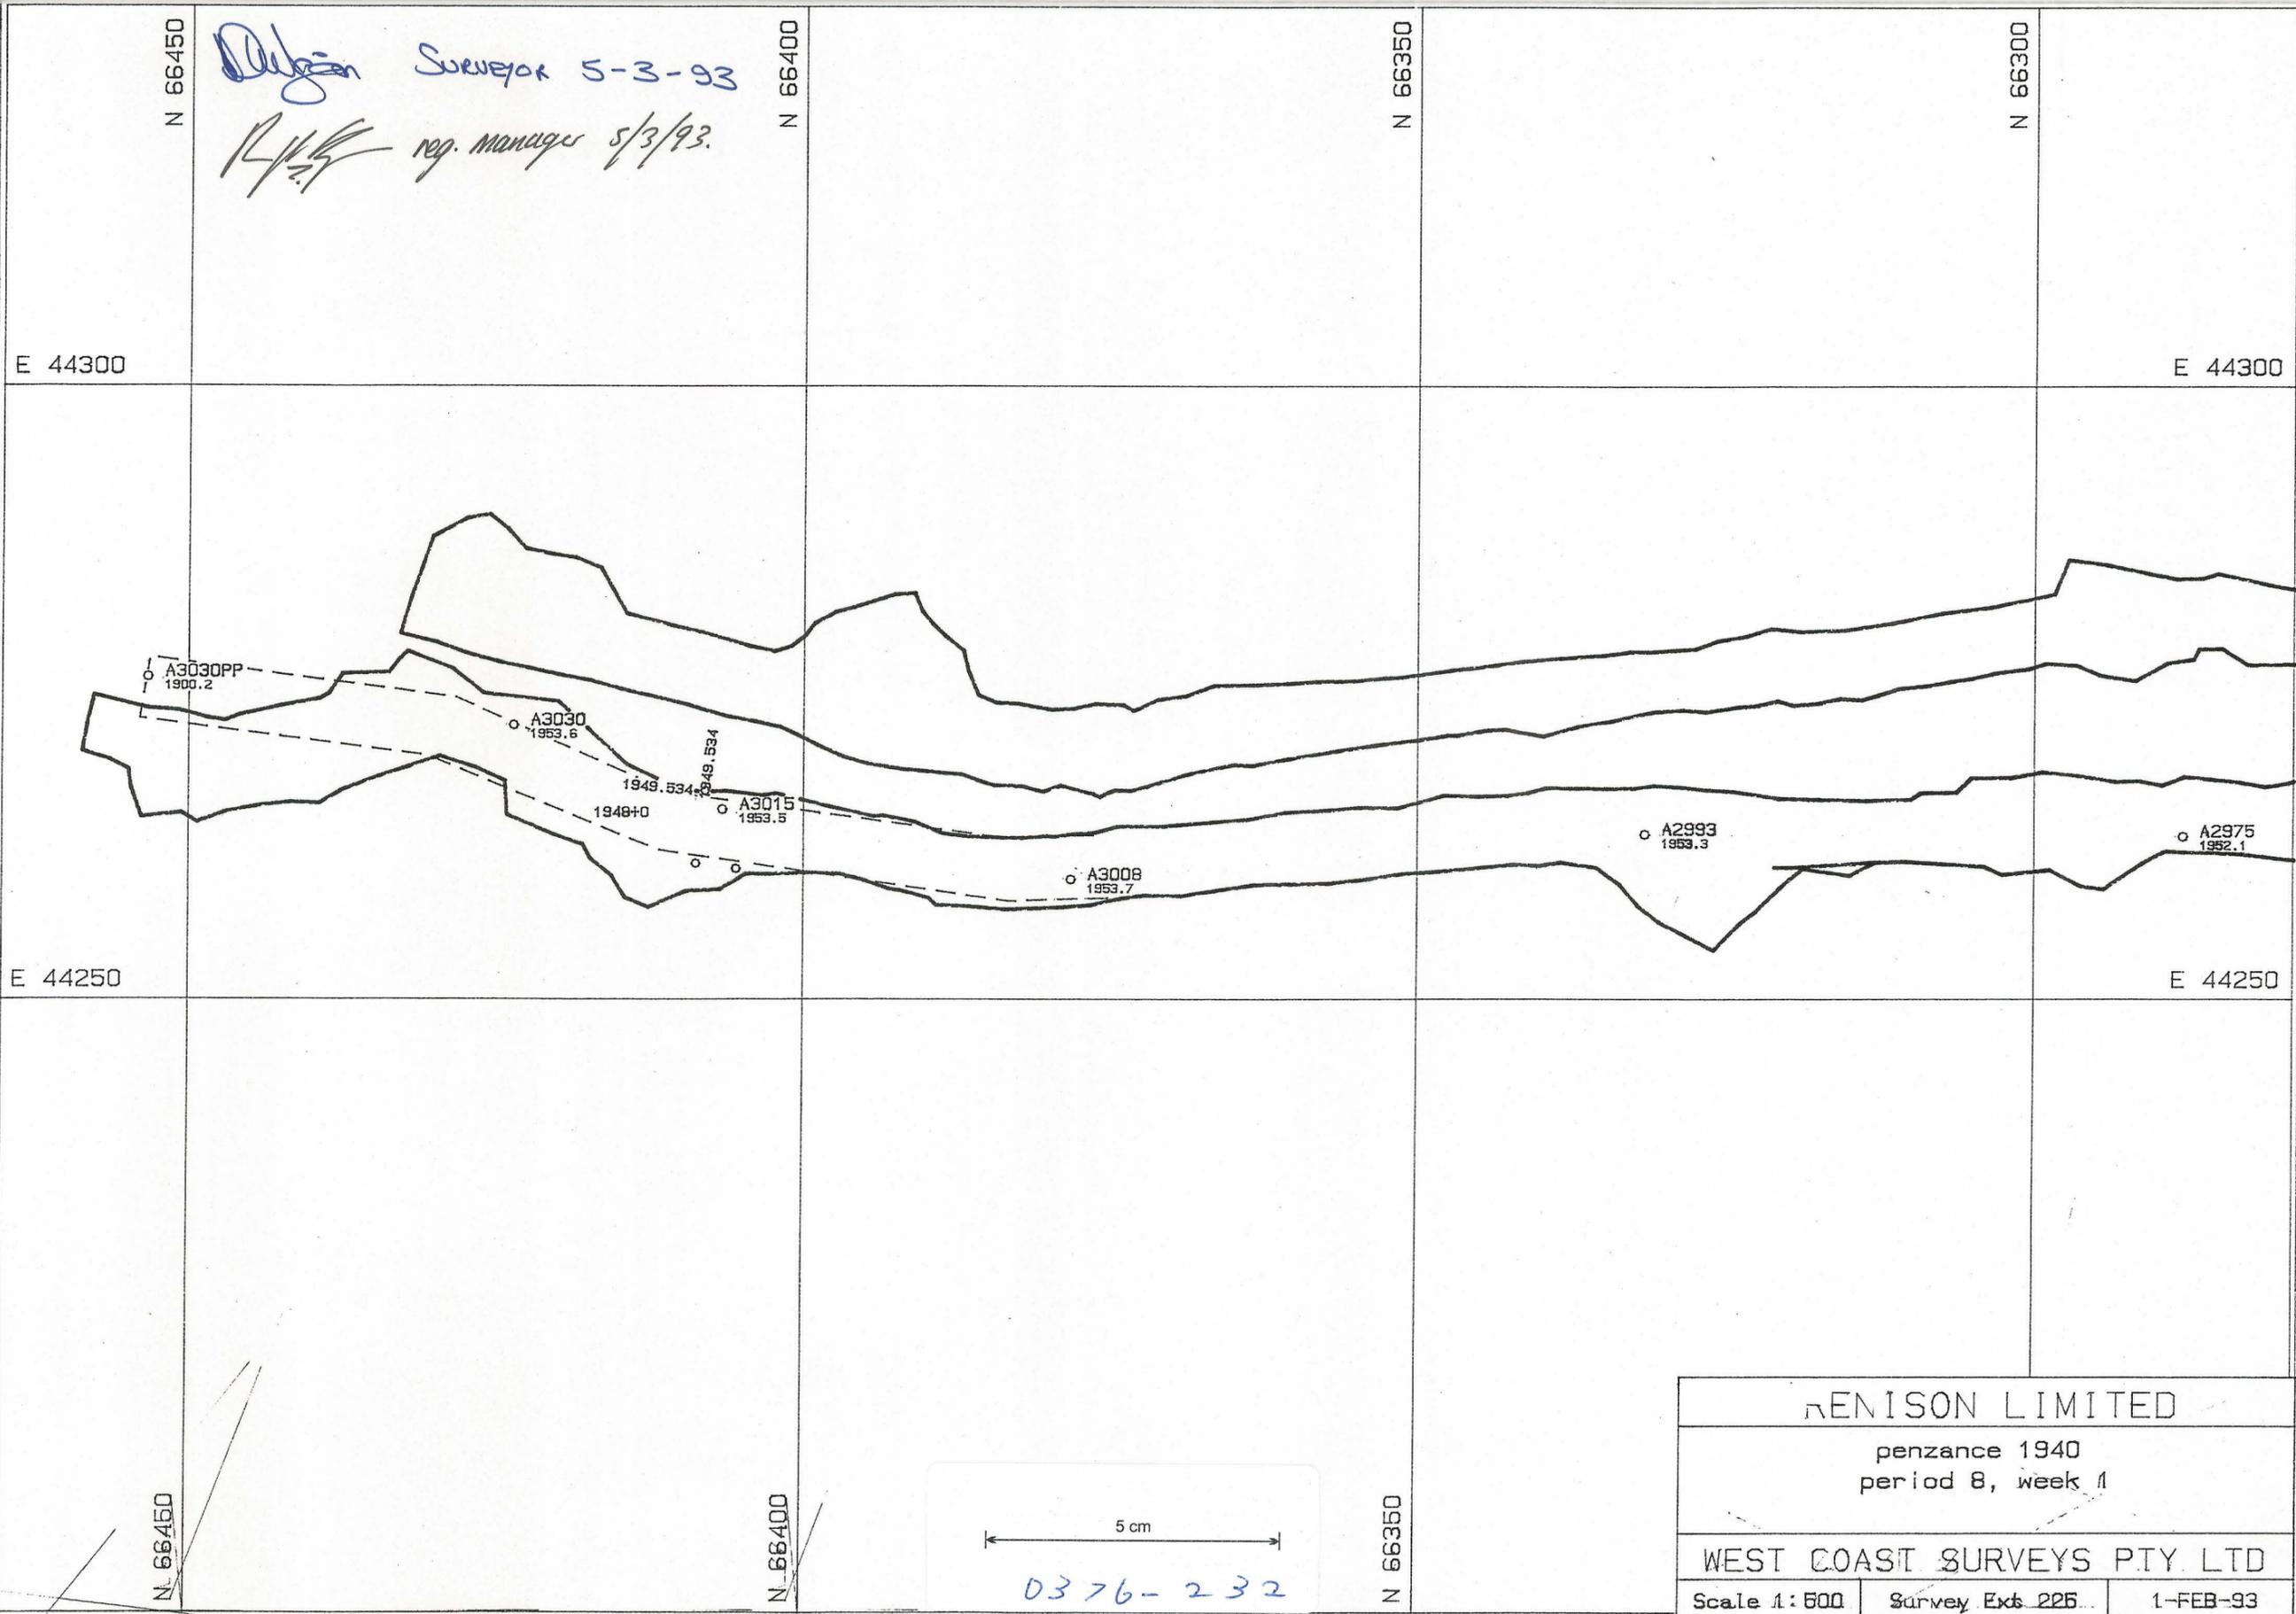

PENISON LIMITED		
penzance 1940 period 8, week 1		
WEST COAST SURVEYS PTY. LTD		
Scale 1:500	Survey Ext. 225	1-FEB-93

PENZANCE PF