


0376-234

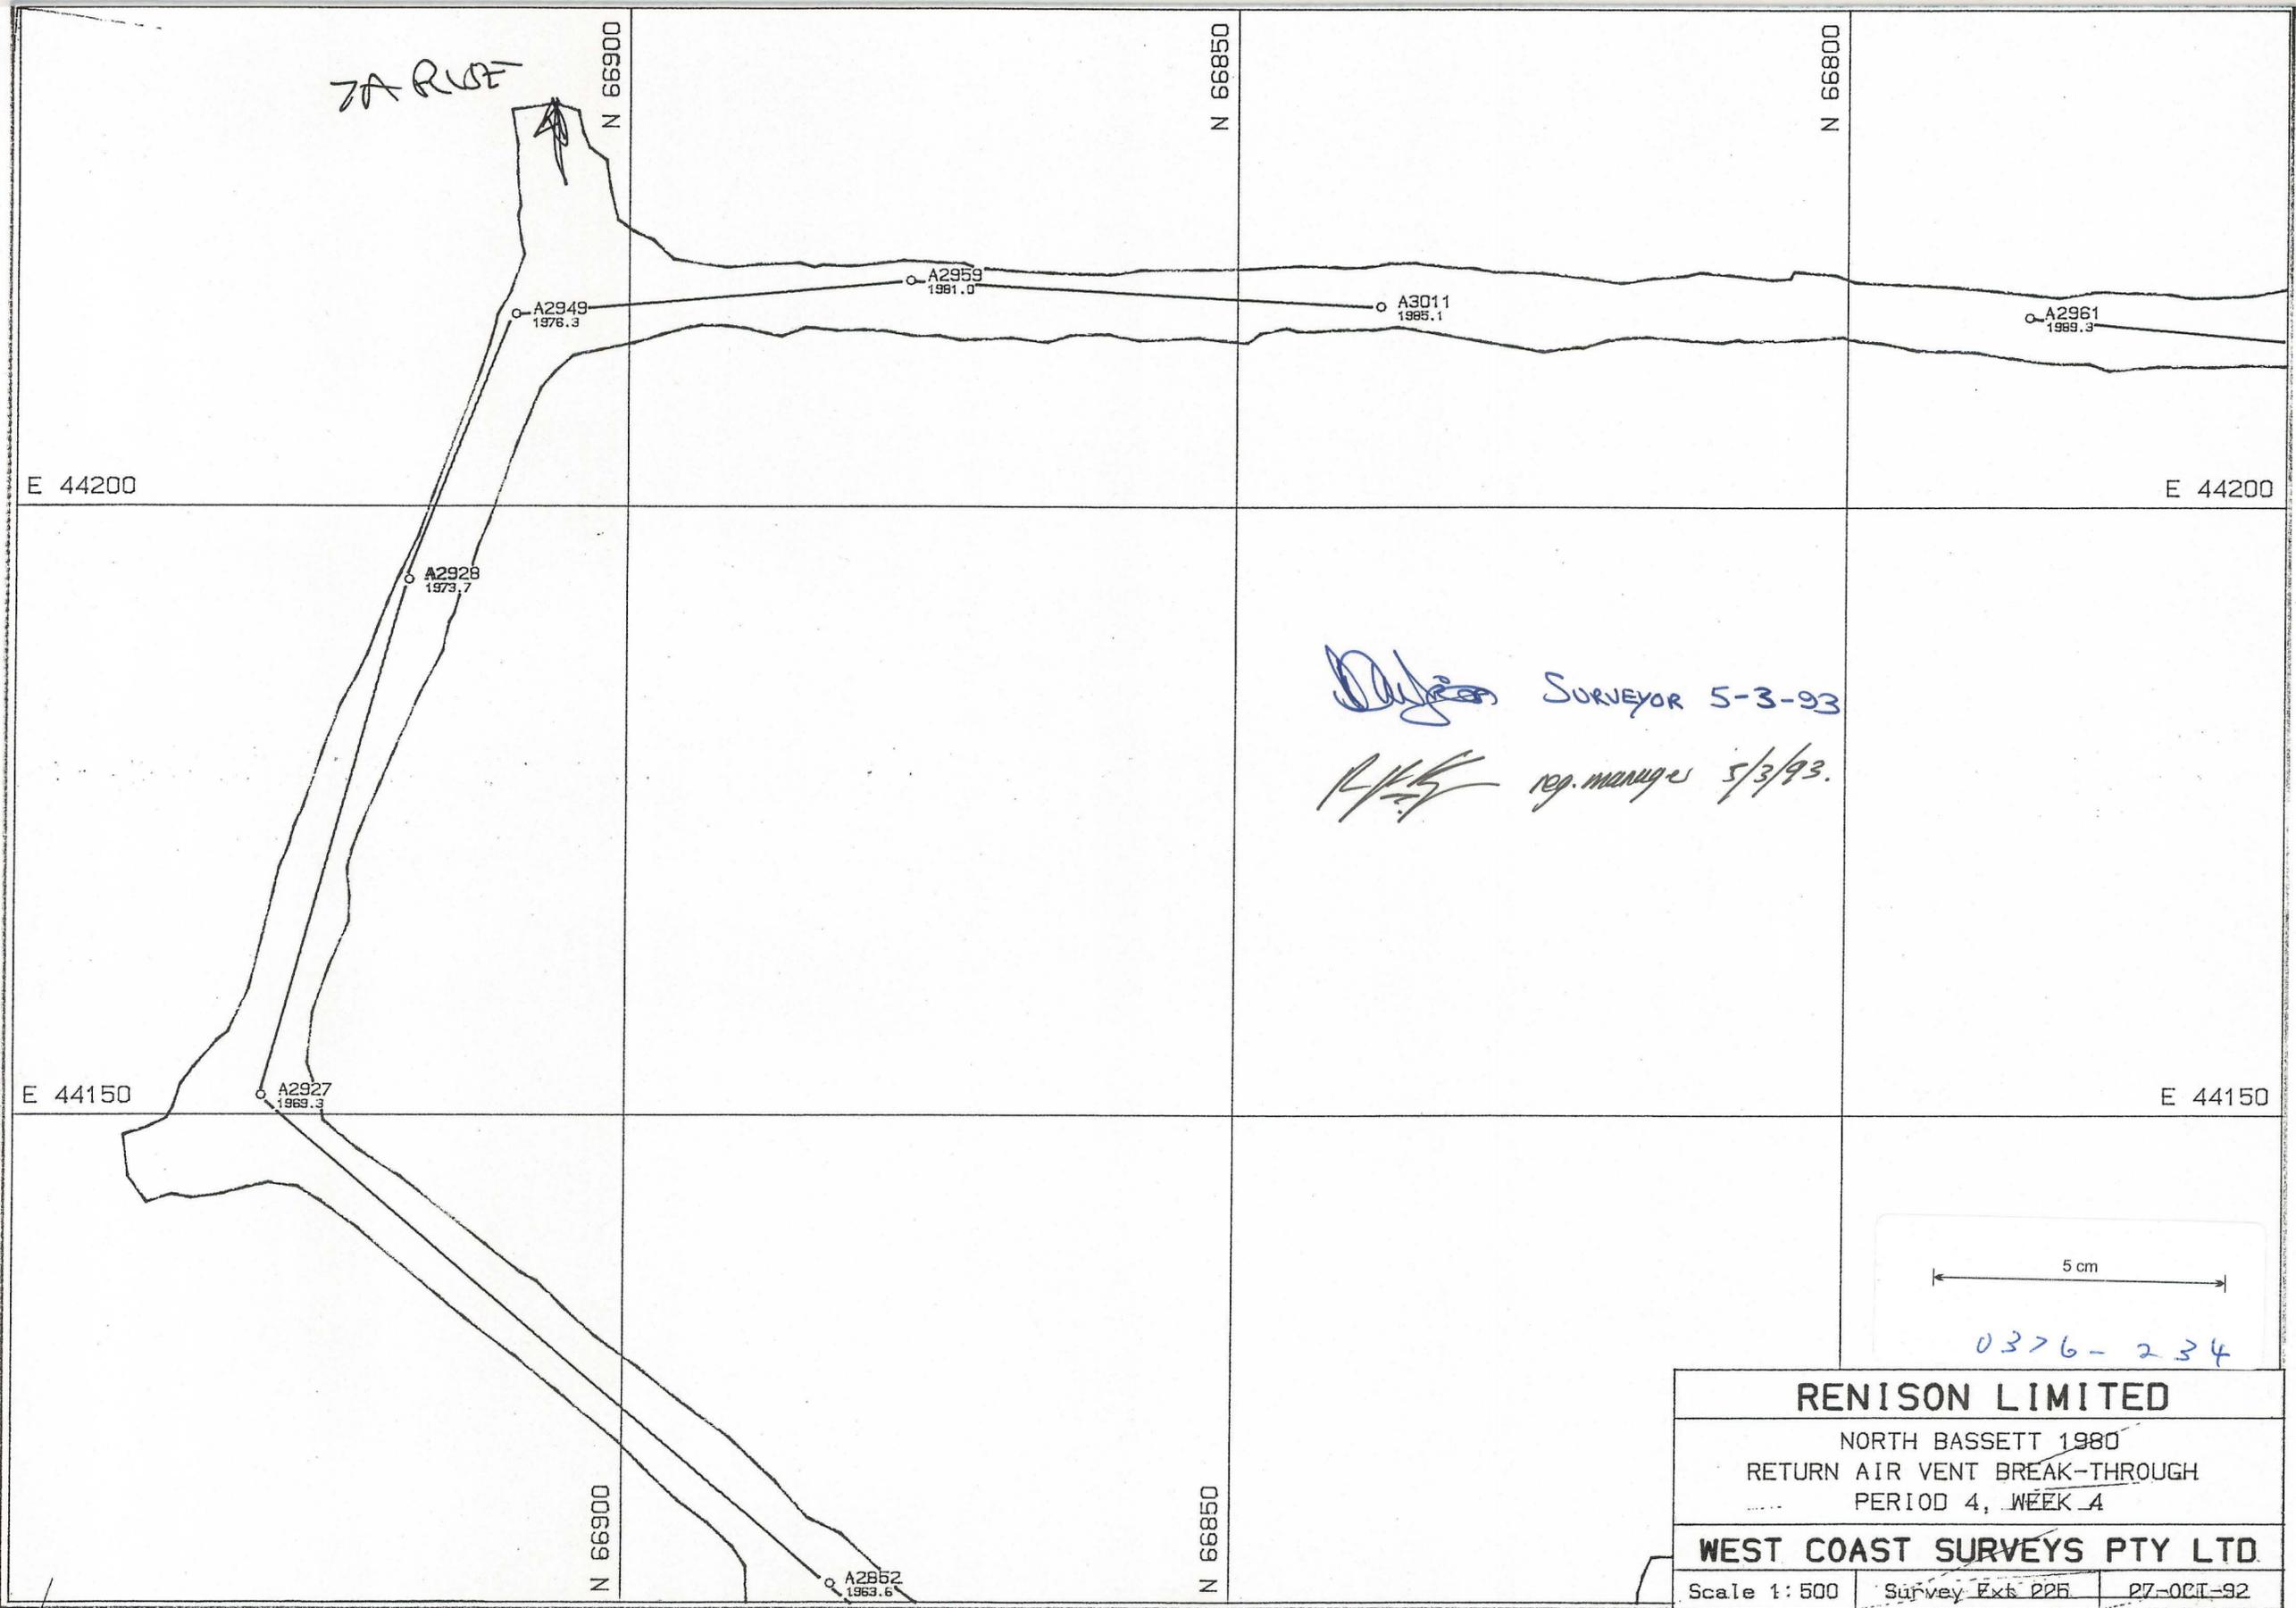

**RENISON LIMITED**  
 NORTH BASSETT 1980  
 RETURN AIR VENT BREAK-THROUGH  
 PERIOD 4, WEEK 4  
**WEST COAST SURVEYS PTY LTD**  
 Scale 1:500 | Survey Ext 225 | 27-001-92