


0376-235

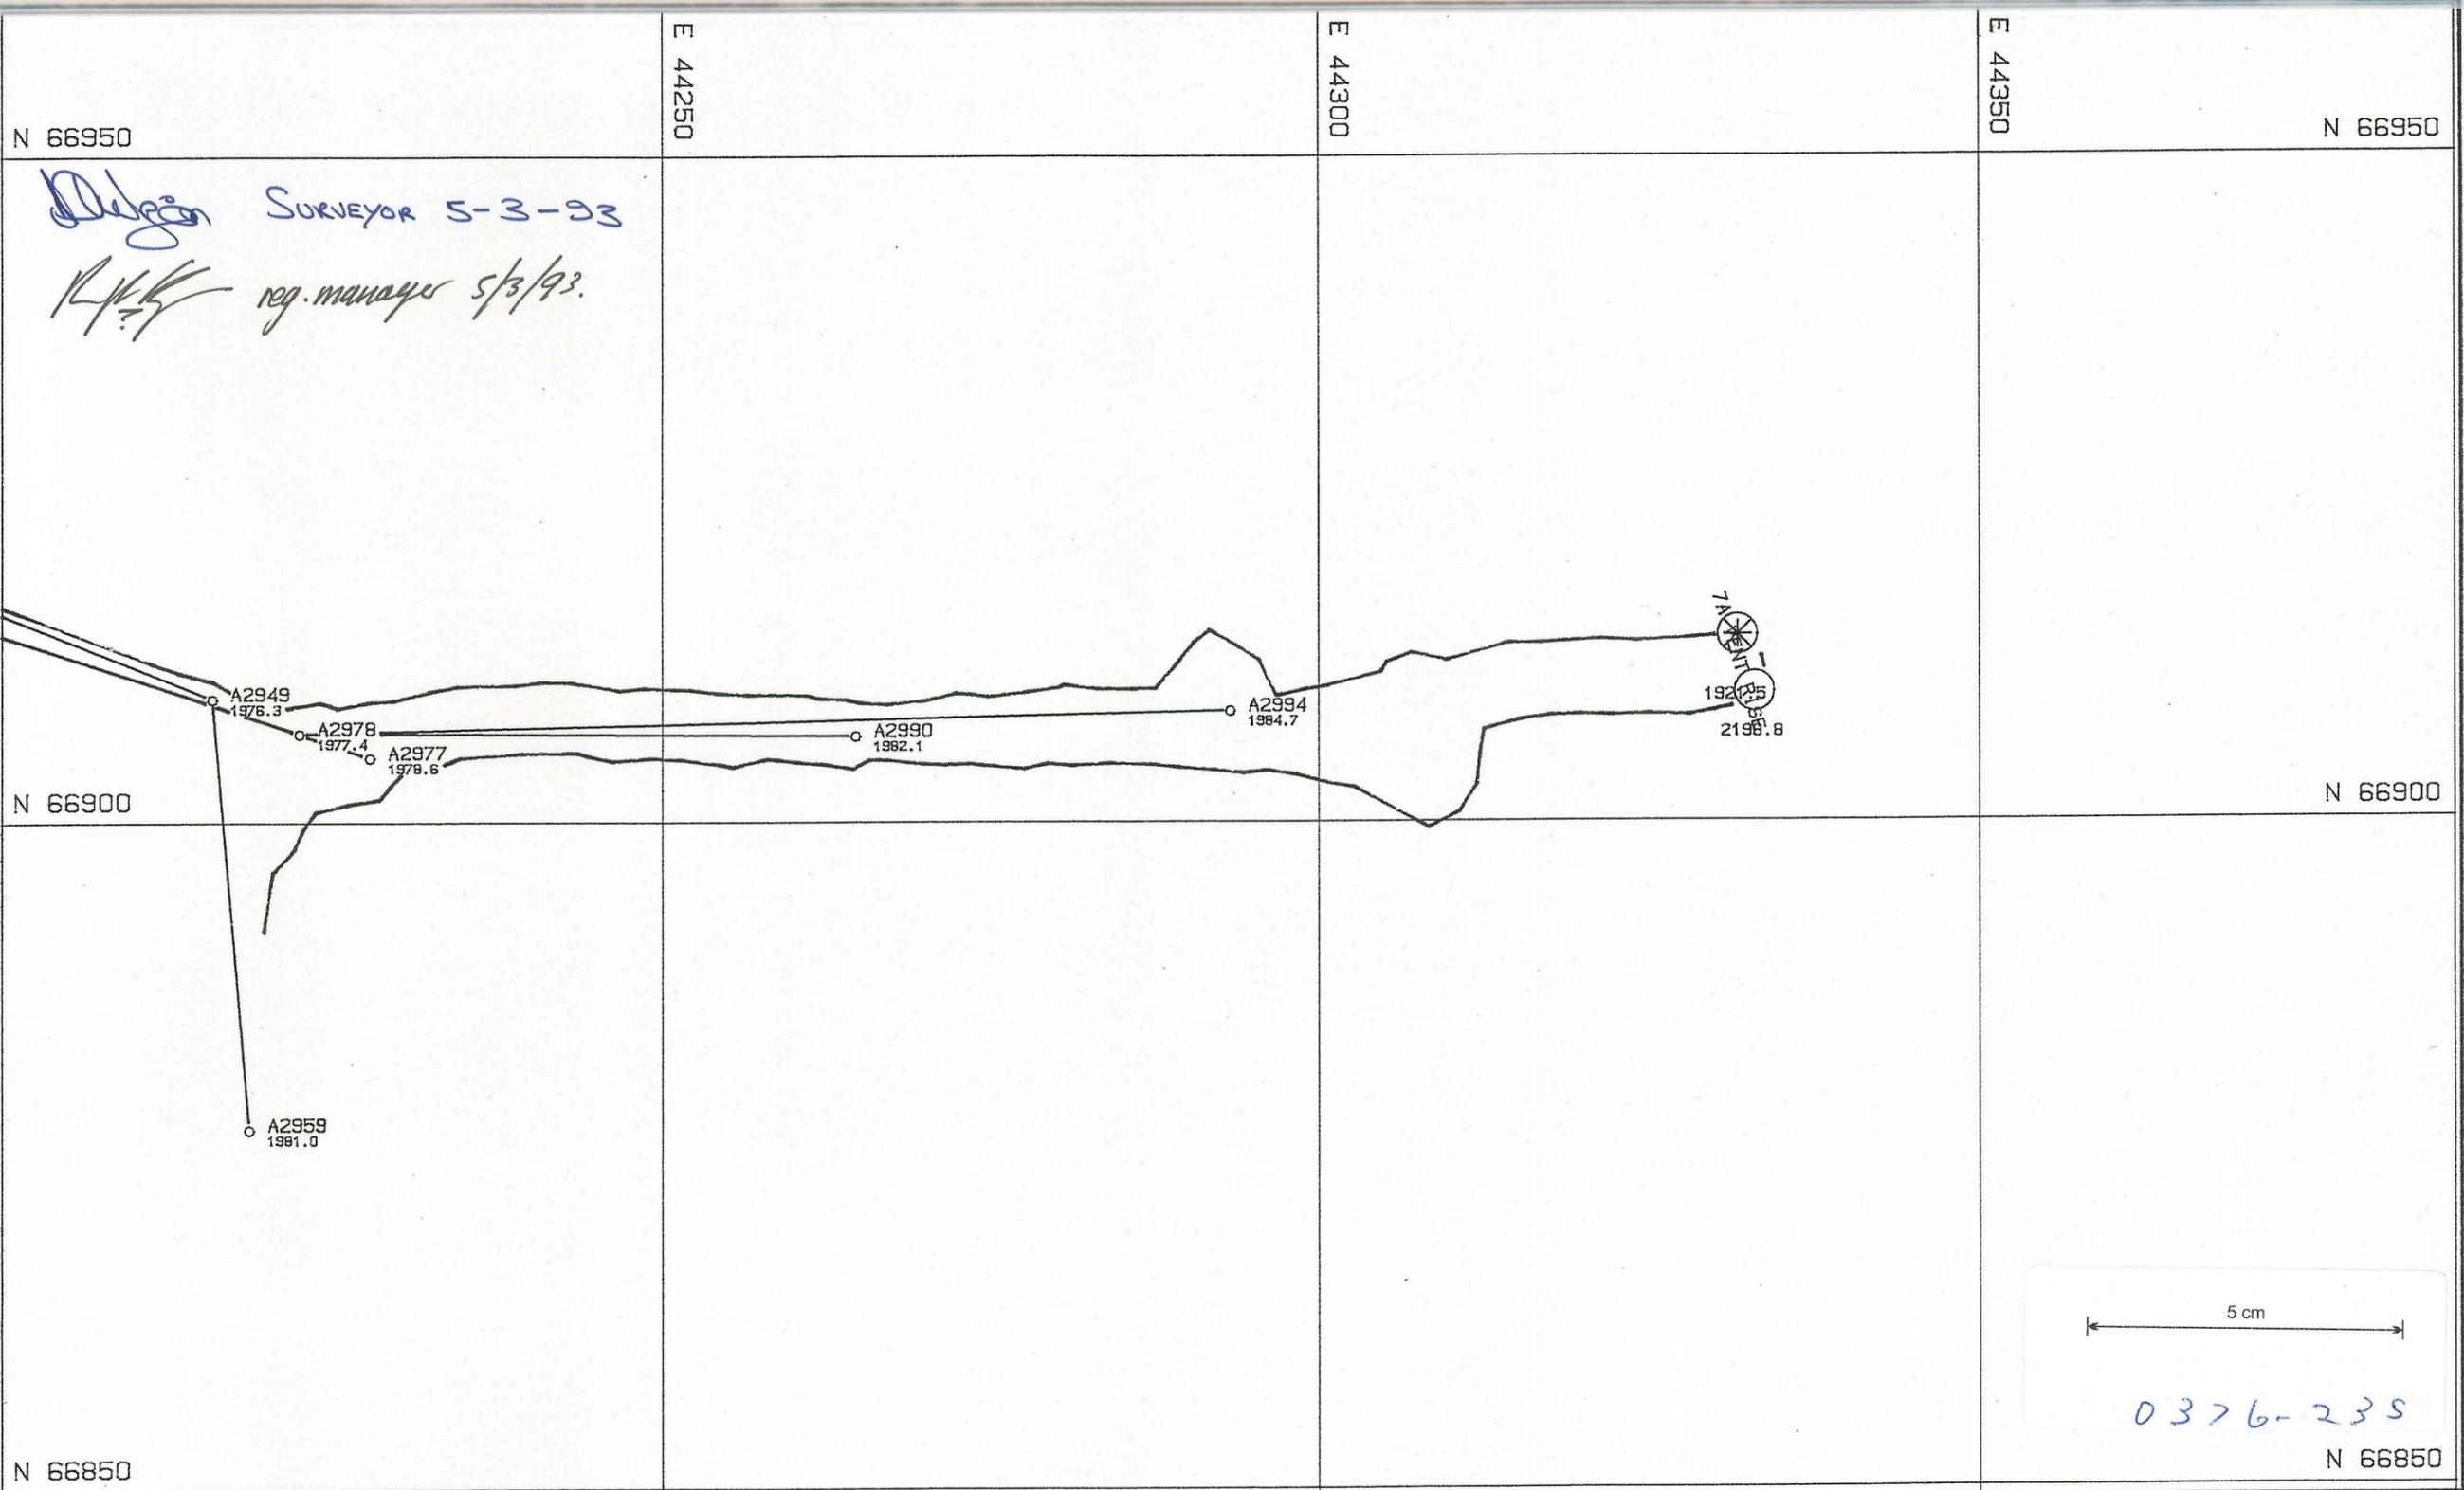

RENISON LIMITED		
7A X-CUT PERIOD 3 END COMPLETED		
WEST COAST SURVEYS PTY LTD		
Scale 1:500	Survey Ext. 225	1-OCT-92

7AXCUT.PF