


0376-236

Debra SURVEYOR 5-3-93
14/2/93 reg. manager 5/3/93

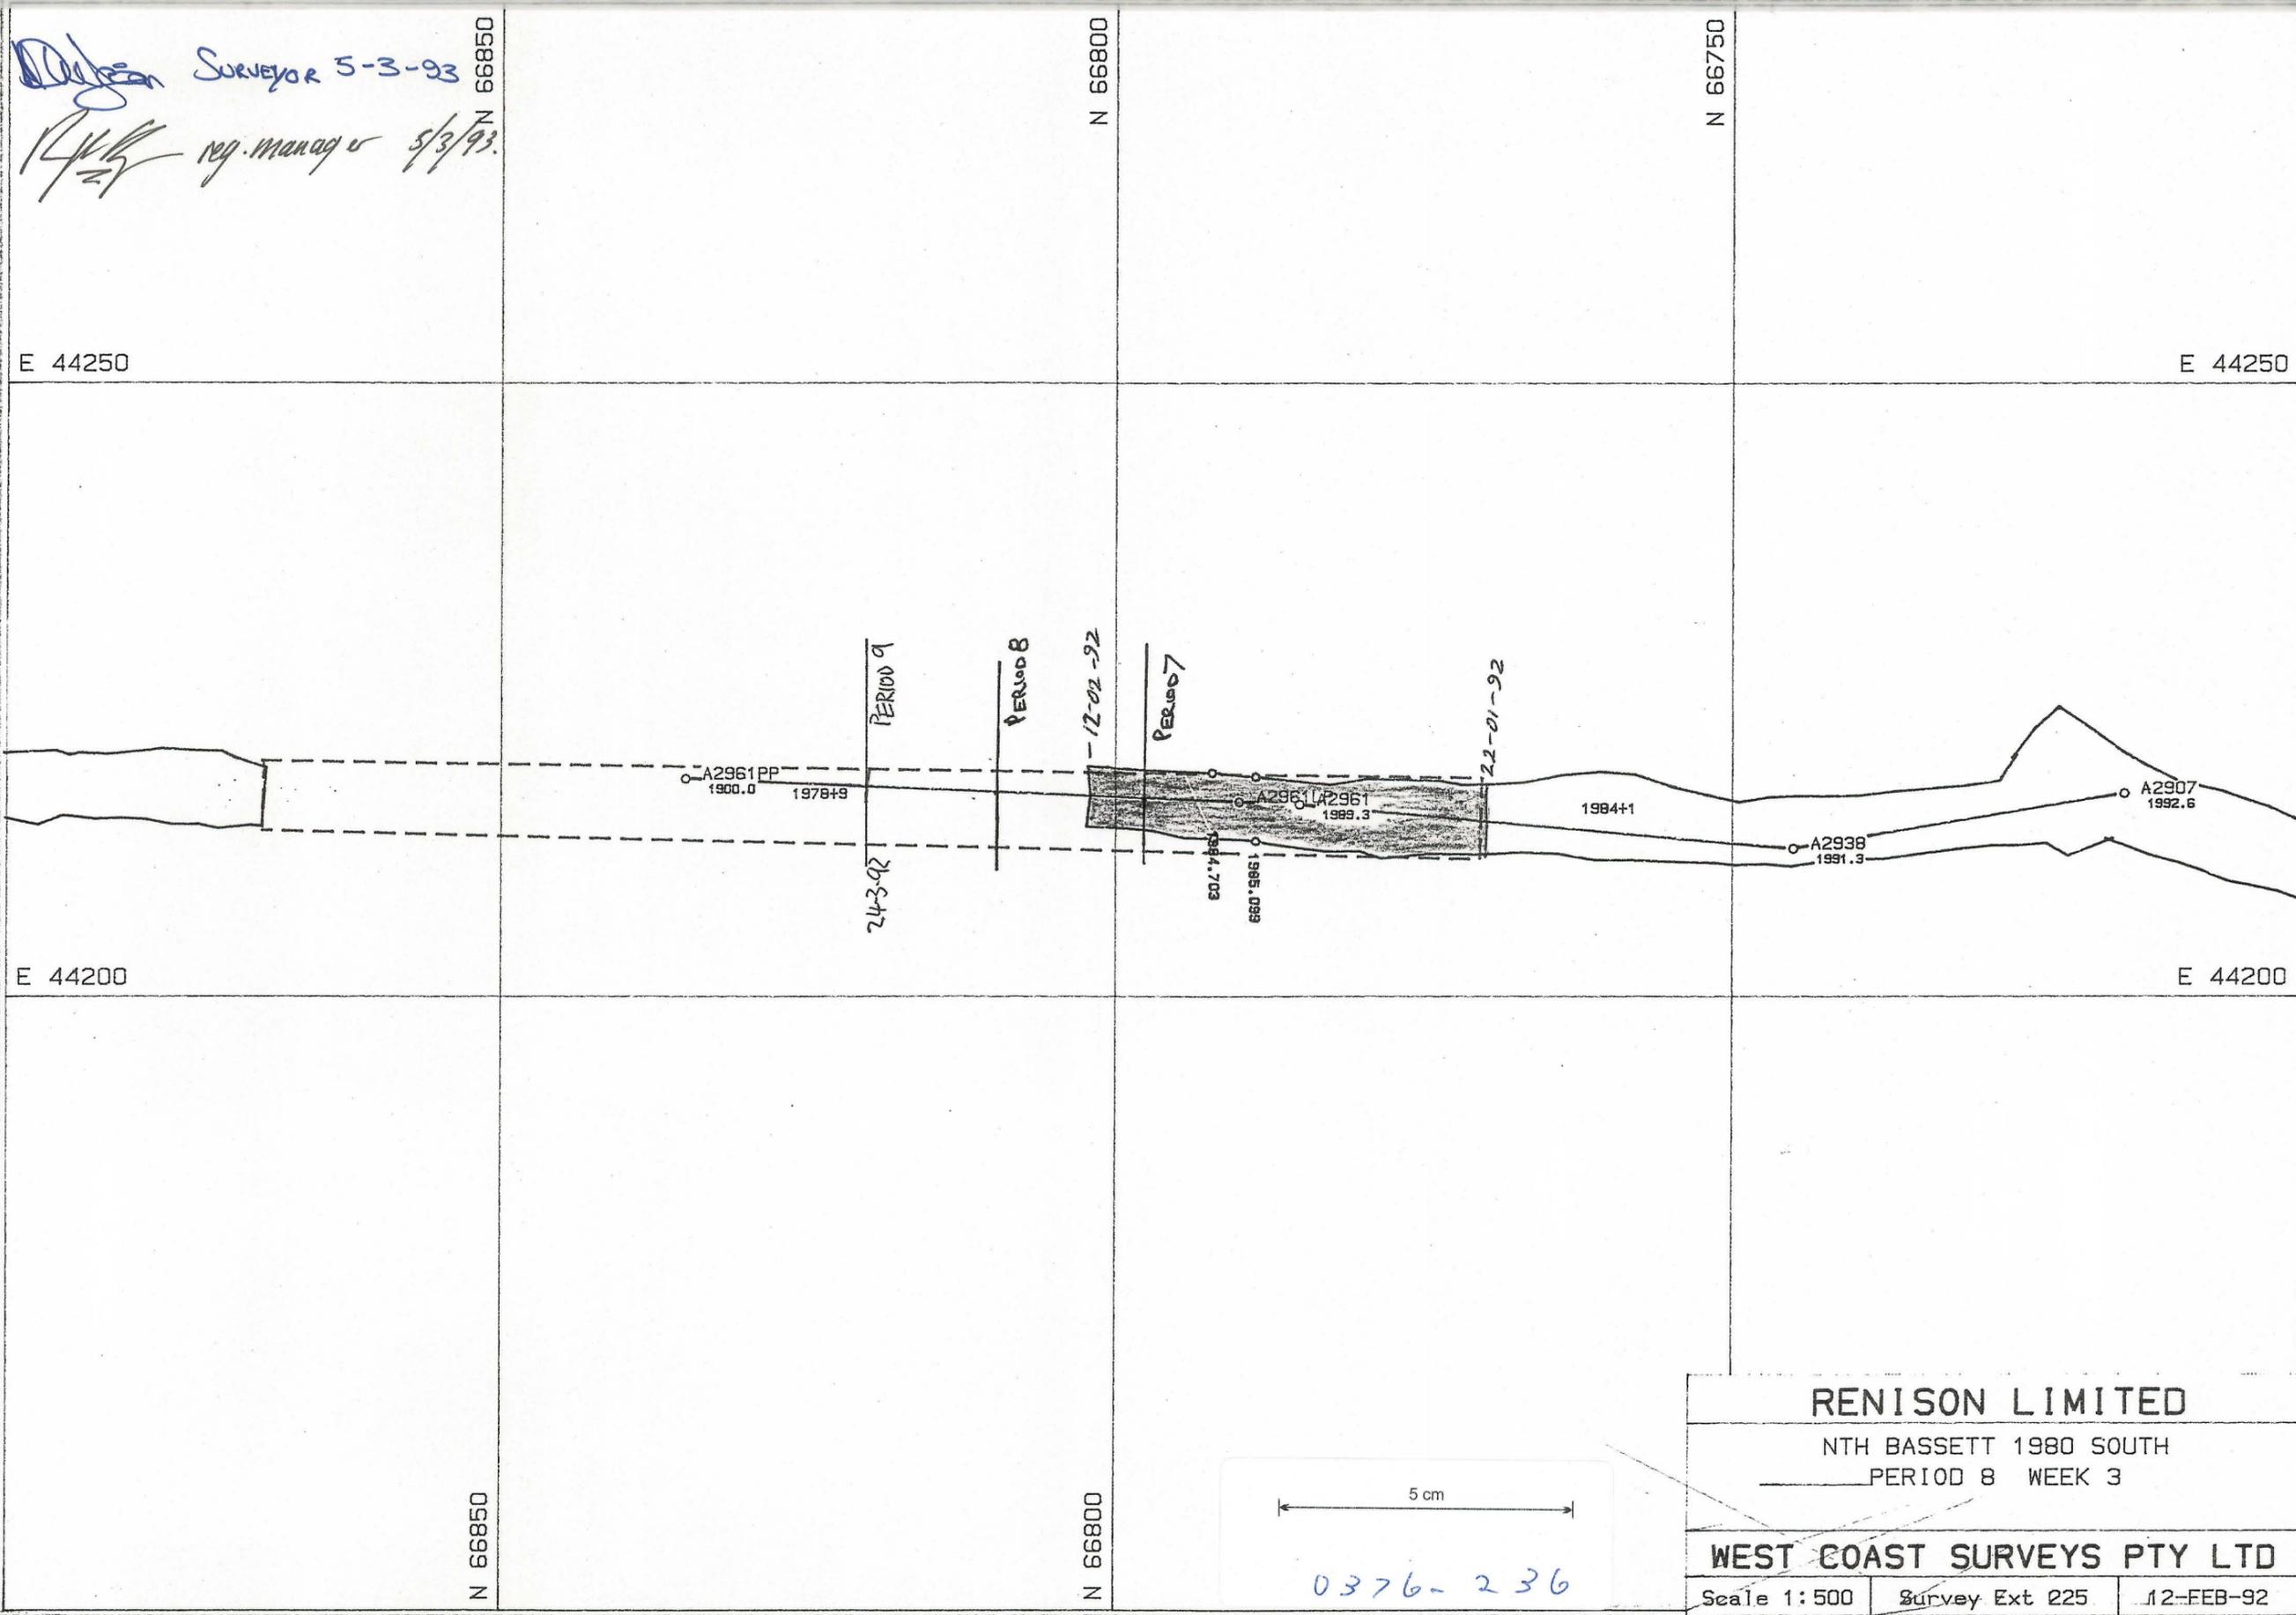

RENISON LIMITED
 NTH BASSETT 1980 SOUTH
 PERIOD 8 WEEK 3

WEST COAST SURVEYS PTY LTD
 Scale 1:500 Survey Ext 225 12-FEB-92

5 cm

0376-236