


0376-238

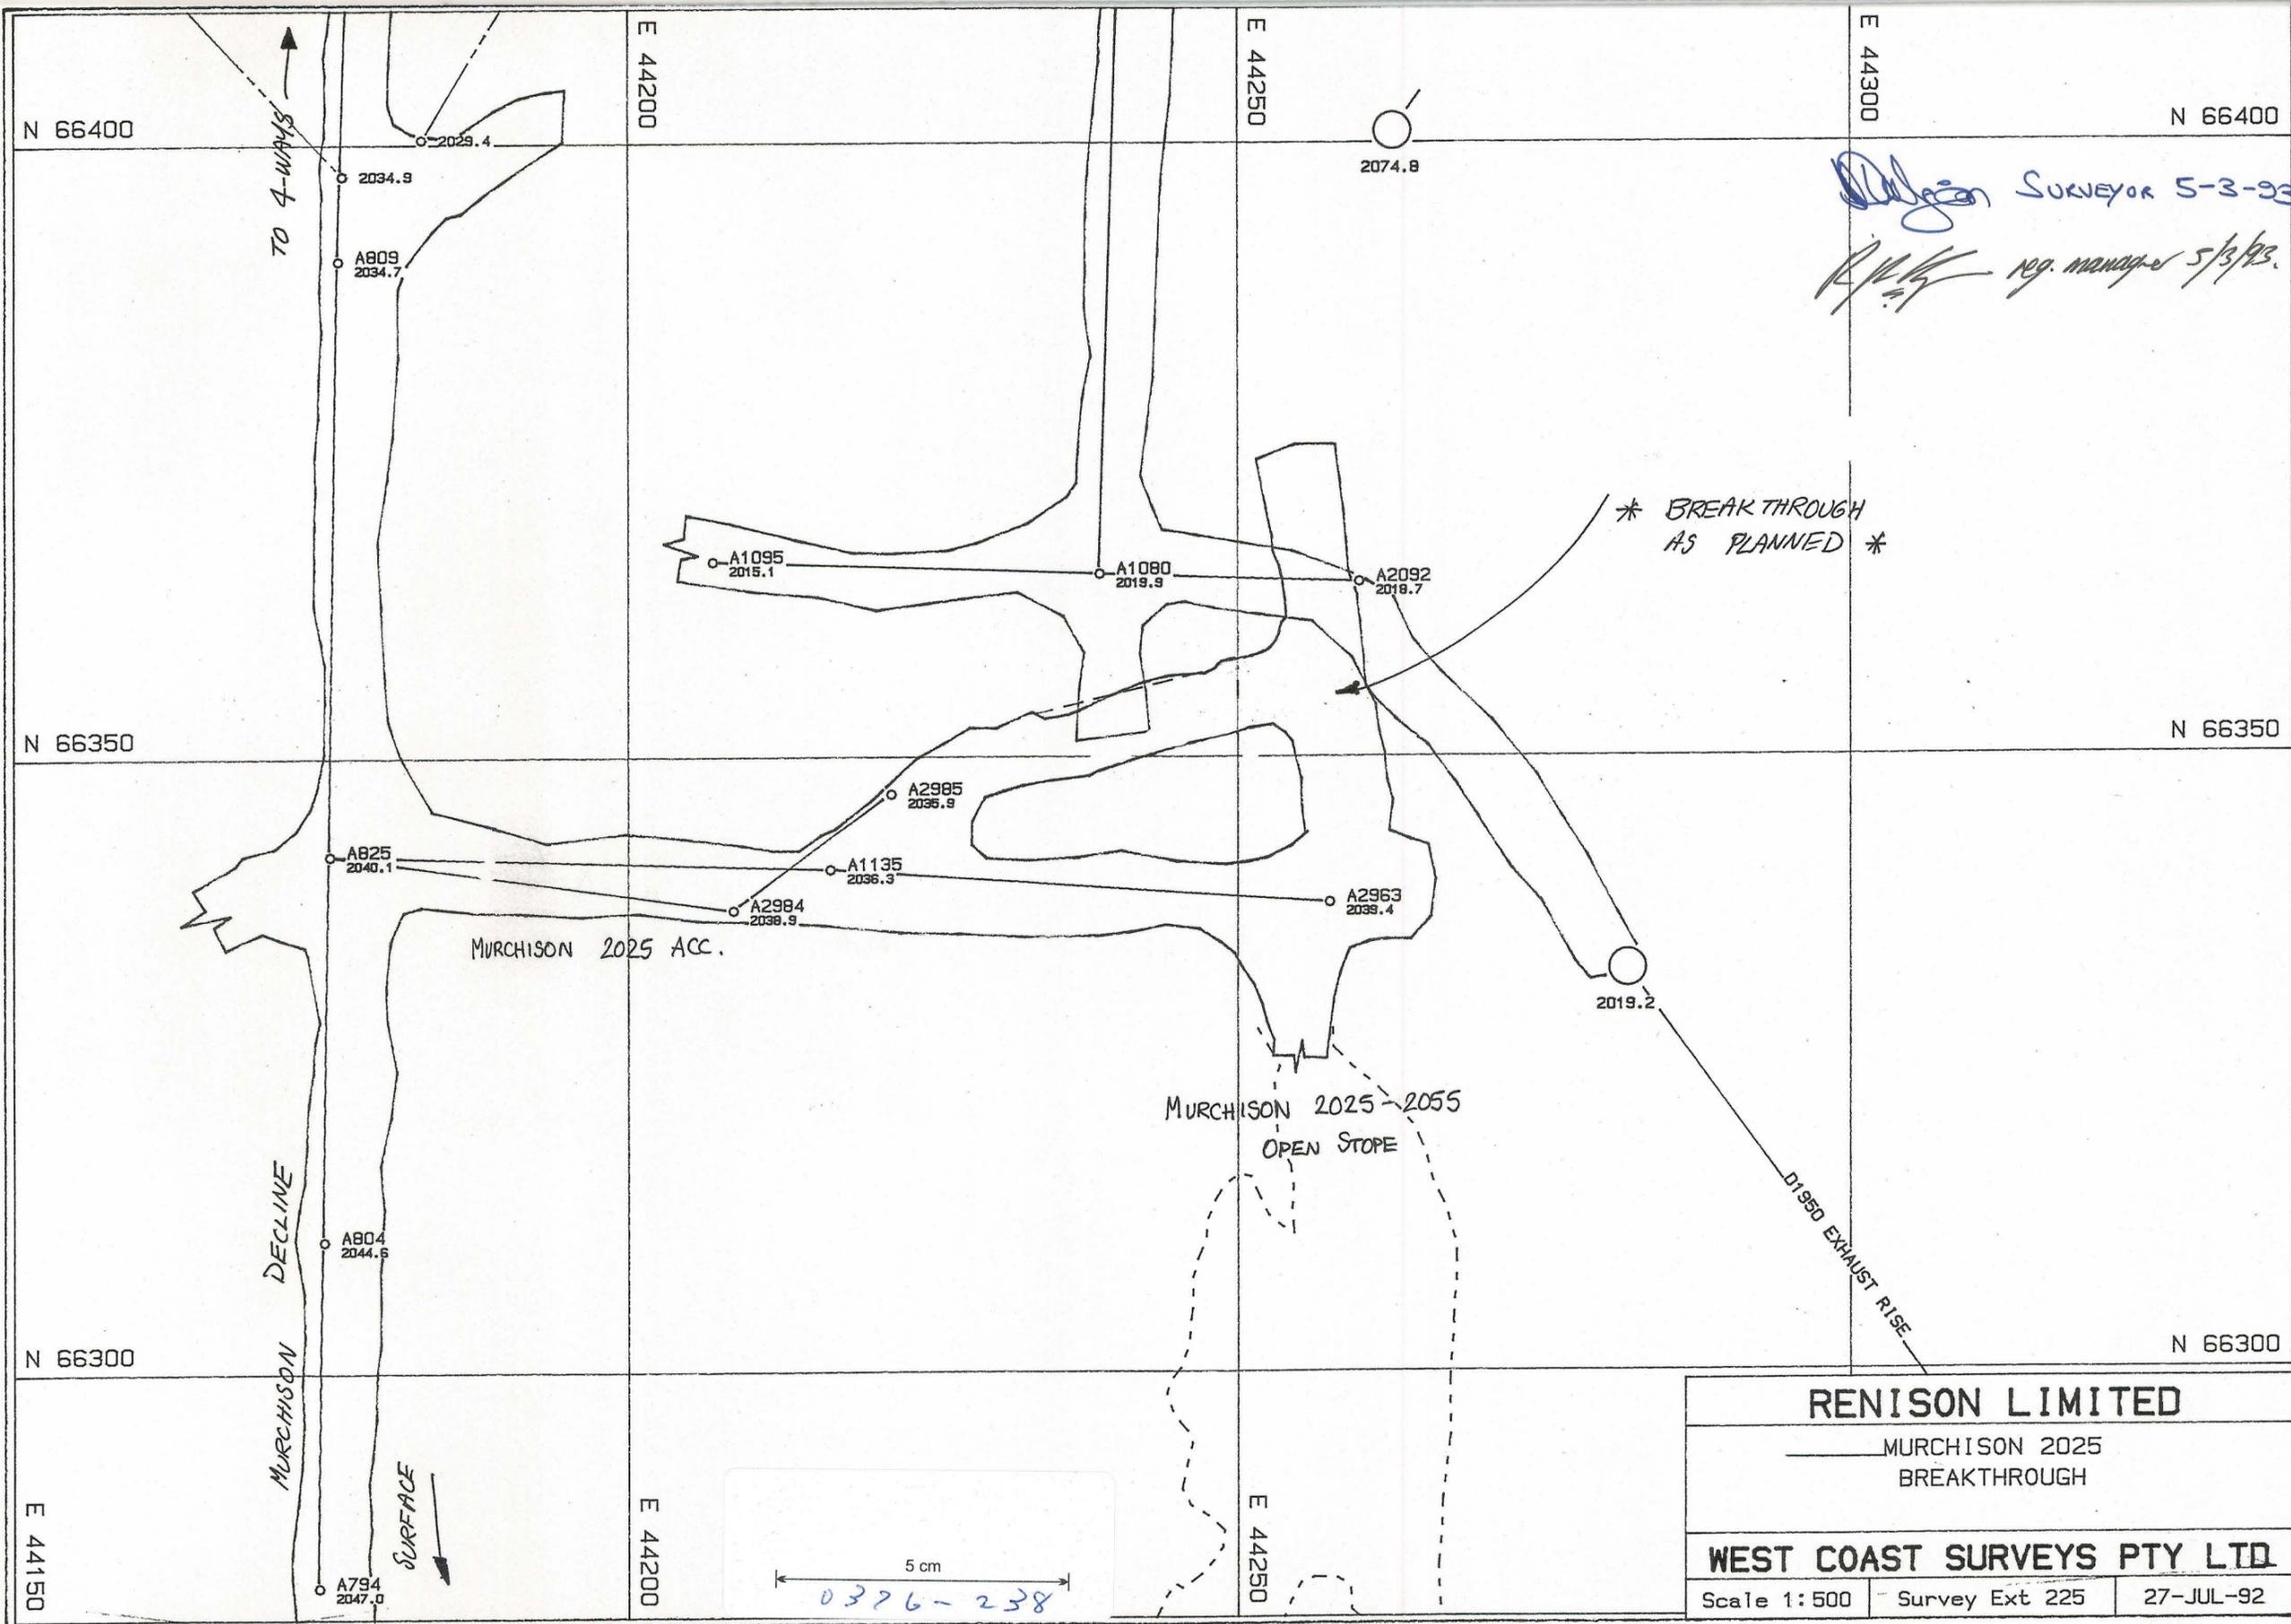

*Deegan* Surveyor 5-3-93  
*R. J. G.* reg. manager 5/3/93.

<b>RENISON LIMITED</b>		
— MURCHISON 2025 — BREAKTHROUGH		
<b>WEST COAST SURVEYS PTY LTD</b>		
Scale 1:500	Survey Ext 225	27-JUL-92

MURCHA.PF