


0376-239

Dalgen SURVEYOR 5-3-93
reg. manager 5/3/93.

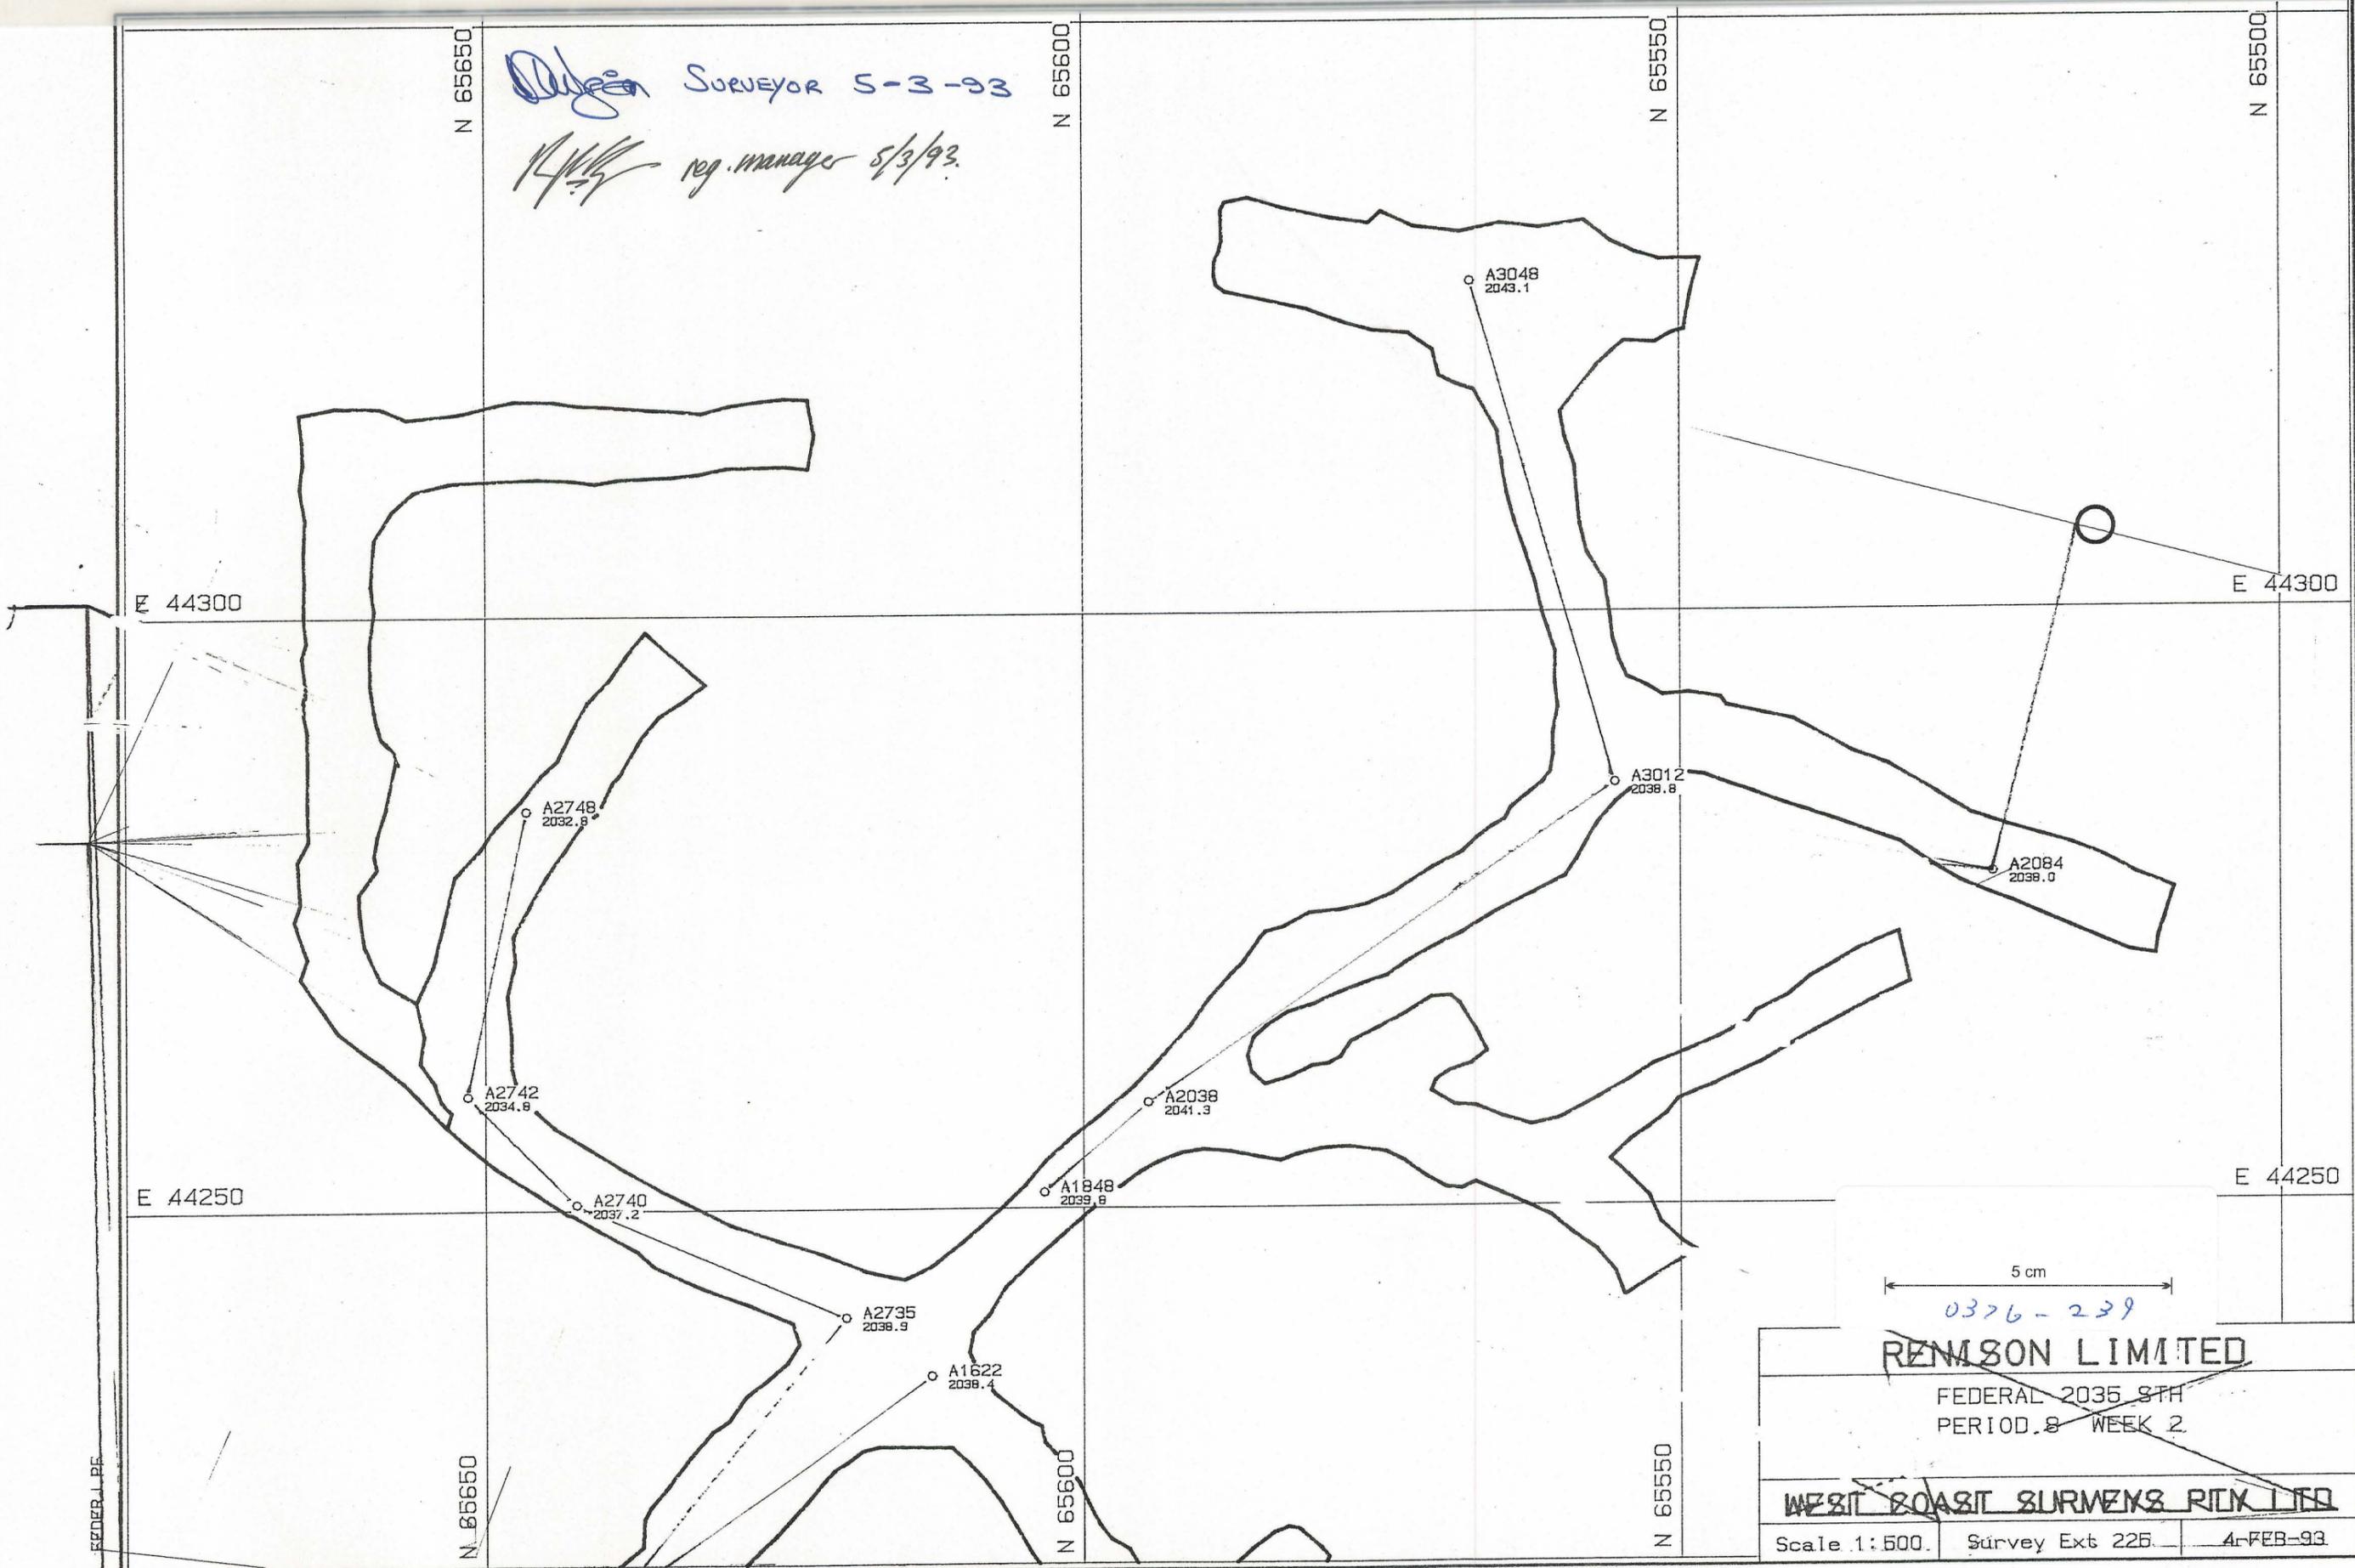

5 cm
0376-239

REMSON LIMITED

FEDERAL 2035 STH
PERIOD 8 WEEK 2

~~WEST COAST SURVEYS PTX LTD~~

Scale 1:500. Survey Ext 225. 4-FEB-93